


20-12-11  
22-1-12  
5-2-12

# LONGITUDINAL ARRANGEMENT SCALE 1:96

482'-4" OUTS 55' x 62'-5 1/2" x 32'-1" DEPTH MLD U.D.K.

 

Nº 326.






Profile & Deck

Flensburg no. 326.  
Sl. "Australia"

Ham. rept 1307Q

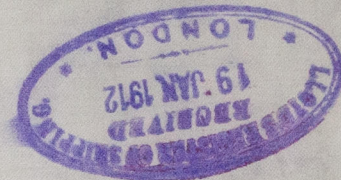

W497-0280



© 2019

Lloyd's Register  
Foundation



Longitudinal & Section  
No 326

W497-0280



© 2019

Lloyd's Register  
Foundation



Flensburg. No 326 **HAMBURG** Rpt. No 13042





Longitudinal & Deck plan

Hann letter 11/12/11

" " 17/1/12

1/2/12

9/5/12

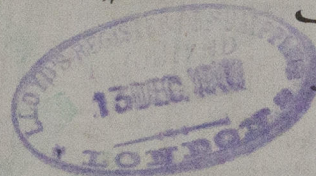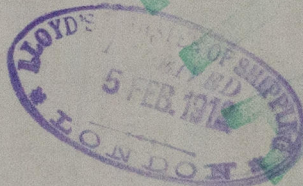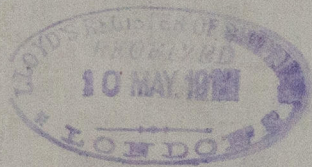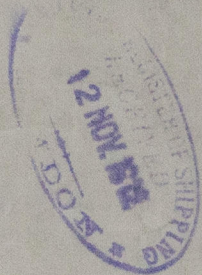

© 2019

Lloyd's Register  
Foundation