

4/3/29

DIMENSIONS.

LENGTH B.P.	380' 0"
BREADTH MLD.	51' 8 1/2"
DEPTH MLD. TO MAIN DK.	27' 8"
BRIDGE "	35' 8"





**S.S. N° 225-227.
PROFILE**

SCALE 1/8" = 1 FT.

PLAN OF HATCHWAYS TO BE
SUBMITTED

$L \times D = 10511$
 $L \times (B+D) = 30162$

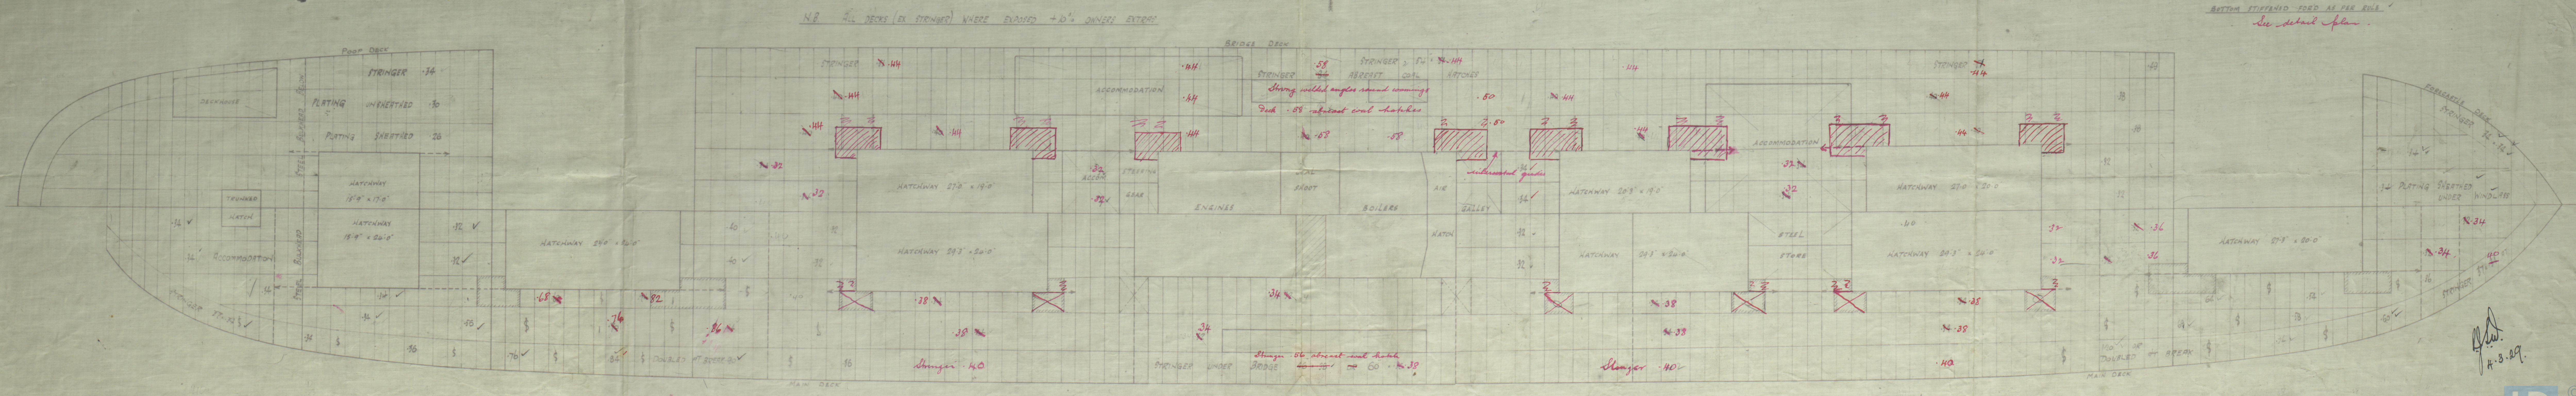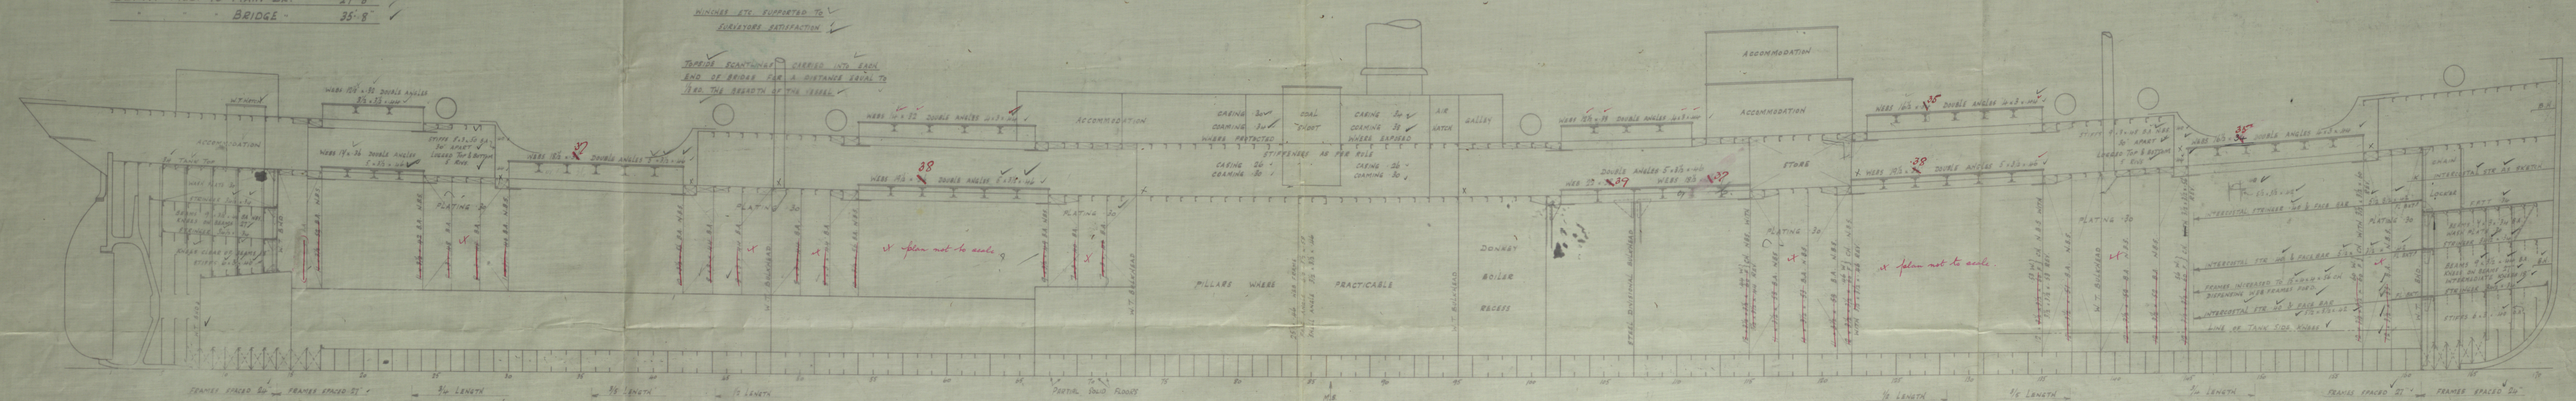

Handwritten signature and date: 4.3.29.

Messrs Craig Taylor & Co
No. 225. & 227.
Profile & Decks.

RETAIN

S.S. Portfield.
MDB. RPT. No. 15837

S.S. Portregis
MDB. RPT. No. 13971

RETAIN



© 2019

Lloyd's Register
Foundation

W498-0207