


21-8-01
 9-9-01
 24-4-01
 2-10-01

LONGITUDINAL SECTION
 S.S.N° 136
 SEATE 1/4 1901
 CLASS 100-A1-AT LLOYDS

DIMENSIONS

LENGTH BETWEEN PERP --- 153'-0"
 BREADTH MOULDED --- 25'-0"
 DEPTH --- 12'-2"


BEHIND END OF HATCHES

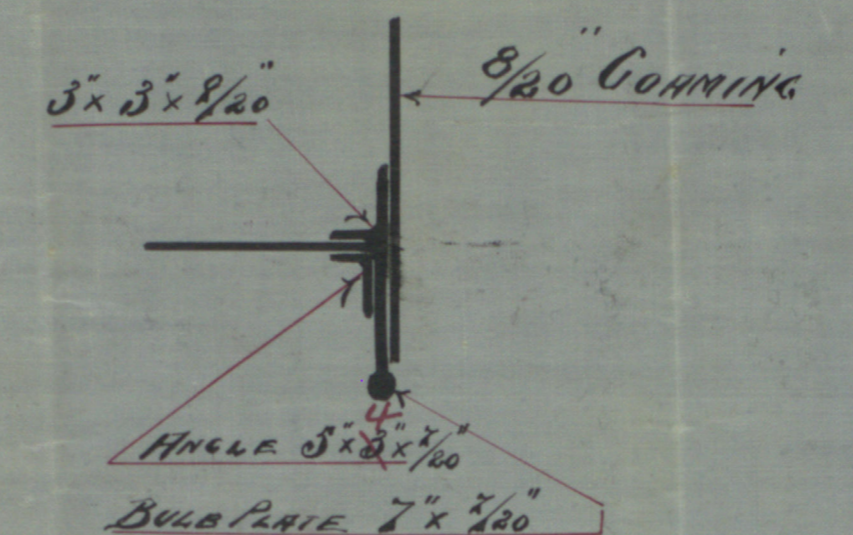

22.12.01

PROFILE

PROFILE

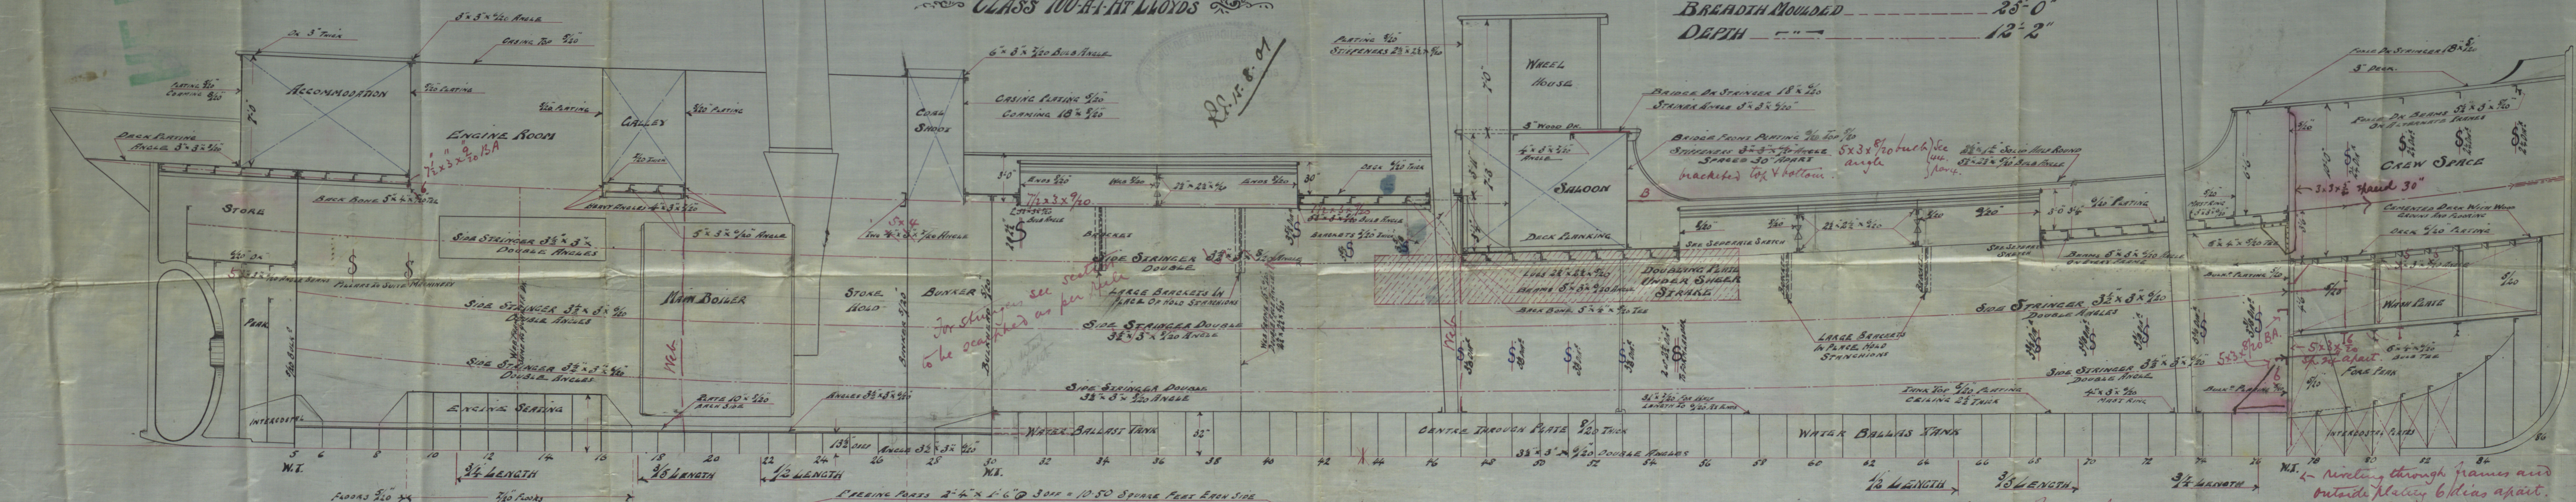


RAISED QUARTER DECK


SALOON DECK

MAIN DECK

CREW SPACE

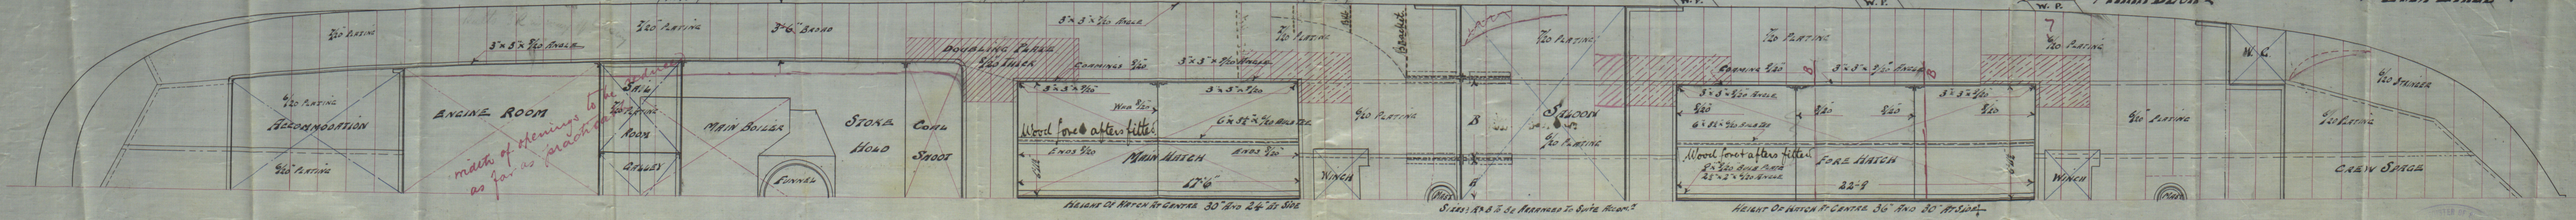

21/8/01
 21/8/01

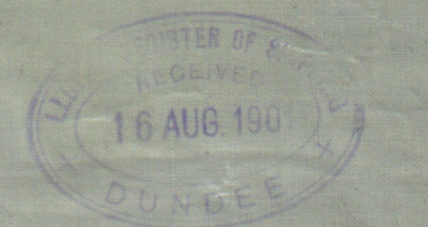

Profile & Deck plan
for




The Dundee S.B. Co

No 136.

S.S. "Abercraig"

Dundee Rpt No 6820.

Abercraig

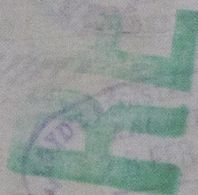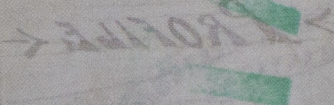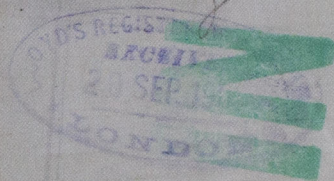

© 2019

Lloyd's Register

W448-0316