



22.10.35.

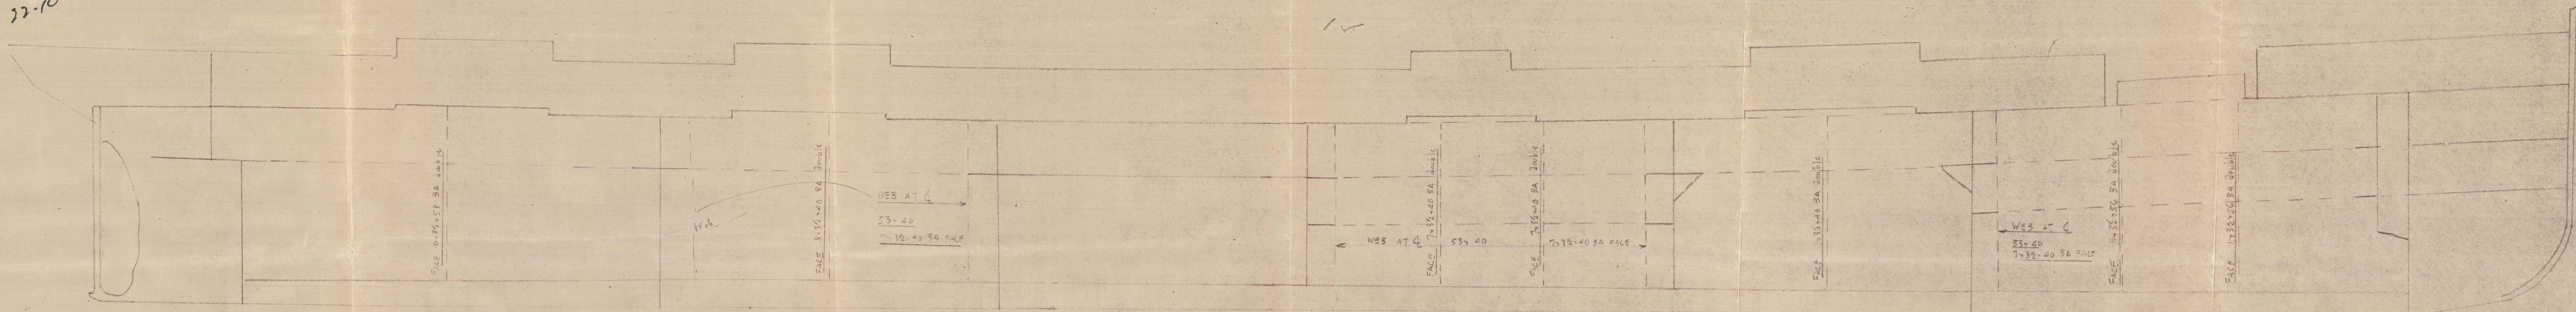

SS. PETRAKIS NOMIKOS


REINFORCEMENT REQUIRED ON ACCOUNT OF REMOVAL
OF 2ND AND 3RD DECK

PILLARS TO BE FITTED TO
U D^N IN ACCORDANCE
WITH RULES TALKING

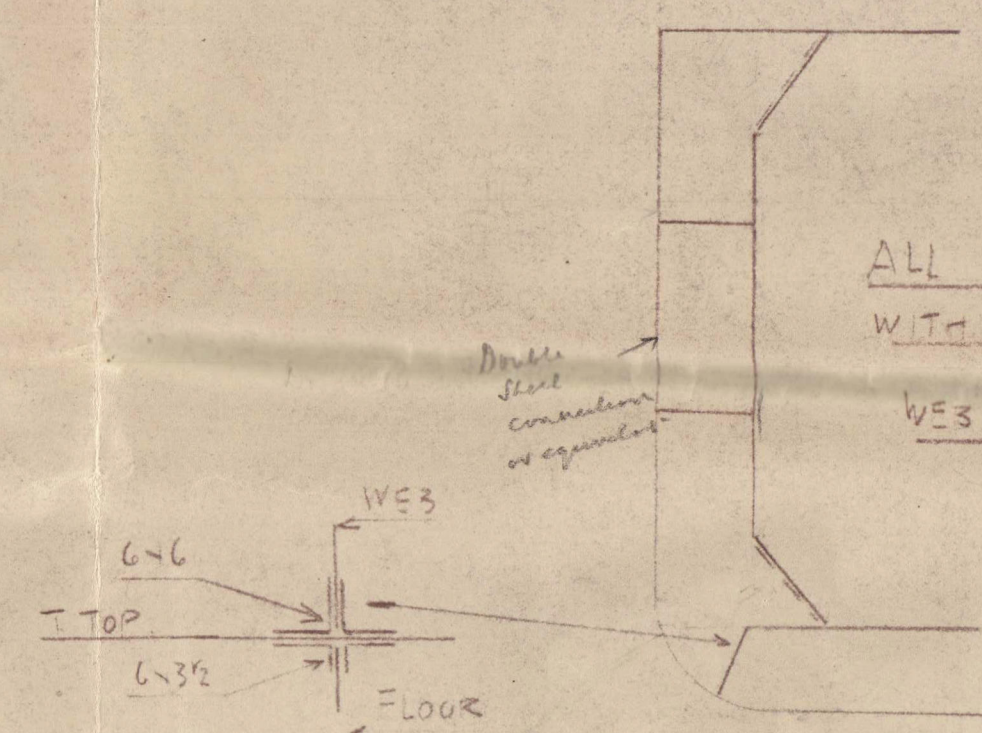


ALL WEBS 48" x 46
WITH FACE ANGLES AS SHOWN ON PROFILE
WEBS TO BE CONTINUOUS

UPPER DECK N WELL

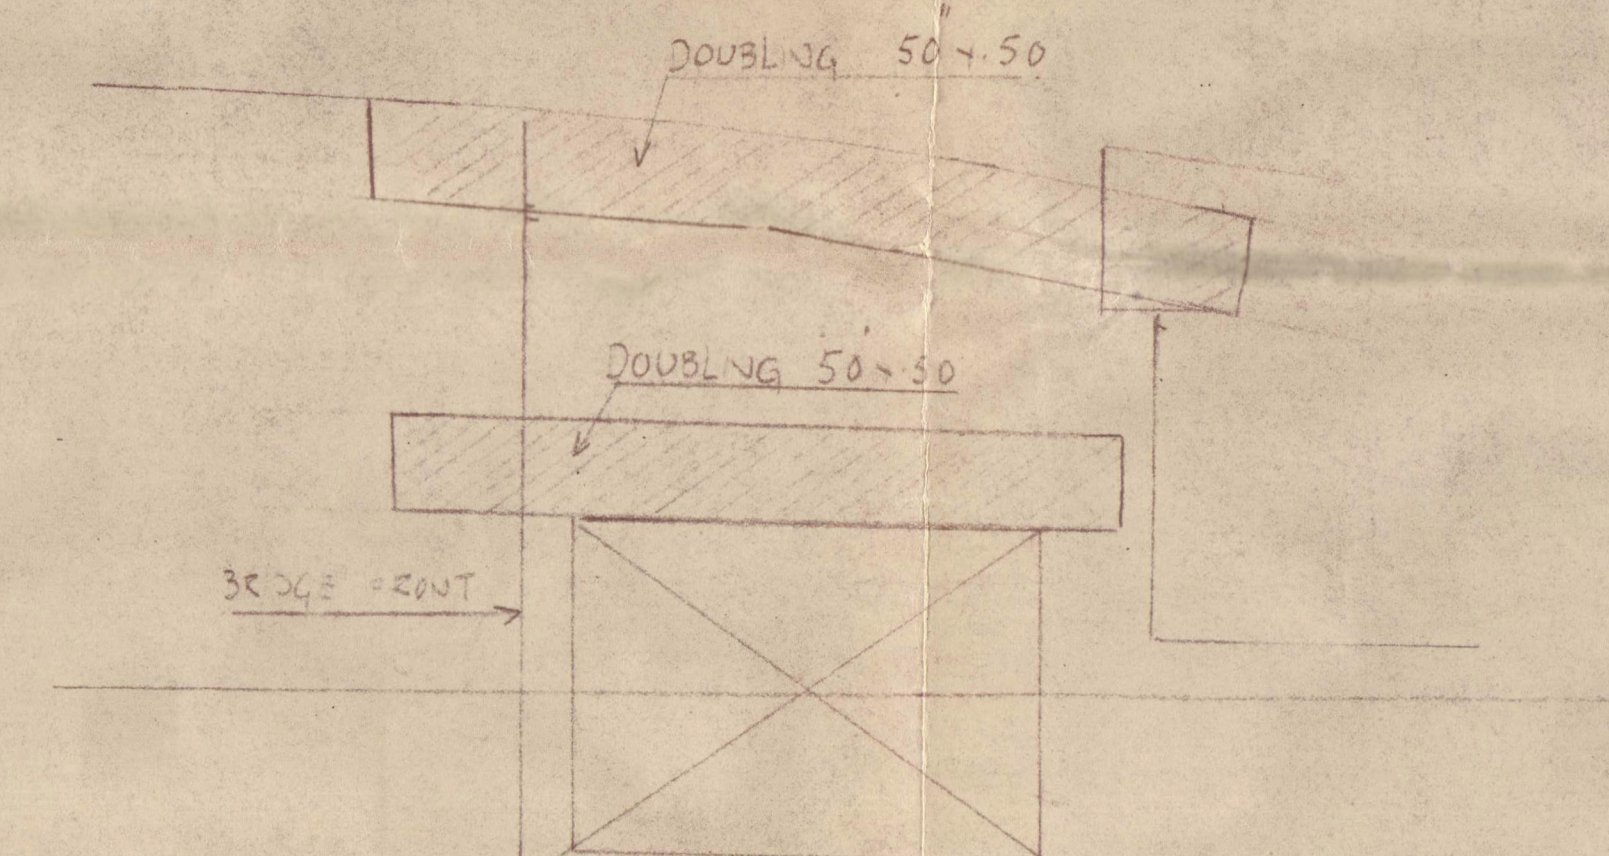

PLAN AT 2ND D^K
STRENGTH 48" BROAD

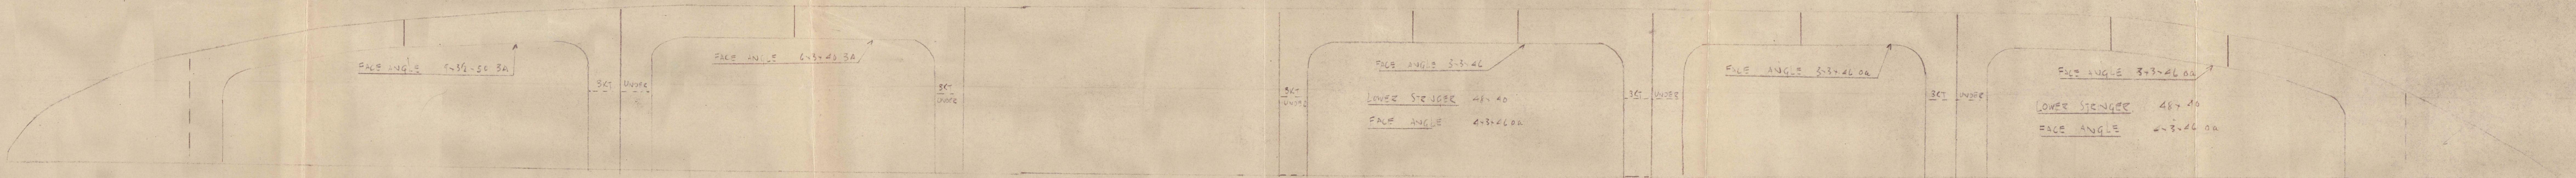

22.10.35.

s/s. Petrakis Nomikos

Additional stiffening required
for removal of 2nd & 3rd decks
on holds

(See correspondence
attached to Piraeus
report No. 4124.)

RETURN

W492-0020

