

HA 1150
arrange to provide about
10' clearance
above a 10' high
structure at rear end of
hull structure and


SS PETRAKIS NOMIKOS

REINFORCEMENT REQUIRED ON ACCOUNT OF REMOVAL
OF 2ND AND 3RD DECK

8' 0" stringer


BELVIN

PILLARS TO BE FITTED TO
U D^K IN ACCORDANCE
WITH RULES

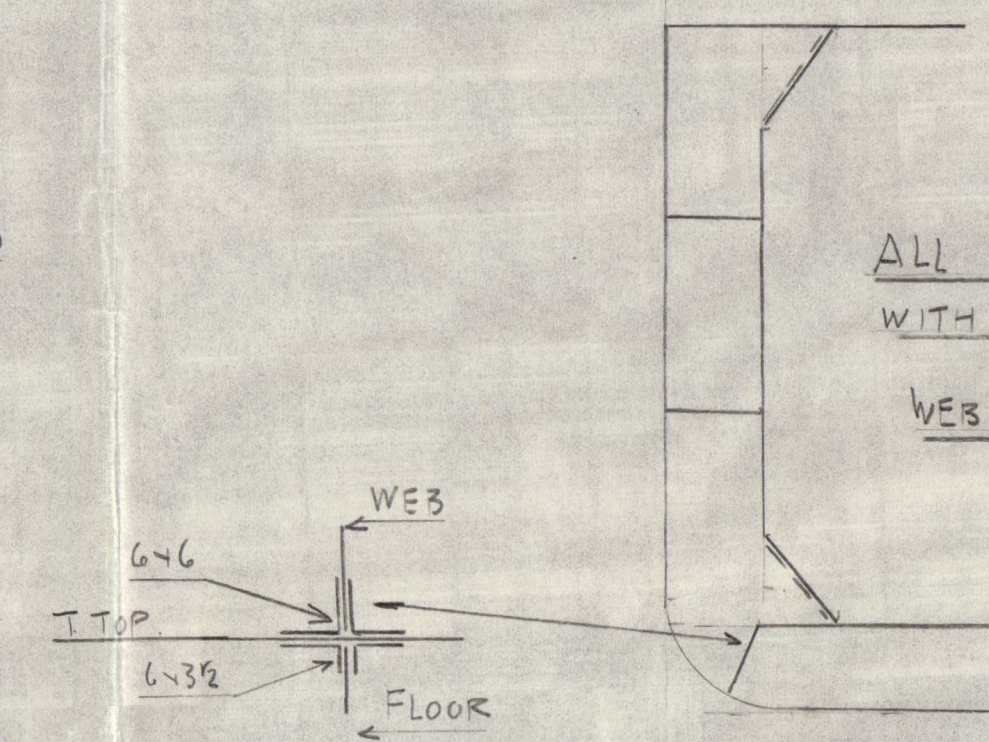

ALL WEBS 18" x 46
WITH FACE ANGLES AS SHOWN ON PROFILE
WEBS TO BE CONTINUOUS


UPPER DECK IN WELL

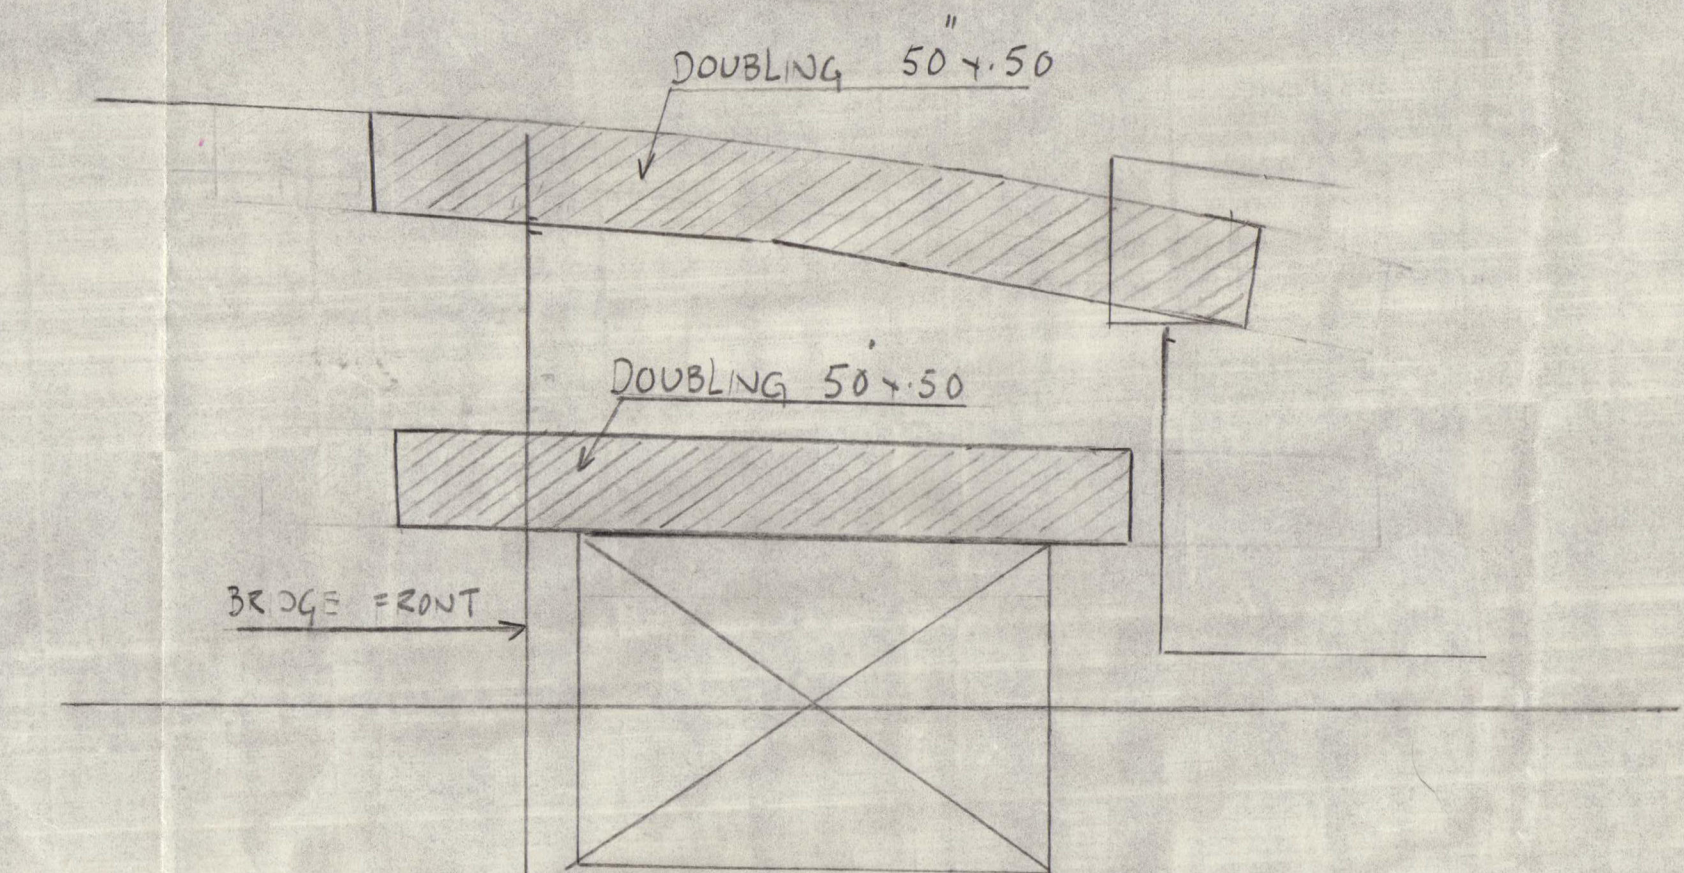

PLAN AT 2ND D^K

STRINGER 48" BROAD

LARGE BKTS FITTED TO STRINGER WHERE MARKED 'B'

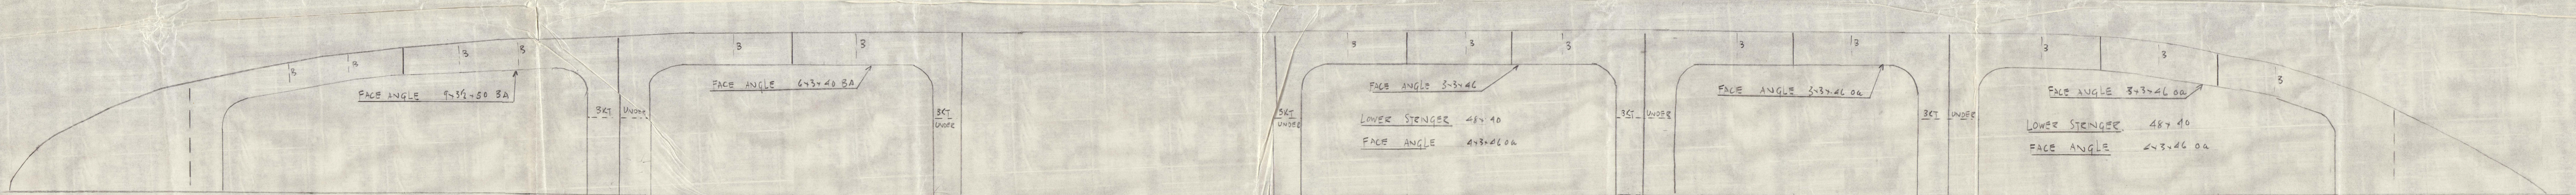

RETAIN

S.S. Putrakis ~~Putrakis~~

~~Putrakis~~

Reinforcement required on
account of removal of
second & third decks.

(See correspondence
attached to Piraeus report
No. 4124)

W492-0021



© 2021

Lloyd's Register
Foundation