
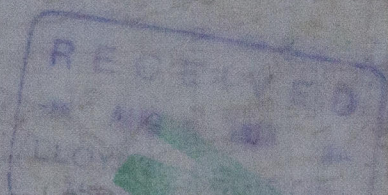


Sir Raylton Dixon & Co
S. S. No 583.

Amended Midskip Section

Mdb. Rpt 8063
S.S. "Valegarth"

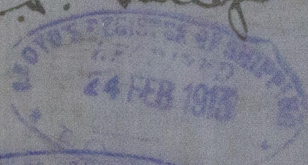

RETRACTED

WUGA 0312



© 2021

Lloyd's Register
Foundation