
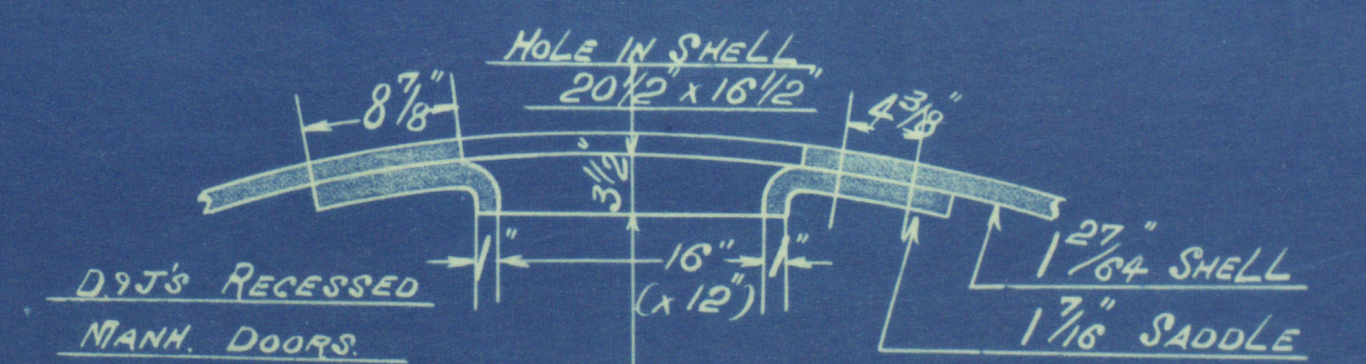


547.

[illegible]

FOR 2 BOILERS	
HEATING SURFACE	7920 \$
GRATE SURFACE	230 "

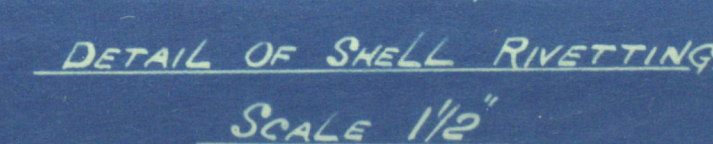

SCALE :- 1" = ONE FOOT



J.C. 26/1/23
C.A.C. 29/1/23
J.B. 30/1/23

Dunsmuir &
Jackson

Nº 547

two D.E. bls

W.P. 215 lbs.

approved 6.2.23

Start: 13th
mark on boiler

Nº 16379

Lloyds list

373 lbs

W.P. 215 "

J.S.C. 29-11-23

For boiler
mark on boiler

Nº 16387


Lloyds list

373 lbs

W.P. 215 "

J.S.C. 11-12-23

GLASGOW REPORT 2010 43766

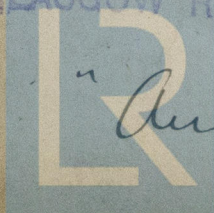

Auditor

Lloyd's Register
Foundation