


Supports under sundries number marks to be  
Surveyors Satisfaction.  
Plan of. Painting, arxt. and strengthening of bottom  
and to be submitted



To CLASS 100 A.I. [WITH FREEBOARD] *corresponding to a C.S.S. vessel with tonnage opening.*

APPROVED  
LLOYDS REGISTER OF SHIPPING  
2001  
15. 8. 28

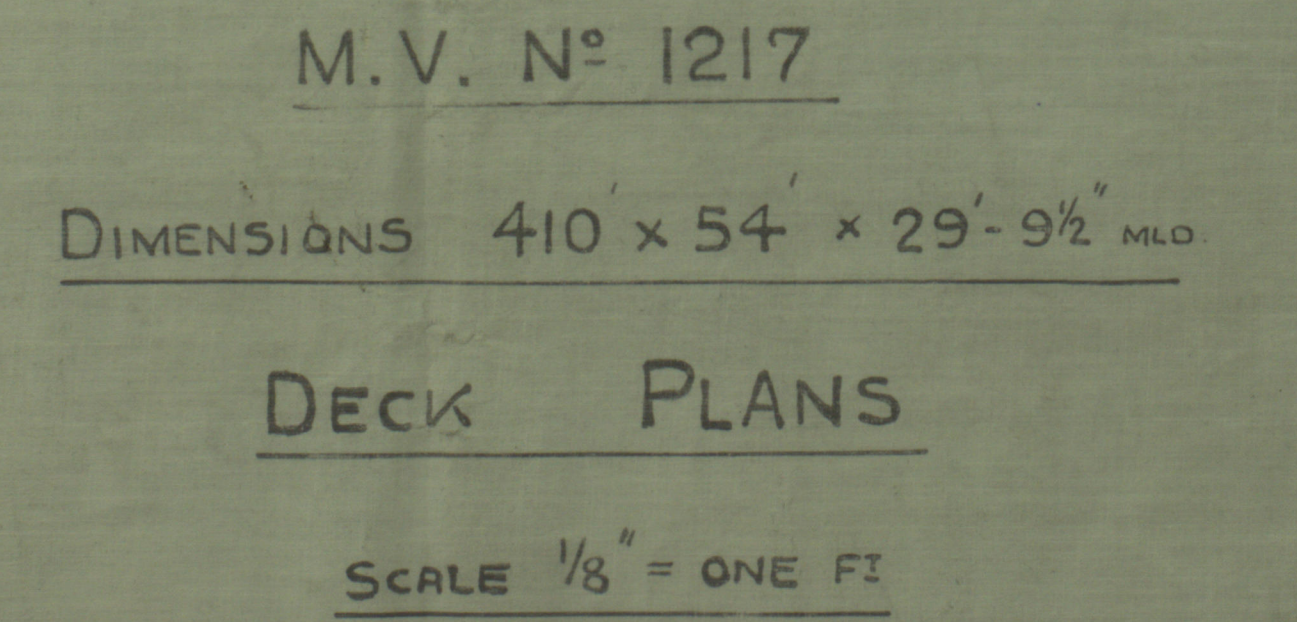

W. Denny & Bros Ltd.

No. 1217

PROFILE & DECKS.

Freeboard  
9 ft 6 in 47788

"Australind"

GLASGOW REPORT No.

49090



© 2019

Lloyd's Register  
Foundation

WS - 0095