





15/3/28

PARTICULARS OF BOILER	1 BOILER
TOTAL NUMBER OF PLAIN TUBES	74
STAY	32
ALL TUBES	106
HEATING SURFACE OF ONE TUBE	1.535
IN TUBES	113
FURNACE	71
COMBUSTION CHAMBER	76
TOTAL	560
AREA THRU BOILER TUBES	
RATIOS	
WEIGHT OF WATER IN TONS	
BOILER	
WORKING PRESSURE LBS PER SQ IN	125
TEST	235

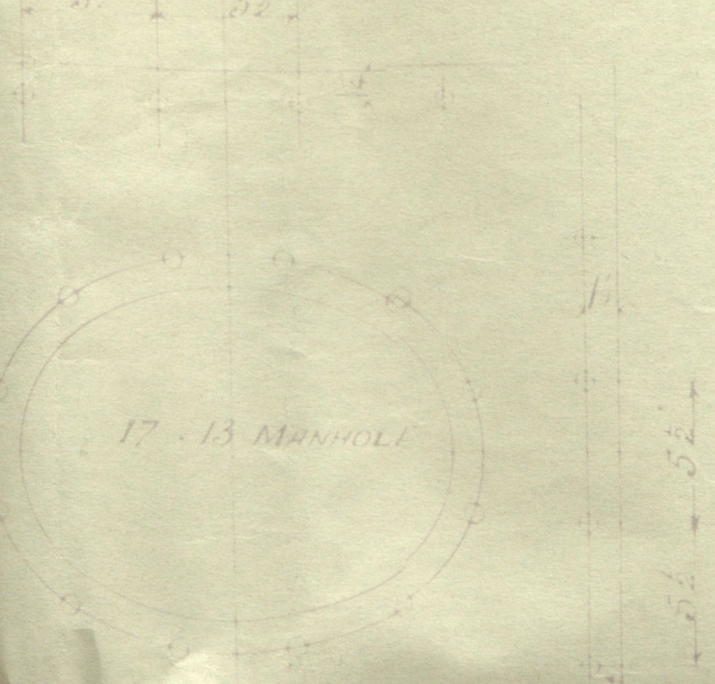



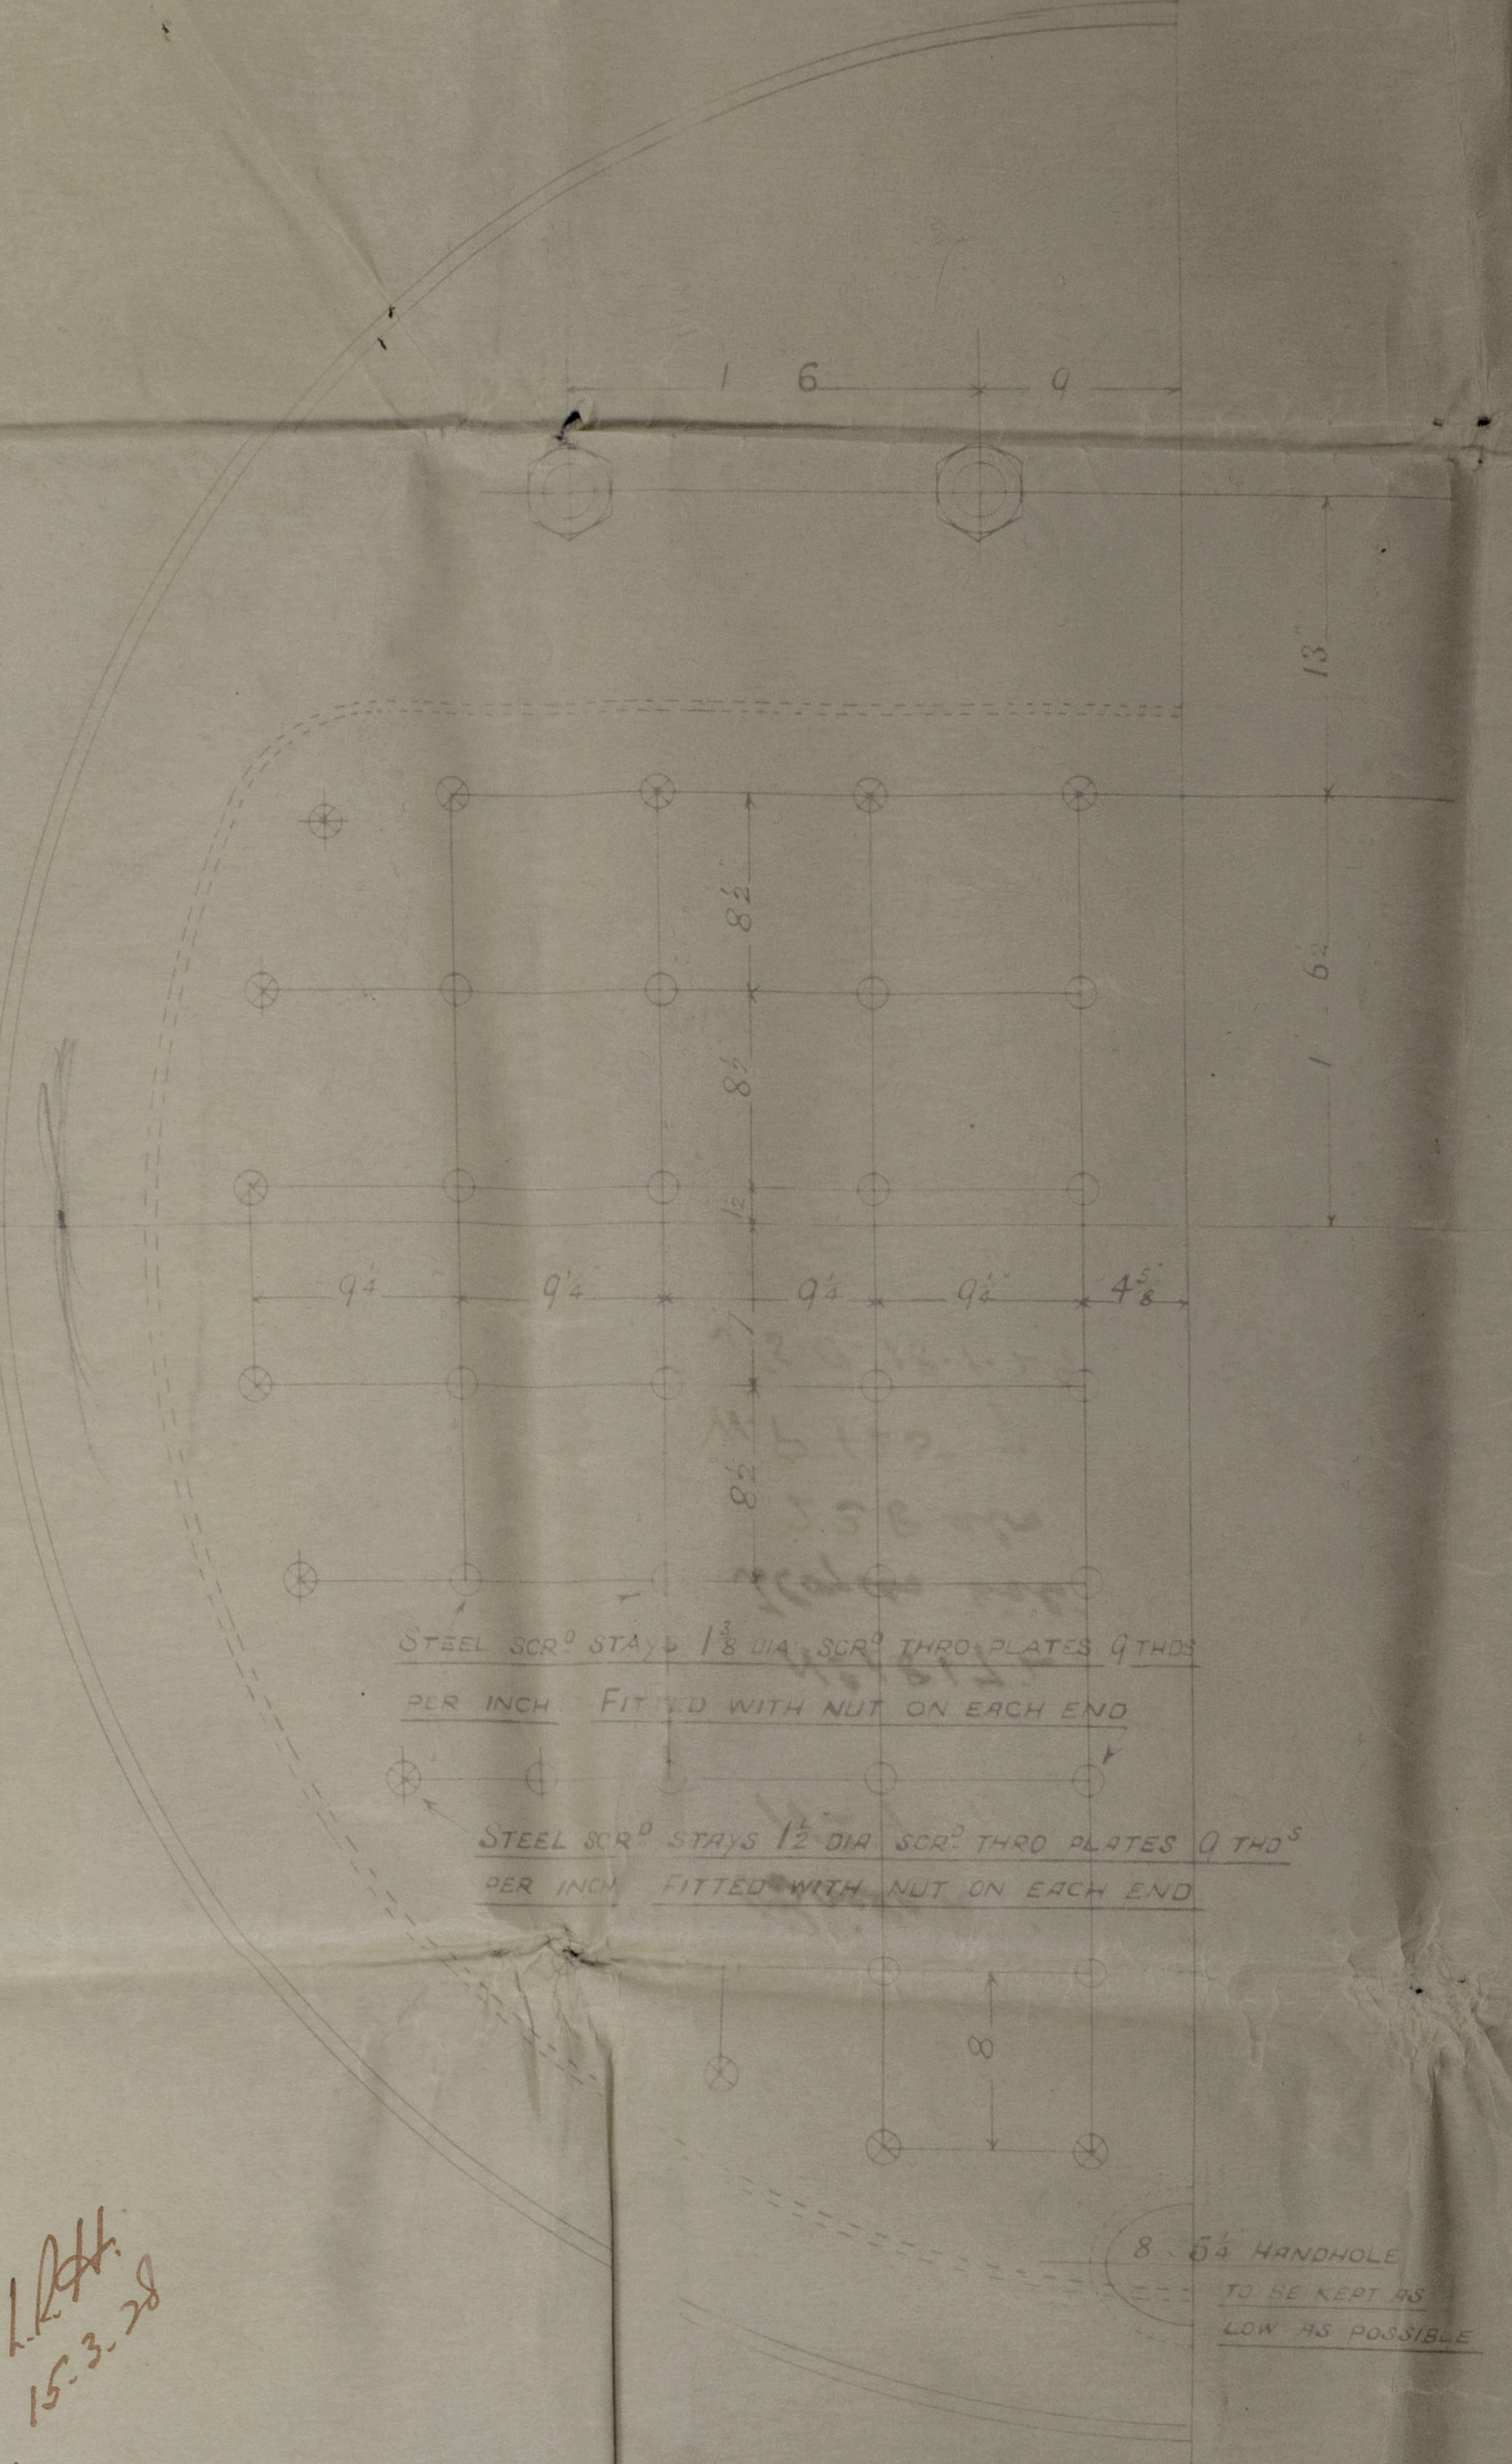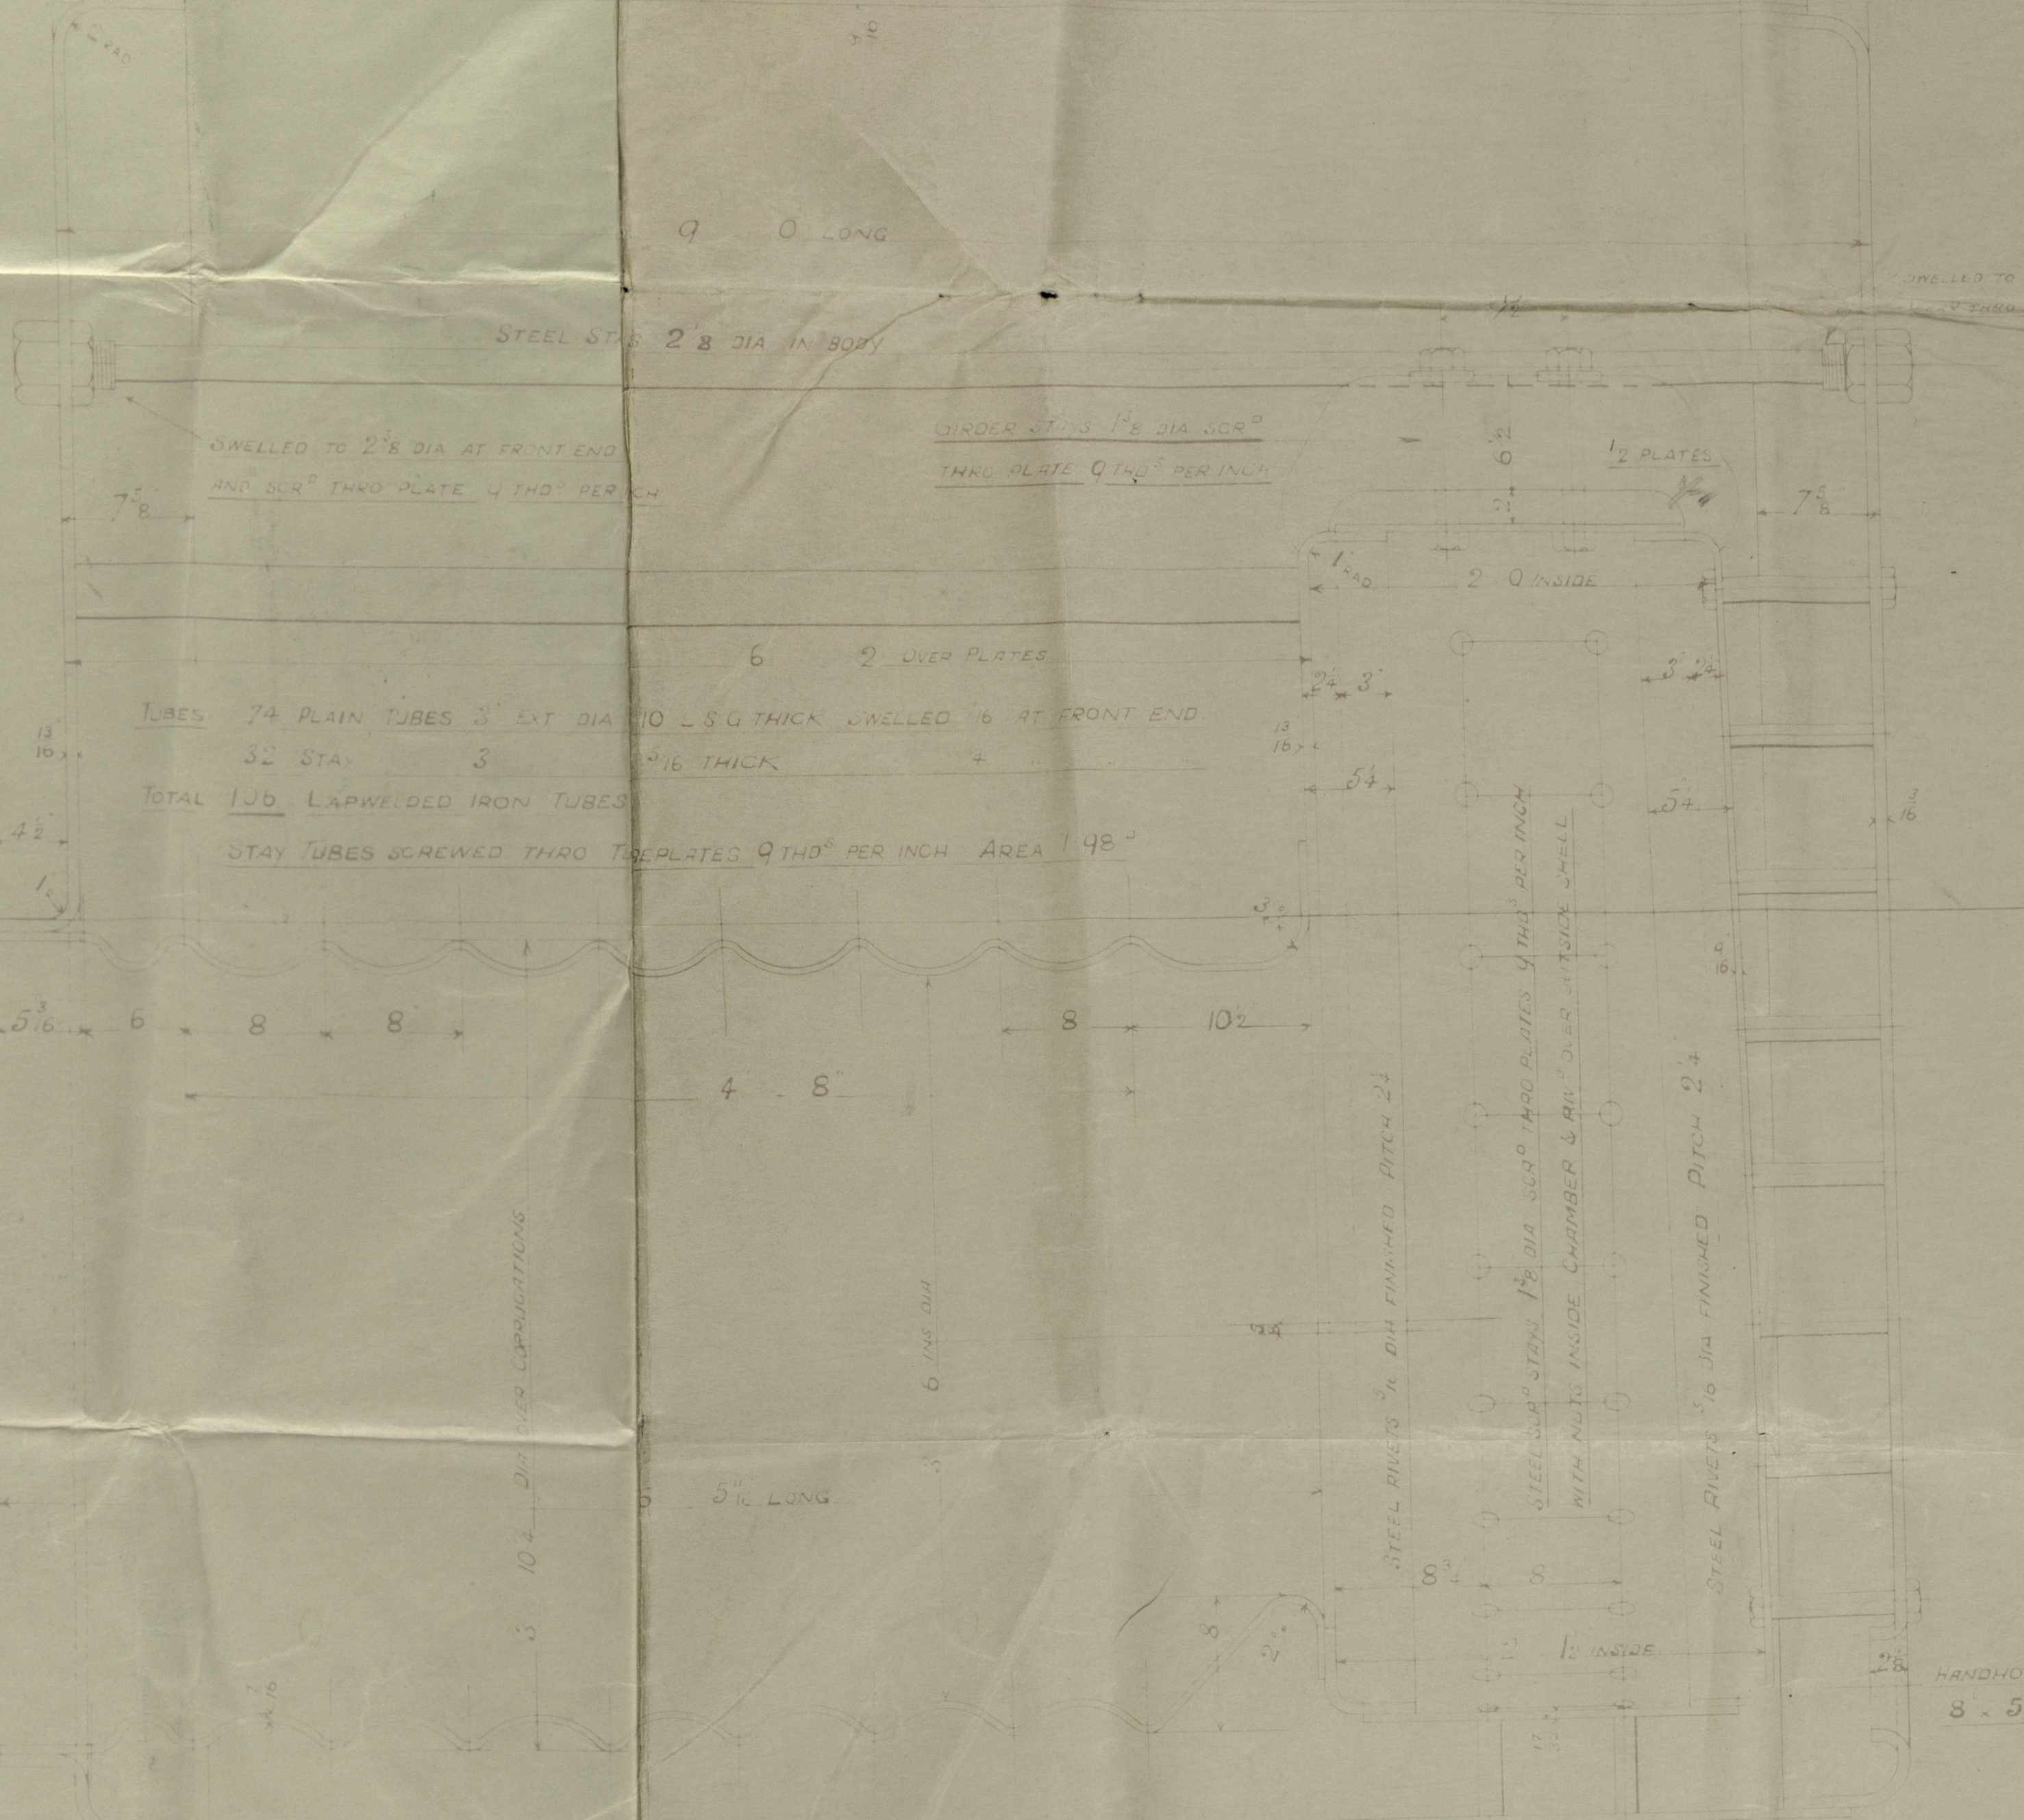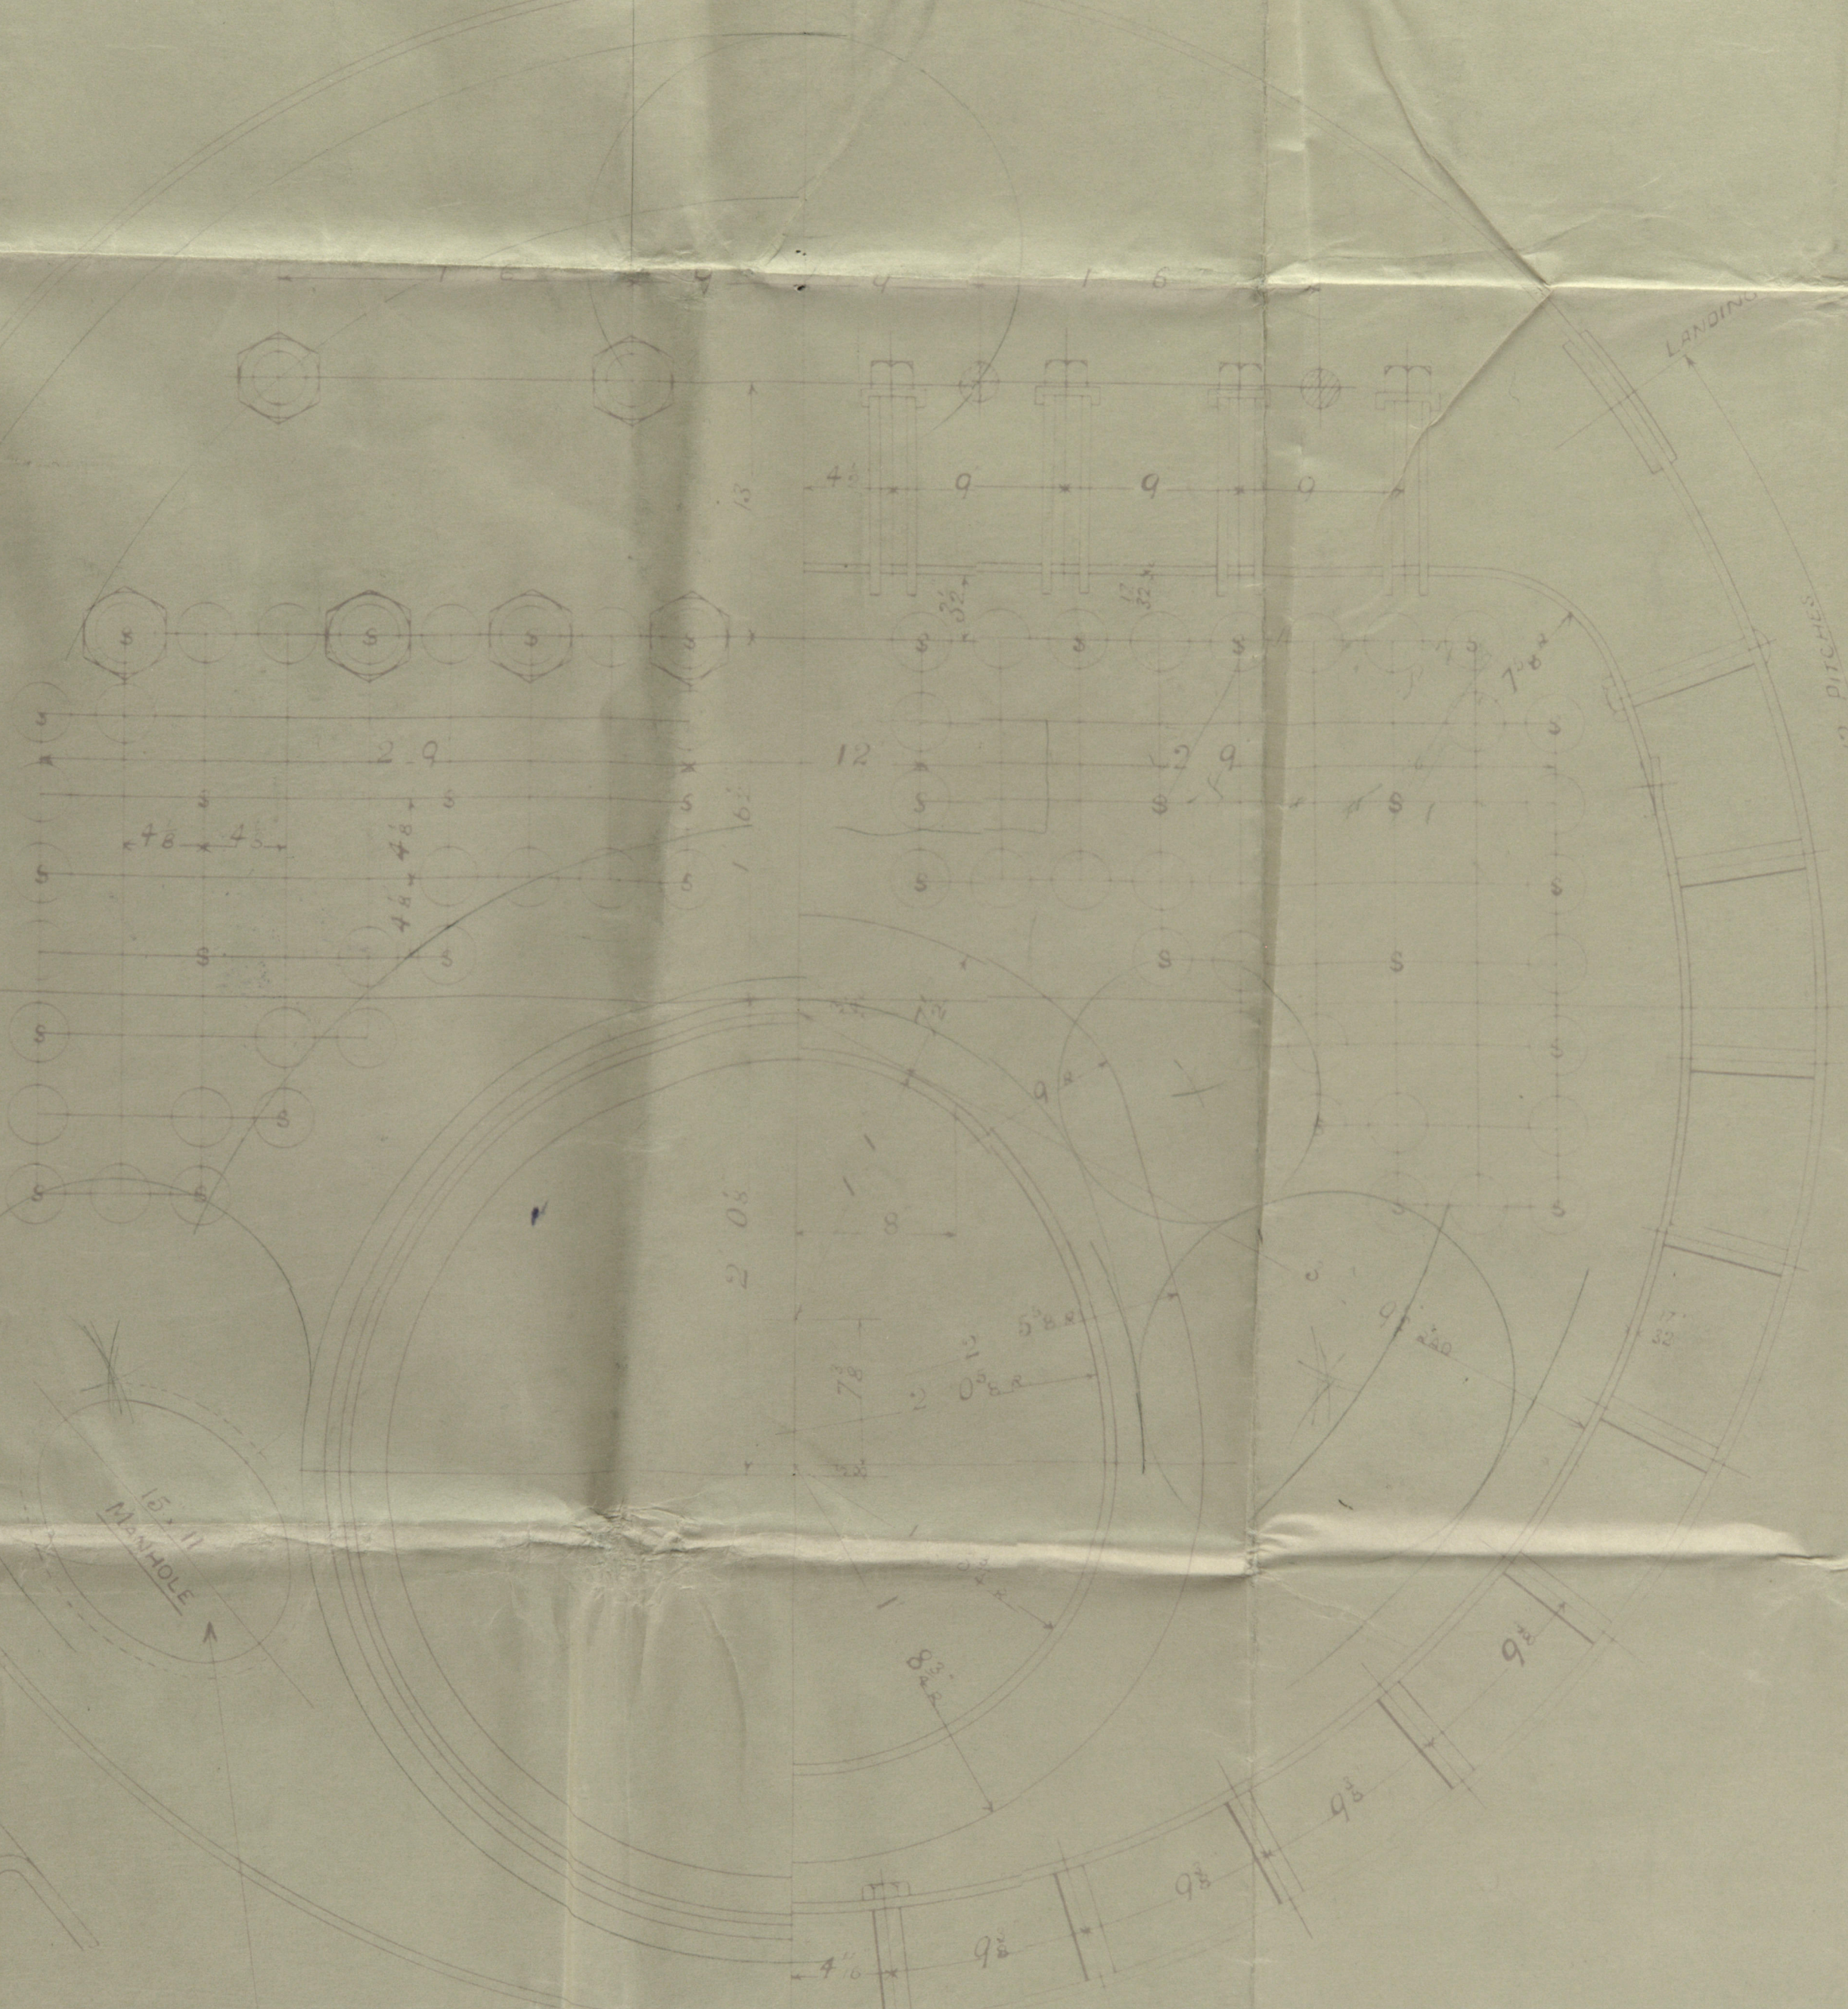

10th
15.3.28
10th



BOILER
Nº 969 D13
SCALE 1" = 1 FOOT

125 LBS WORKING PRESSURE
LLOYD'S SURVEY

Boiler :

Nº 969 B

Nº 18172

Hoyas Est

228 lbs

W.P. 125 ..

J.S.C. 18.1.29

Australind

GLASGOW REPORT No. 49090



© 2019

Lloyd's Register
Foundation