


11/7/28 95773



2 CYLINDER FOUR CYCLE DIESEL ENGINE

CYL.DIAM. 310 ^M/_M—STROKE 350 ^M/_M

cm.
10/7/28
AKTIESELSKABET
BURMEISTER & WAIN'S MASKIN- OG SKIBSBYGGERI
d. 4-7-1928
E. Schum

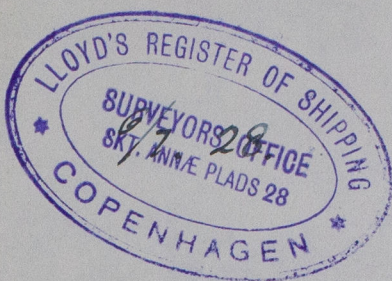

Plan of
CRANK SHAFT for 2 Cylinders
Auxiliary Diesel Oil Engine
for the twin screw Motor Vessel
Yard No 557

being built by

AKTIESELSKABET
BURMEISTER & WAINES MASKIN- OG SKIBSBYGGERI
Copenhagen.

"Koenig" ^{ex}

M/s "STJERNEBORG" of Copenhagen
Copenhagen Report No 7970.

WJO-0037



© 2020

Lloyd's Register
Foundation