

17/10/28 37954

DONKEYBOILER

SKALA : 1:10

GR. 4GG

AKTIESELSKABET
8-10-28
T. L.

ÅKTIIESELSKABET
BURMEISTER & WAIN^S
MASKIN & SKIBSBYGGERI.
1-10 1928 N^o 37954 Register
Fouad 0038

Plan of

DONKEY BOILER


for the Twin Screw Motor Vessel

Yard No 557

being built by

akt Burmeister & Wain,

Copenhagen.

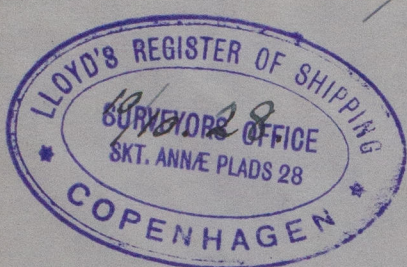

"Koenigil"

M/s "STJERNEBORG" of Copenhagen

Copenhagen Report No 7970

W 50-0038


14.3.29

W.P. 7 kg/cm²

14 kg/cm²

LLOYD'S TEST

No 507

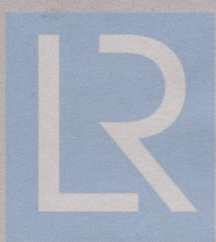

© 2020

Lloyd's Register
Foundation