


Lloyds Stamp
16/6/20

MIDSHIP SECTION

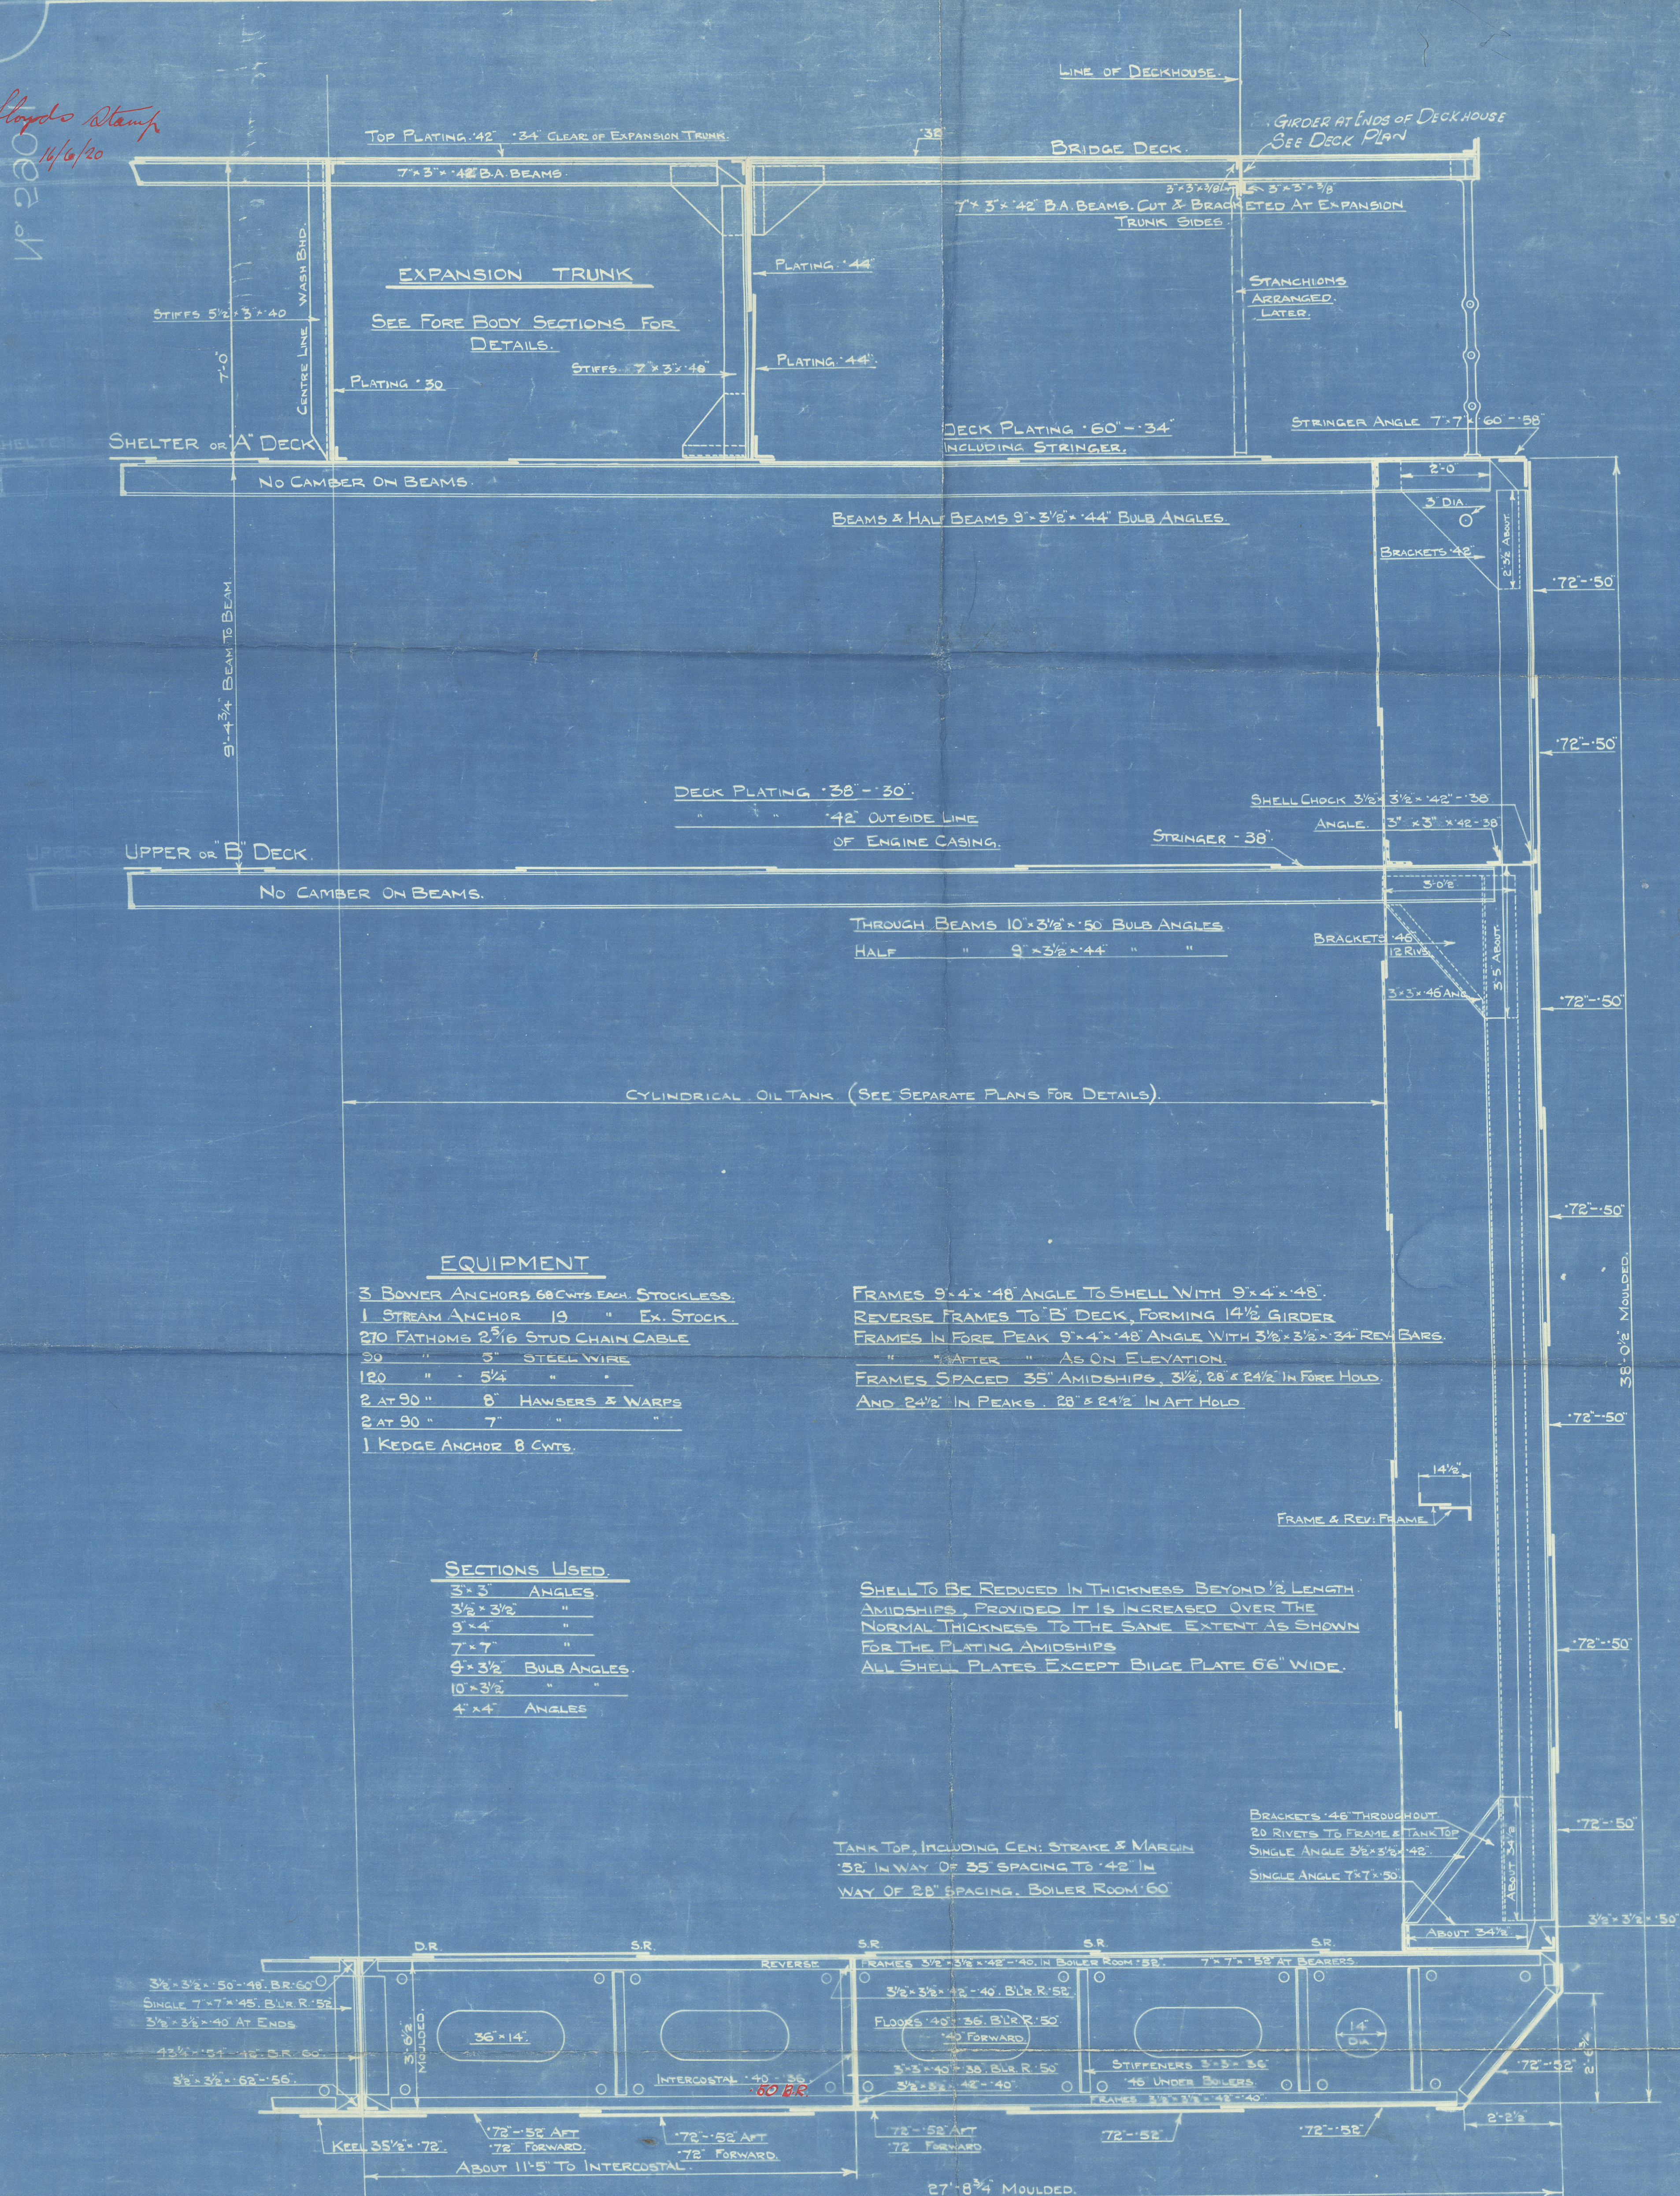

EQUIPMENT

- 3 BOWER ANCHORS 68 CWTs EACH STOCKLESS.
- 1 STREAM ANCHOR 19 " EX. STOCK.
- 270 FATHOMS 2 3/16" STUD CHAIN CABLE
- 30 " 5" STEEL WIRE
- 120 " 5 1/4 " "
- 2 AT 90 " 6" HAWSERS & WARPS
- 2 AT 90 " 7 " "
- 1 KEDGE ANCHOR 8 CWTs.


SECTIONS USED.

- 3x3 ANGLES.
- 3 1/2 x 3 1/2 "
- 9x4 "
- 7x7 "
- 9x3 1/2 BULB ANGLES.
- 10x3 1/2 "
- 4x4 ANGLES


FRAMES 9x4x48 ANGLE TO SHELL WITH 9x4x48.
REVERSE FRAMES TO B DECK, FORMING 14 1/2 GIRDER
FRAMES IN FORE PEAK 9x4x48 ANGLE WITH 3 1/2 x 3 1/2 x 34 REV BARS.
" " " " " AS ON ELEVATION.
FRAMES SPACED 35" AMIDSHIPS, 3 1/2, 28" & 24 1/2" IN FORE HOLD.
AND 24 1/2" IN PEAKS, 28" & 24 1/2" IN AFT HOLD.

SHELL TO BE REDUCED IN THICKNESS BEYOND 1/2 LENGTH
AMIDSHIPS, PROVIDED IT IS INCREASED OVER THE
NORMAL THICKNESS TO THE SAME EXTENT AS SHOWN
FOR THE PLATING AMIDSHIPS
ALL SHELL PLATES EXCEPT BILGE PLATE 66" WIDE.

TANK TOP, INCLUDING CEN. STRAKE & MARGIN
52" IN WAY OF 25" SPACING TO 42" IN
WAY OF 28" SPACING. BOILER ROOM 60"

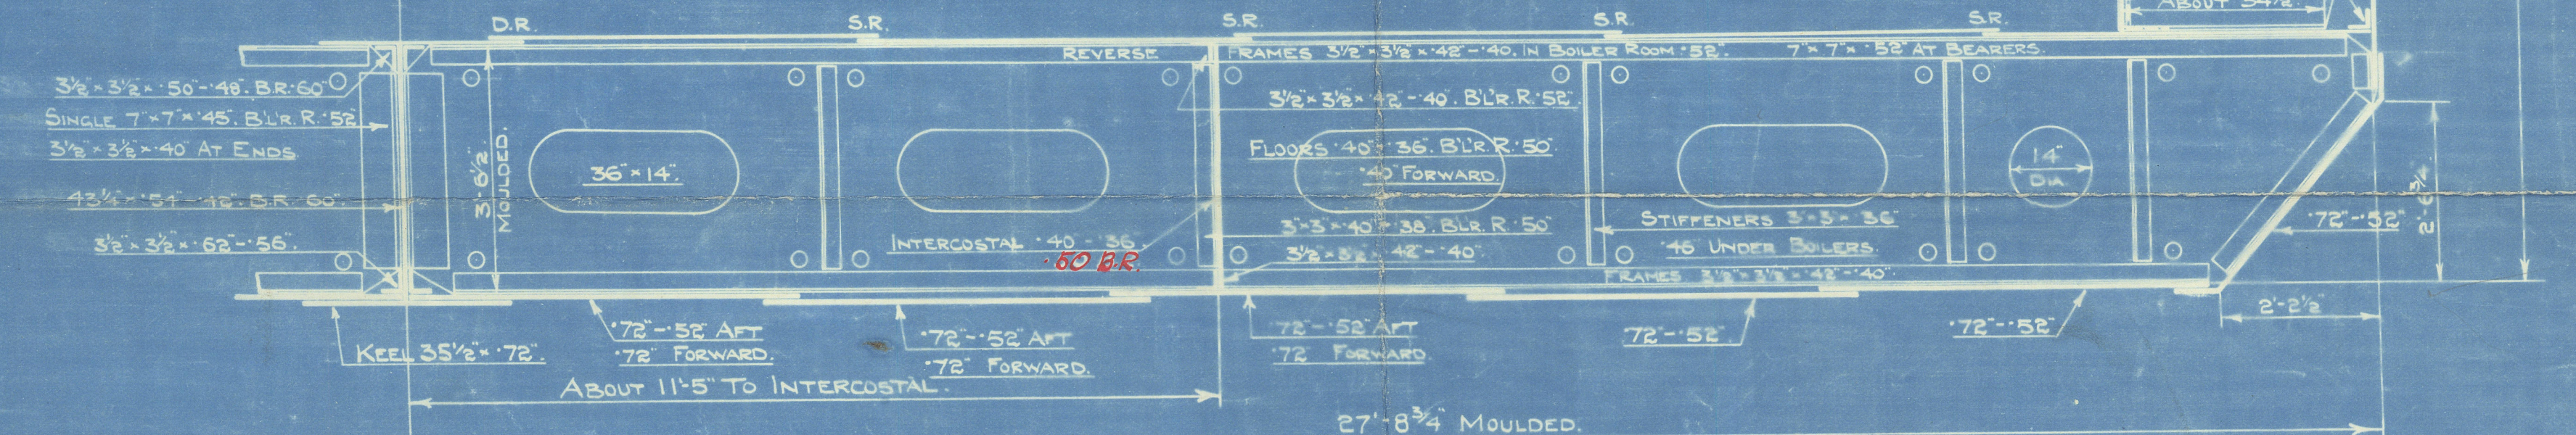

SECTION IN WAY OF ENGINES

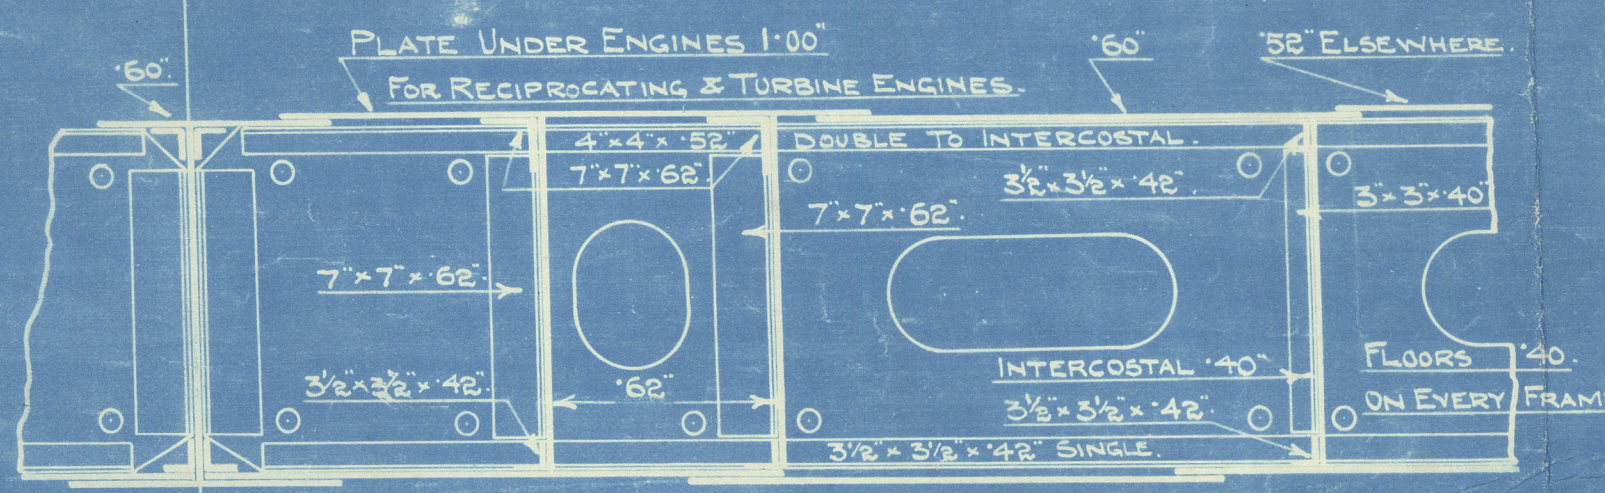

Nº 1123.

Nº 640^{DR}

MIDSHIP SECTION

SCALE 1" = 1/2 INCH = 1 FOOT.

TO CLASS AT LLOYDS. 100 AL. SHELTER DECK.

NUMERALS

B + D = 55.46 + 30.04 = 85.50
L x (B + D) = 411.5 x 85.50 = 35183.
EQUIPMENT = 35183 + 3575 + 291.68 = 39449.68



MIDSHIP SECTION

Nº

Lloyds Register Foundation

Henry Bros Ltd

1129

Midship Section

RETAIN

* Inverglass

Glasgow Rpt No 44193

①1

RETAIN

W500-0180



© 2021

Lloyd's Register
Foundation