


S.S. KINGSBURY

No 3 Hatchway on Bridge Deck.

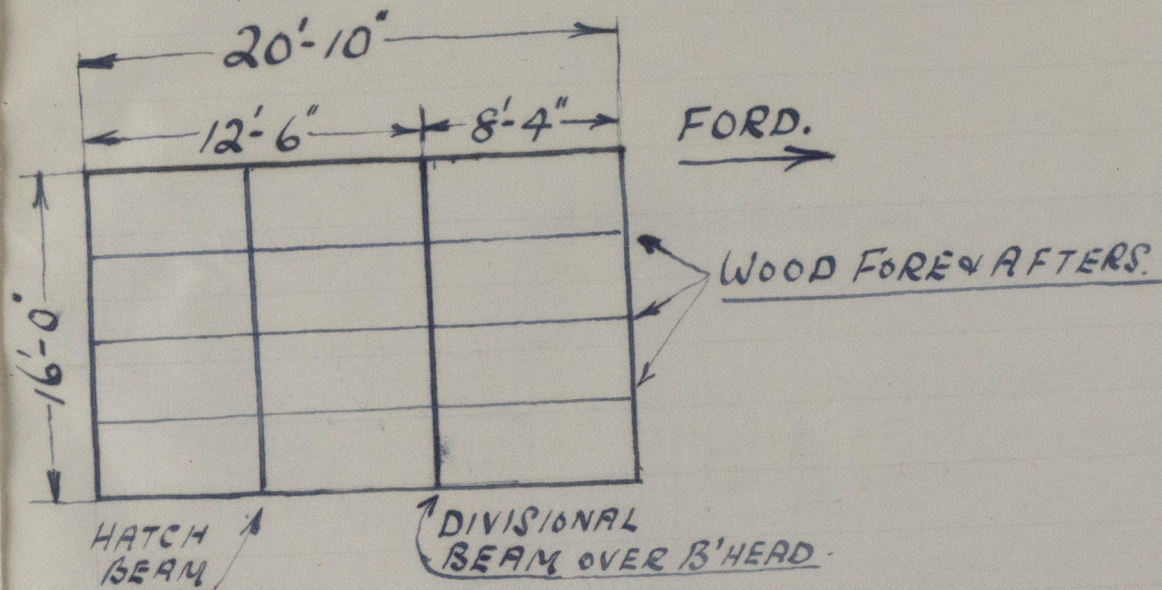

Hatch beam



Bulb plate 9" x 50.
TOP ANGLES 3 1/2" x 3 1/2" x 40.
BOT ANGLE 3 1/2" x 3 1/2" x 50.

Beam sockets renewed, 3" bearing, 1/2" thick.
new beam ends fitted.

WR.



© 2021

Lloyd's Register

Foundation