


WARD REPORT on the

*S S Kingsbury*

N<sup>o</sup> 3 Hatchway or Bridge D<sup>th</sup>

*on Newcastle  
report  
28/10/32*

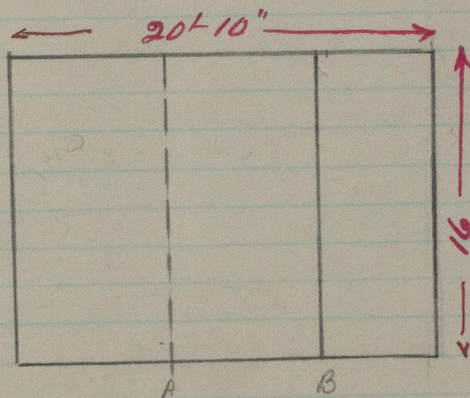

*From report it is not  
clear whether A or B is  
the division beams.  
over wellhead*

Hatch beam

1 div

1 beam

Spacing

6'-0" to 8'-3"

Scantlings

$3\frac{1}{2} \times 3\frac{1}{2} \times 32$   
8" x 50" B.P.

bearing surface

brackets with  
3 bolts

Rule beams

assuming 12 ft length  
& one beam.

© 2021  
 $3\frac{1}{2} \times 8 \times 42$  Angle  
TFB.  
12 x 32  
J/L

Lloyd's Register  
WJ00-0228