
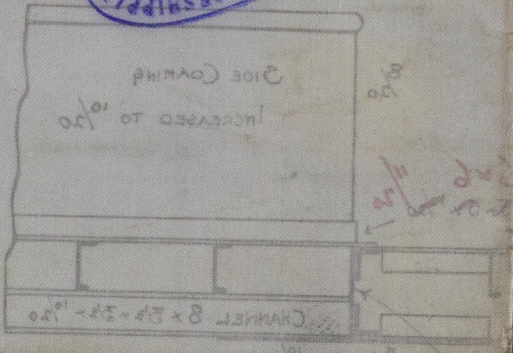


© 2021
Lloyd's Register
Foundation

Newcastle-on-Tyne
Midship Section of Messrs Readhead
YARD N^o 378

S/S ILWEN

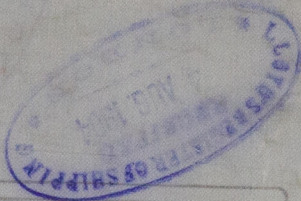

RETAIN



© 2021

Lloyd's Register
Foundation

W500-0268