







C. C. Vincent & Co.

Midship Section

~~N<sup>o</sup> 336 s/s~~

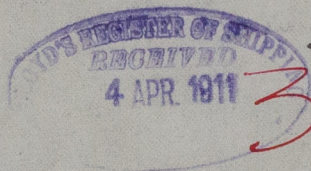

337, 343 & 4

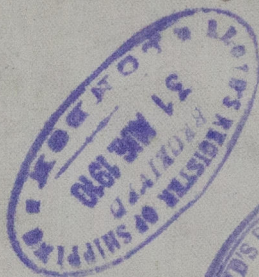


Avildar s/s

GLASGOW REPORT No. 30020


GLASGOW REPORT No. 31195

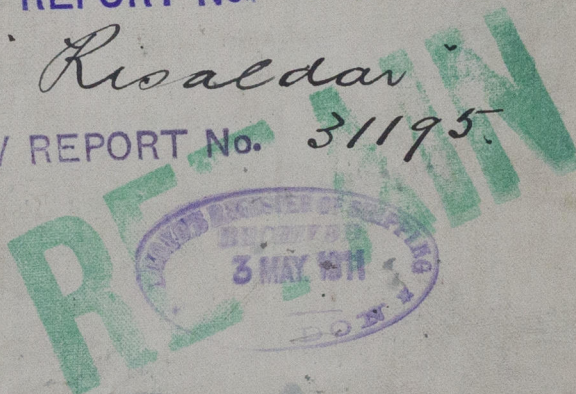

s/s Suba

GLASGOW REPORT No. 31339

W501-0274



© 2019

Lloyd's Register  
Foundation