


WOOD SKINNER & CO. LTD.  
SHIPBUILDERS  
NEWCASTLE TYNE

# PROPOSED LONGITUDINAL ELEVATION

OF STEEL SCREW STEAMER

TO CLASS 100 A.1. AT LLOYD'S.

PRINCIPAL DIMENSIONS 250' x 32' x 18'-6"

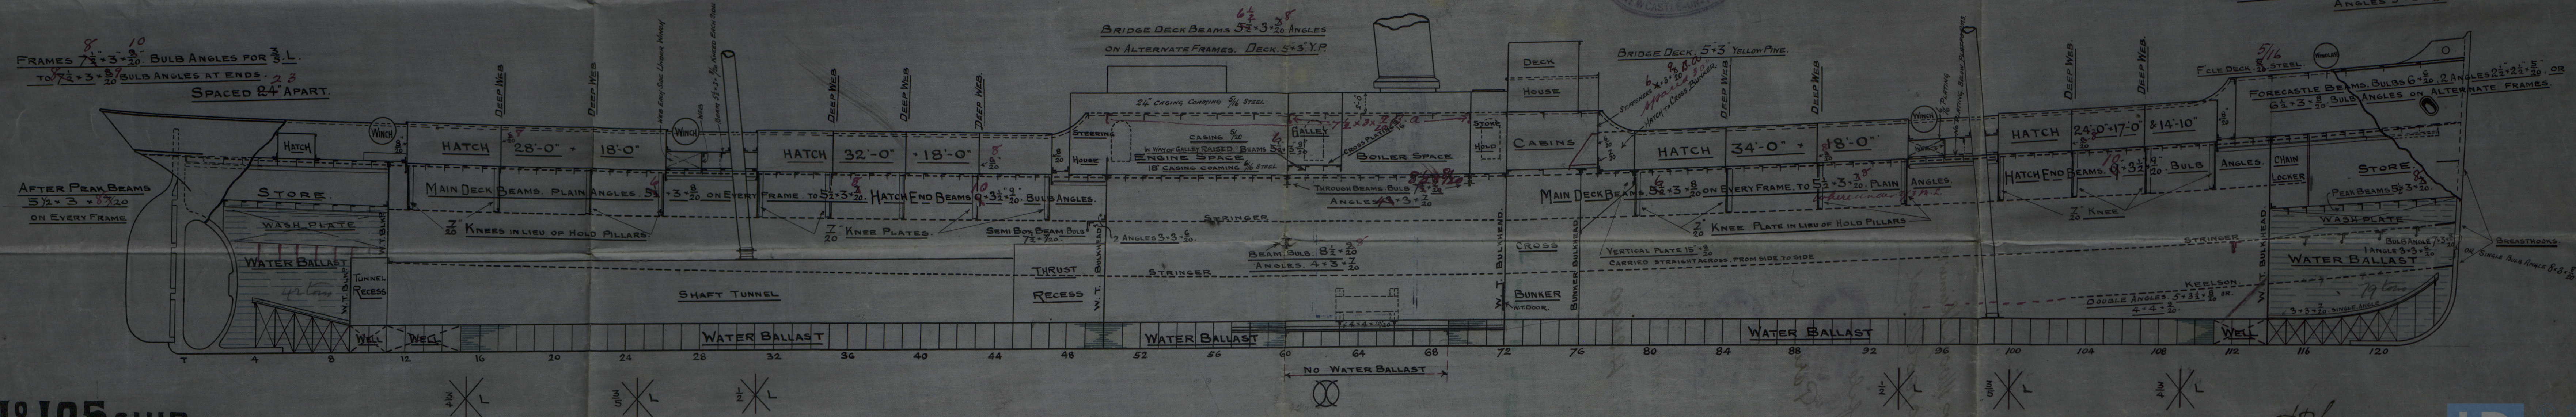

No 105 SHIP

W.C. 10068

© 2019 Lloyd's Register Foundation



Miss. Wood Skinner

No 100 Cessel

Profile

S.S. "Paris"

Newcastle Report

No 143490

RECEIVED

WS02-0068



© 2019

Lloyd's Register  
Foundation

