

B-1-157
© 2020
Lloyd's Register
Foundation
WSQ-0016

Philadelphia
Harlan & Hollingsworth Corporation


Contract No 446-449

Two main Boilers

WP 180 lbs

amended plan

Lada Copy

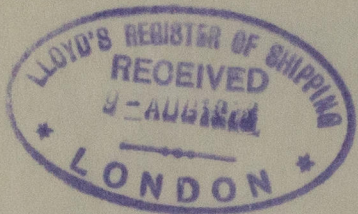

RETAIN

"O.T. Waring"

W503-0016



© 2020

Lloyd's Register
Foundation