

# MIDSHIP SECTION

- N<sup>os</sup> 225-226-227 -

LENGTH B.P. ----- 314 - 0


BREADTH M<sup>id</sup> ----- 46 - 3

DEPTH M<sup>id</sup> ----- 23 - 0 1/2

SCALE 1/2" = 1 FOOT



76.2.04  
75.3.04  
28.3.04  
12.5.04  
11.6.04  
22.12.04

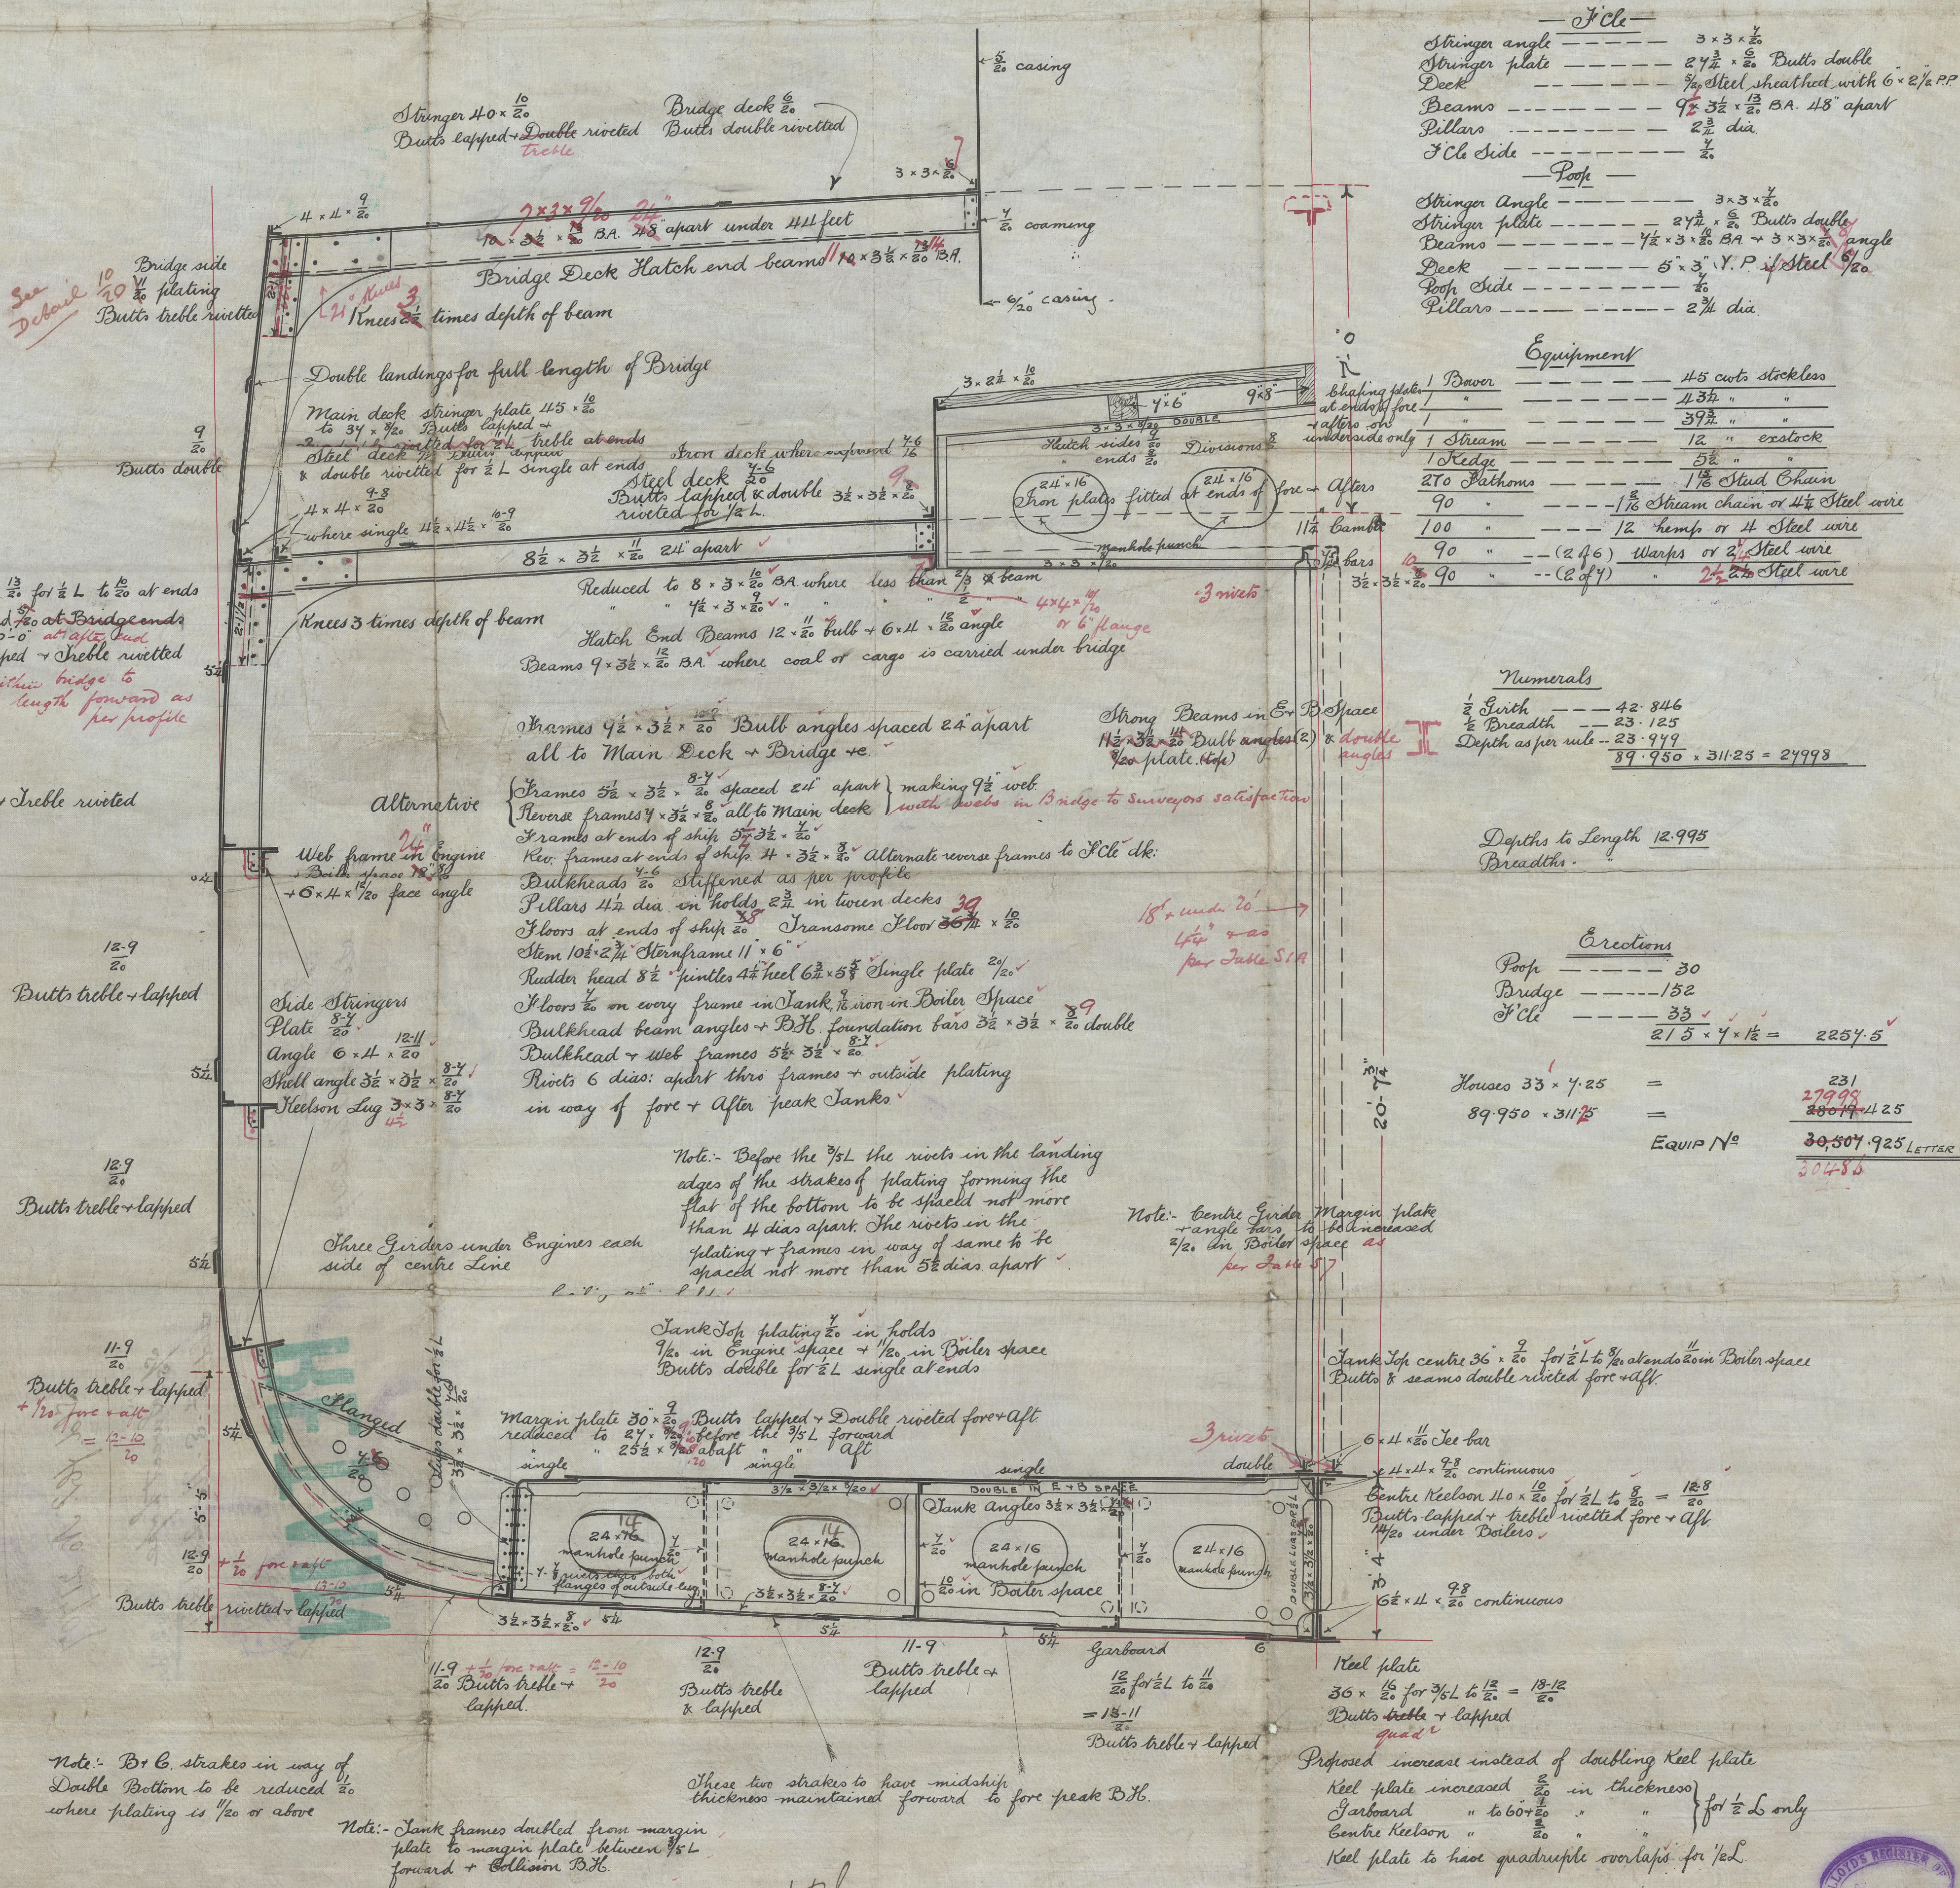

F'le	
Stringer angle	3 x 3 x 1/2
Stringer plate	2 1/2 x 1/2 Butts double
Deck	7/8 Steel sheathed with 6 x 2 1/2 PP
Beams	9 1/2 x 3 1/2 BA 11 1/2 apart
Pillars	2 1/2 dia
F'le Side	1/2

Poop	
Stringer Angle	3 x 3 x 1/2
Stringer plate	2 1/2 x 1/2 Butts double
Beams	7/8 x 3 1/2 BA 11 1/2 apart
Deck	5 x 3 Y.P. if Steel 7/8
Pooh Side	1/2
Pillars	2 1/2 dia

Equipment	
Shaping plate	145 cuts stockless
1 Bower	11 3/4 "
1 " "	39 1/2 "
1 " "	12 " ex stock
1 Kedge	5 1/2 "
270 Pathons	1 1/2 Stud Chain
90 "	1 1/2 Stud chain or 1 1/2 Steel wire
100 "	12 hump or 14 Steel wire
90 "	(246) Wares or 2 Steel wire
90 "	(246) " 2 1/2 Steel wire

Numerals	
1/2 Girth	42.846
1/2 Breadth	23.125
Depth as per rule	23.999
	89.950 x 311.25 = 27998

Depths to Length 12.995  
Breadths

Creations	
Pooh	30
Bridge	152
F'le	33
	21.5 x 7 1/2 = 225.75

Houses 33 x 7.25	=	231
89.950 x 311.25	=	27998
	=	28019.125
EQUIP N <sup>o</sup>		29,507.925 LETTER U





Sunderland SBC<sup>o</sup>

---

No 225-4-7

---

Midship  
Section

---

Sld. fbr. No. 21707

---

S/S "Sweet hope" Exepli  
Sld F.S. No 22127

WUK  
124  
RETAIN

Lloyd's Register  
Foundation  
W505-0060



150  
SHIP SEC 150


