


RETAİN



is 1 frame
space overhang
in W. 225.

26/2/04

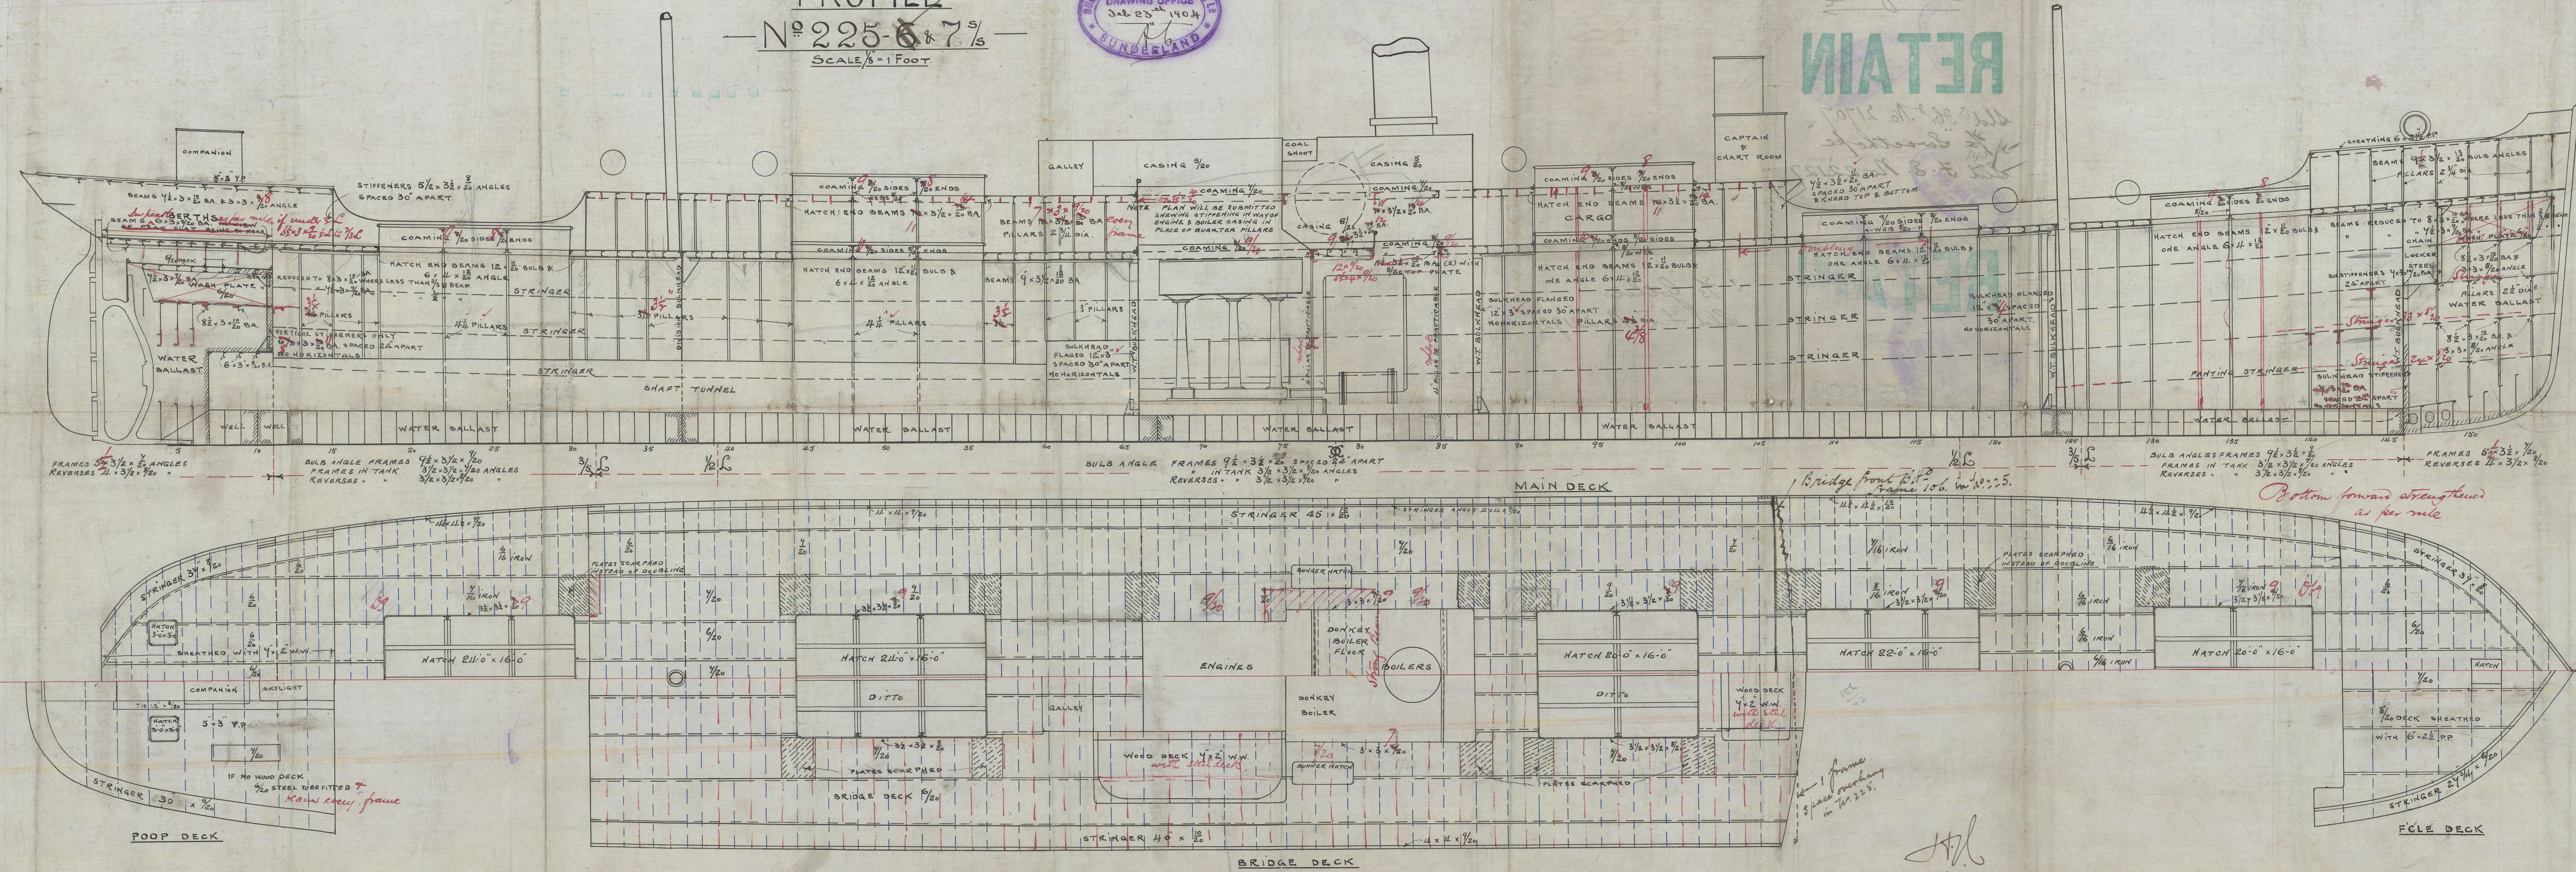

Sunderland

SBCO

No. 225-4-7

Profile

RETAIN

Sld. H^d No. 21707
1/2 "Sweethope"

Sld. F. E. No. 22127

RETAIN

1/2 Gothic

Sld. F. E. No. 22192



Lloyd's Register
Foundation

W505-006