


MESSRS RICHARDSON, DUCK & CO LD S.S. No 653.

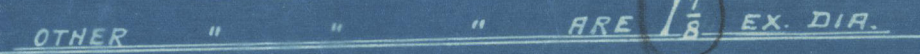

MESSRS RICHARDSON, DUCK

**From BLAIR & CO., Ltd.,
STOCKTON-on-TEES.**

For Enclosure to

Messrs Lloyd's
Registry of Shipping
Middlesbrough

W505-0188(112)

3 Main Boilers

Messrs Blair & Co Lim^d

No. 1840

for


Messrs Richardson Duck & Co

S.S. No 653

Working Press 185 lbs

S.S. Cardigan

- 9925 -

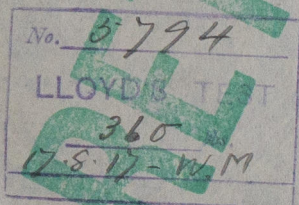

© 2020

W505-0188(212)

Lloyd's Register
Foundation