

10.3.15
19.3.15
31.3.15
7-4-15

MIDSHIP SECTION. N° 311.

SCALE $\frac{1}{2}$ " = 1 FOOT

TO CLASS 100 A.I. AT LLOYDS

SCANTLING NUMBERS

TRANSVERSE N° B + D $36 + 16.66 = 52.66$

LONGITUDINAL N° L (B + D) $265 \times 52.66 = 13959$

D = 7.23 IN HOLDS

D = 14.83 MIDSHIPS IN MACHINERY SPACE

L = 265

D = 16.66 = 15.90

15.9 TO UPPER DECK

10.9 TO BRIDGE

EQUIPMENT

265 x 52.66 = 13959

ERECTOR'S = 2158

EQUIPMENT N° = 18112

EQUIPMENT

2 STOCKLESS BOMER ANCHORS	33 CWTs
1 TROTTERS	22 1/2 D ² EX. STOCK
1 D ² STRENGTH	8 1/2 D ² D ² D ²
1 D ² REDGE	4 1/2 D ² D ² D ²

CHABLES

240 FATHOMS OF 1 1/8" CHABLE

75 D² 1 1/8" CHAIN OR 7" STEEL WIRE

ROPE

30 FATHOMS 8" MANILLA. 100 FATHOMS 7" MANILLA

(2) 95 D² 6" D² (2) 95 D² 5 1/2 D²

1 95 D² 5" D²

FRAMES DOUBLED FROM BEFORE 7/8 L. TO COLLISION BULKHEAD TO TURN OF BULGE.

RIVETS IN BOTTOM SHELL PLATING & FRAMES BEFORE 7/8 L. SPACED 5 1/2 DIAM.

RIVETING.

Butts On SHEERSTRAKE & STRAKE BELOW TREBLE RIV² FOR 1/2 L.

DOUBLE BEYOND

Butts Of STRINGER (UPPER IN) TREBLE RIVETED FOR 1/2 L. DOUBLE BEYOND

" " SHELL PLATING TREBLE D² D² D²

" " LOWER IN STRINGER DOUBLE RIVETED

" " THE PLATES D² D²

" " FOUNDATION PLATES TREBLE RIVETED

" " DECK PLATING DOUBLE RIVETED FOR 1/2 L. SINGLE BEYOND

Edges Of SHELL PLATING ALL DOUBLE RIVETED THROUGHOUT EXCEPT STRAKES E, F, & I. WHICH ARE SINGLE AT ENDS.

WHERE SHEERSTRAKE IS ABOVE 1/8" TREBLE RIV²


Edges Of DECK PLATING SINGLE RIV²

Butts Of FOOT & FOLE STRINGERS DOUBLE RIV²

HEEL RIVETS 7/8" DIAMETER SPACED 5" DIAMETERS APART

STEM RIVETS 1 1/8" D² 5" D² 5" D²

STERNPOST RIVETS 1 1/8" DIAMETER D² 5" D²

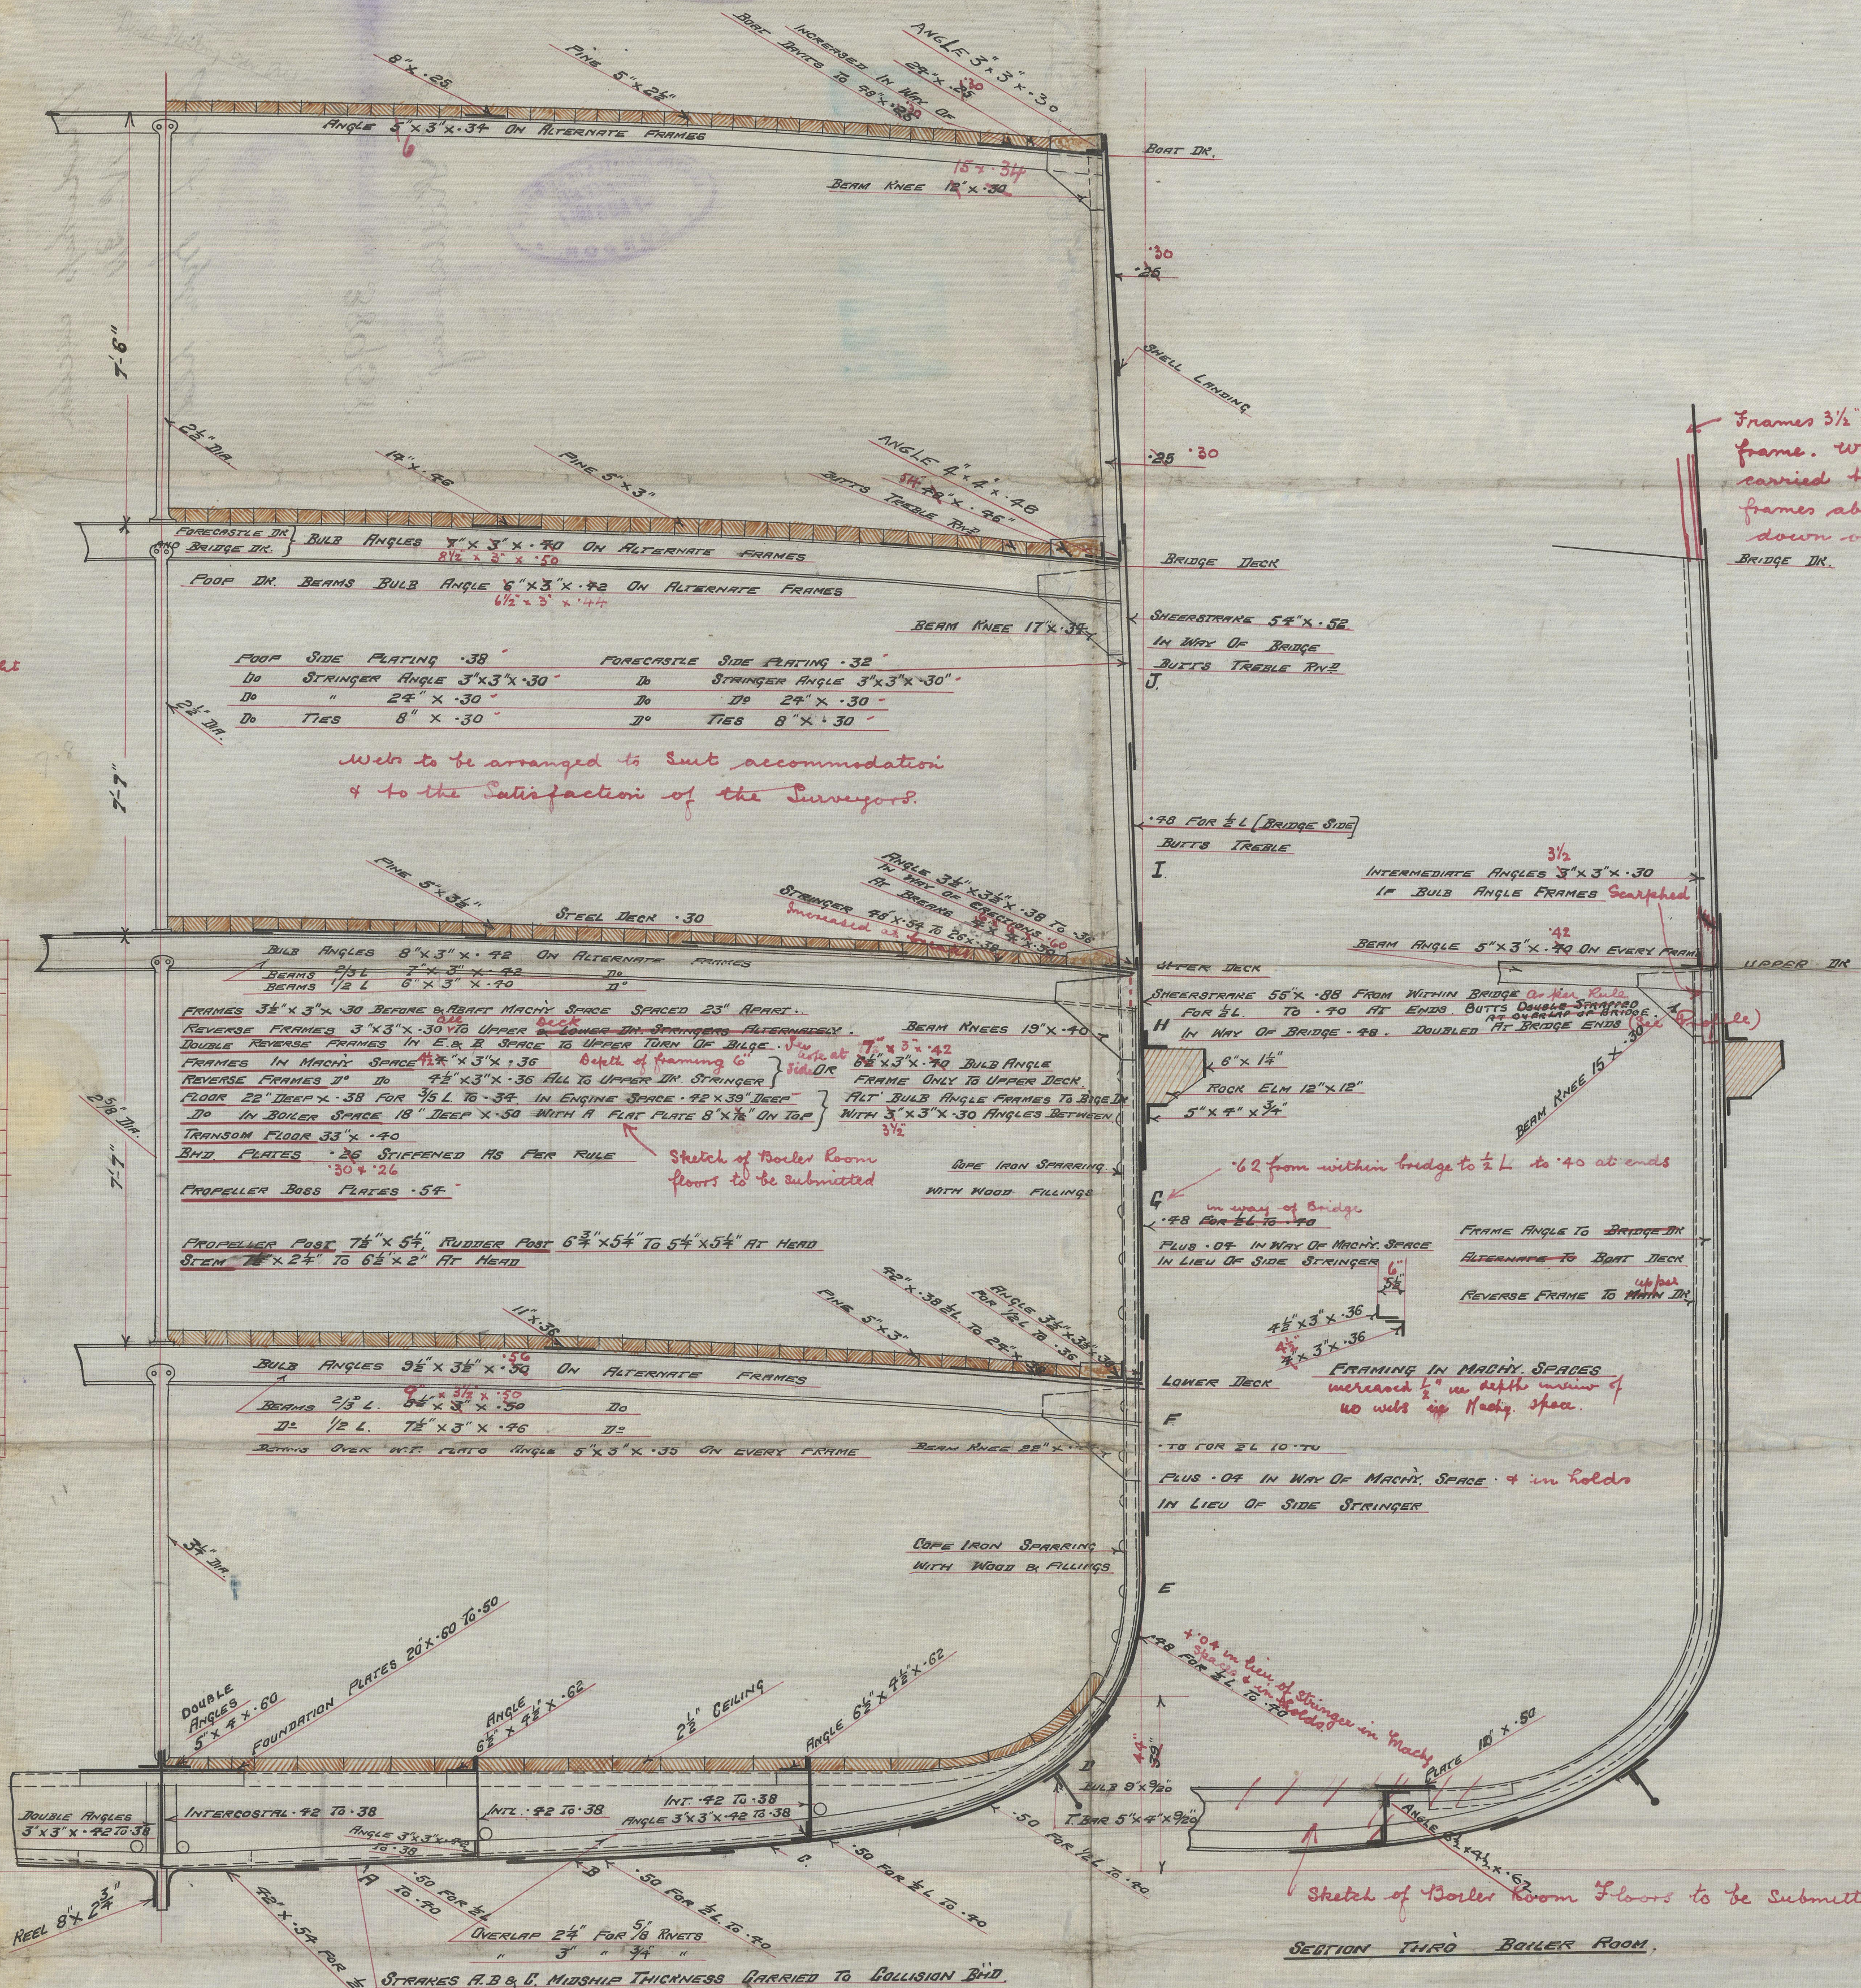

Frames 3 1/2" x 3" x 30" Angles on every frame. When all A frames are carried to Bridge Deck, the frames above are to be Scarfed down on Bulb Angle.

Web to be arranged to suit accommodation & to the satisfaction of the Surveyor.

Sketch of Boiler Room Floors to be submitted

FRAMING IN MACHINERY SPACES increased 1/2" in depth in way of 40 web up Mast. space.

Sketch of Boiler Room Floors to be submitted

Sketch showing special strengthening forward to be submitted

C.T. Jm.
10.3.15

A - L. Ingle - 1844

1847
1848
25


Made up Section

N^o 311

A. & J. Ingham Ltd

GLASGOW REPORT No. 38958

S. S. Killatney

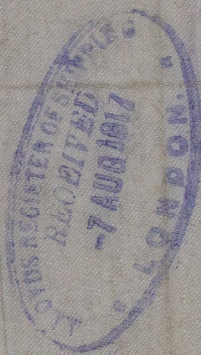

© 2020

Lloyd's Register
Foundation

W505-0234