

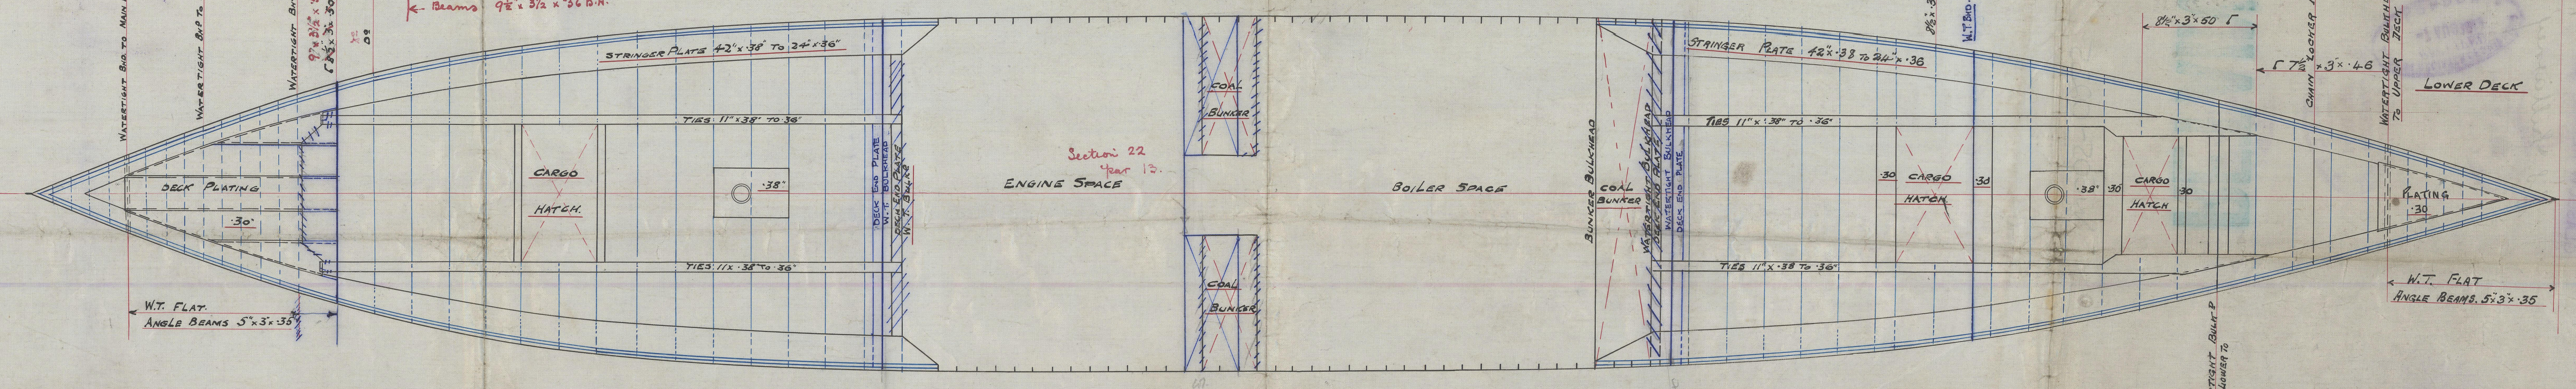
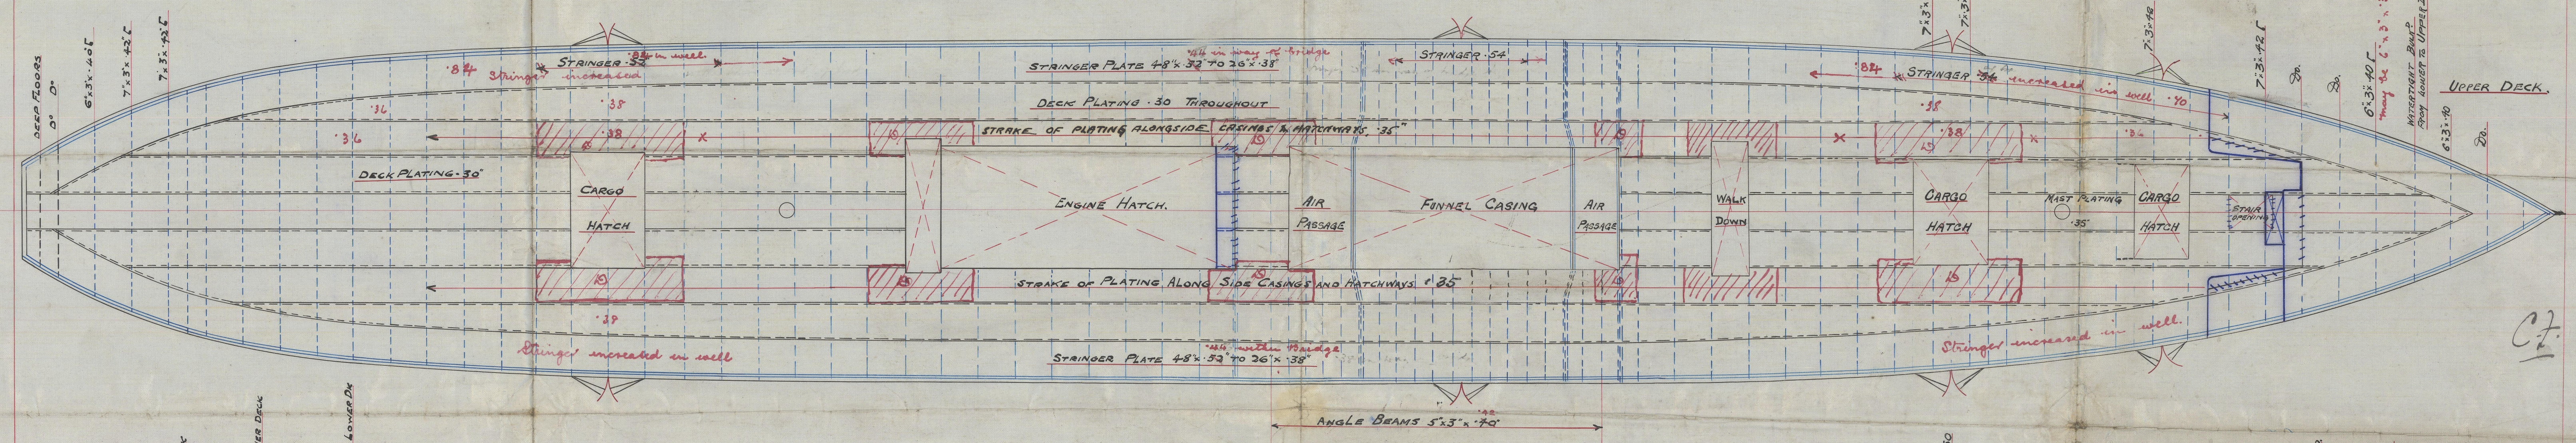


10.3.14  
19.3.15  
31.3.15  
2-4-15

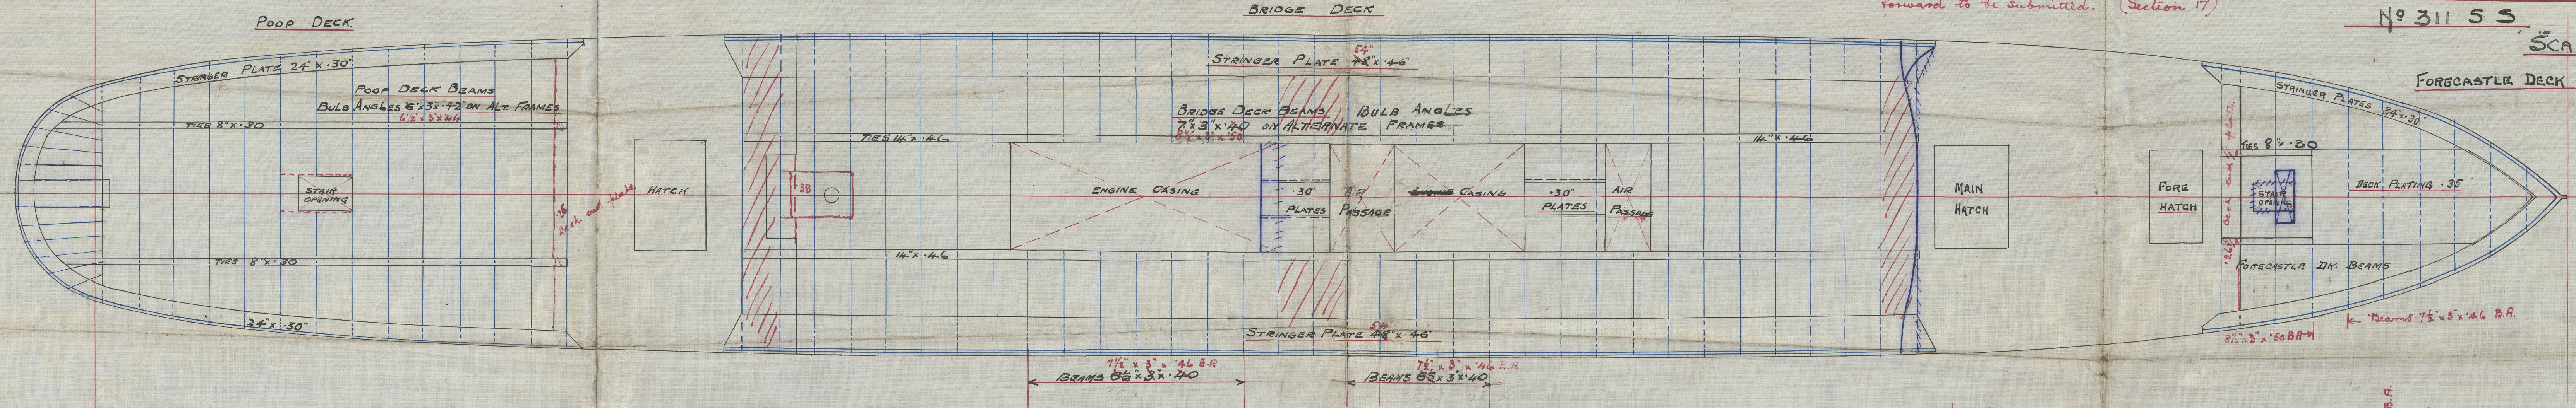

10.3.15

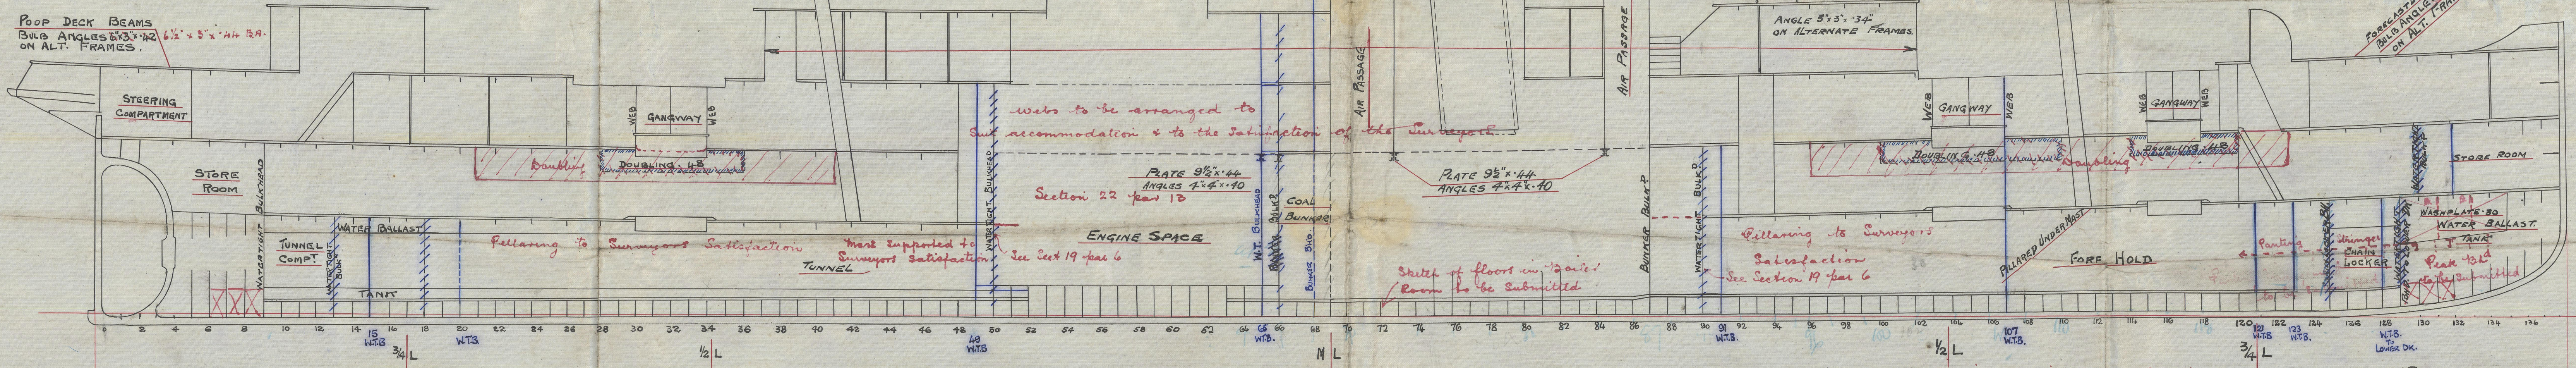


N<sup>o</sup> 311

Profile & Deck Plans

A + J. Inglis & Co

GLASGOW REPORT No 38958


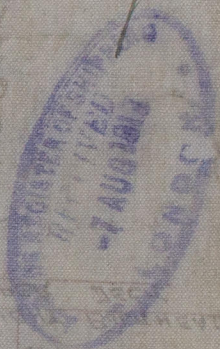

© 2020

Lloyd's Register  
Foundation

W505-0235