


NEW HOLLOW WATER GAUGE COLUMNS

AS RECOMMENDED AND FITTED.

CADIZ REPORT N° 1022.

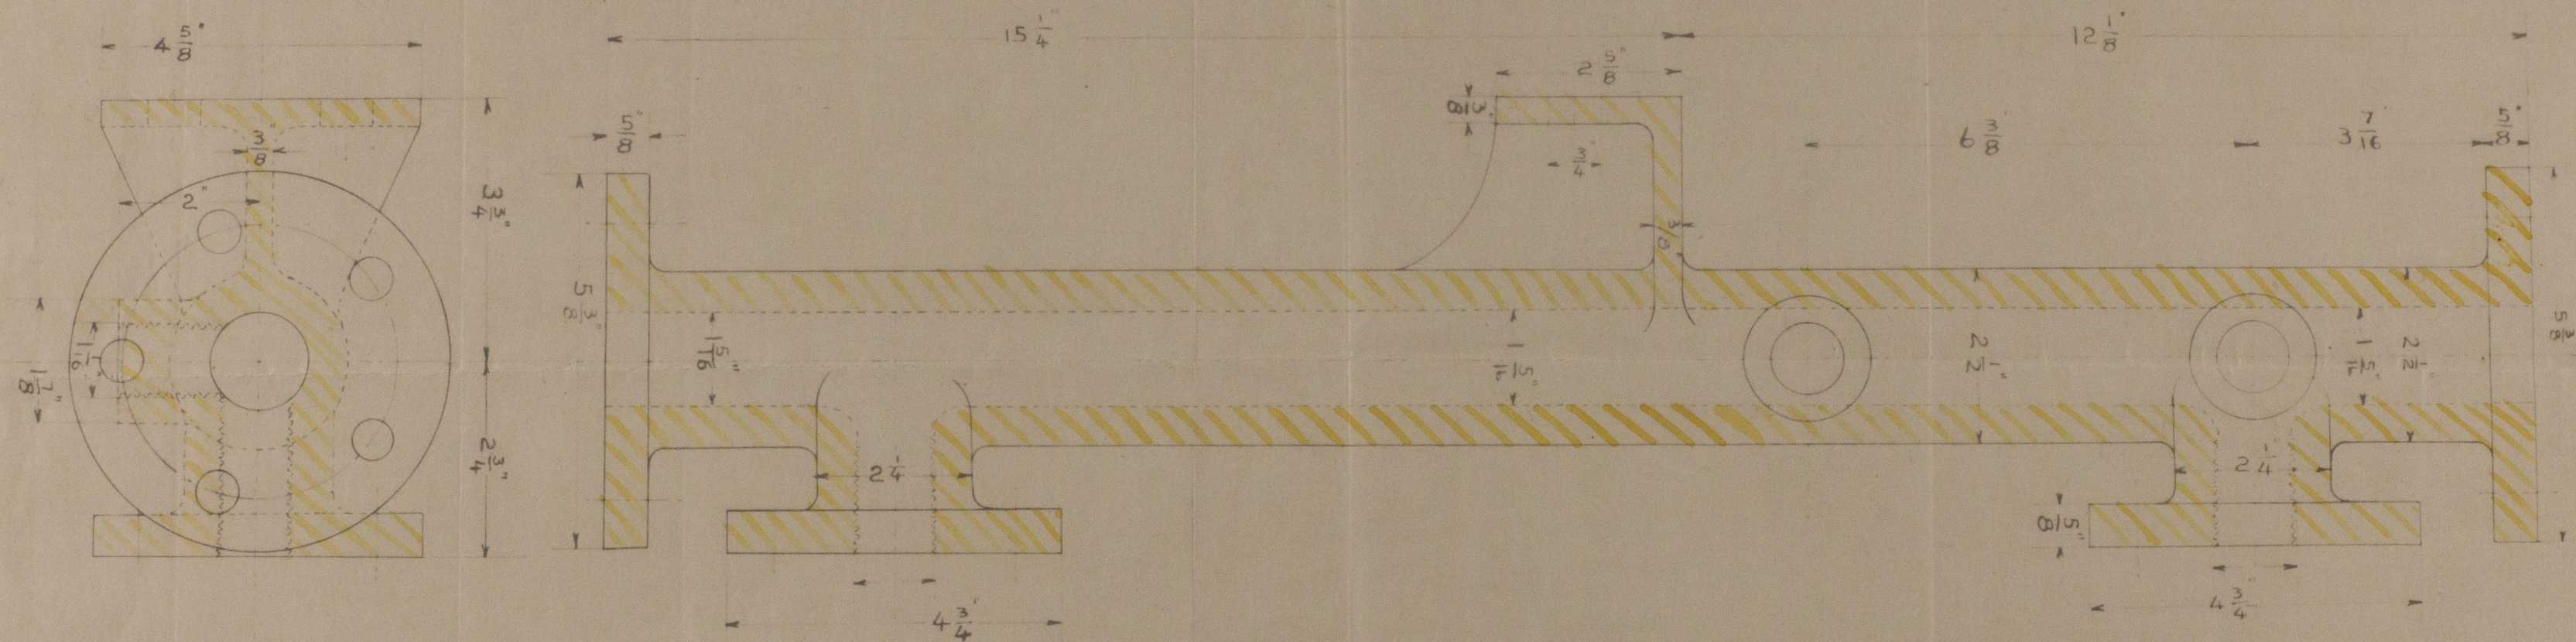



VAPOR "CRISTOBAL COLON"

COLUMNA

ESCALA 6"=1


— BRONCE —

PESO (LABRADO) 17¹⁰⁰ KGS

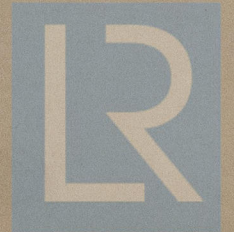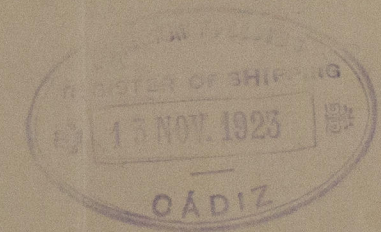

© 2020
Lloyd's Register
Foundation
W 106-0107

W506-0107

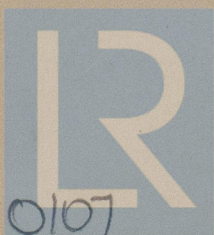

© 2020

Lloyd's Register
Foundation