

Lloyd's Register of Shipping.

(Report on Vessel No. 6272 Port HongKong)

No. 243 SHIP FORGINGS ~~OR~~ CASTINGS.

I have to report that the undermentioned Iron ~~or Steel~~ Forgings ~~or~~ Castings, manufactured by W. S. Bailey & Co. Ltd of HongKong for the Vessel No. 243, being built by W. S. Bailey & Co. Ltd of HongKong have been inspected by me as set forth below and found to be, so far as can be seen, sound & free from defects

Report on Forgings or Castings.

Lloyd's


No. 243
18/11/27
T.S.M.

HongKong, 18th Nov. 1927

J. Morrison

	STERN FRAME.	RUDDER ^{Stock} FRAME.	STEM.
Material*	<u>Iron Scrap</u>	<u>Iron Scrap</u>	<u>Iron Scrap</u>
How made	<u>Forged</u>	<u>Forged</u>	<u>forged</u>
Annealed	<u>Yes</u>	<u>Yes</u>	<u>Yes</u>
Dimensions	<u>As per plan</u>	<u>3 1/2" diam.</u>	<u>5 1/4" x 1"</u>
Progress on Inspection	<u>Forged, annealed & machined</u>	<u>Forged, annealed & finished</u>	<u>Forged, annealed & drilled</u>
When Inspected	<u>Oct. 24, 28, Nov. 4th & 18th 1927</u>	<u>Nov. 4, 16 & 18th 1927</u>	<u>Oct. 24, 28, Nov. 4th & 18th 1927</u>
CASTINGS.			
Tests on Standard Test Pieces.			
Tensile Test—			
Tons per square inch	<input checked="" type="checkbox"/>	<input checked="" type="checkbox"/>	<input checked="" type="checkbox"/>
Extension per cent.	<input checked="" type="checkbox"/>	<input checked="" type="checkbox"/>	<input checked="" type="checkbox"/>
Bending Test—			
Angle before fracture	<input checked="" type="checkbox"/>	<input checked="" type="checkbox"/>	<input checked="" type="checkbox"/>
Drop Test—			
Height from ground	<input checked="" type="checkbox"/>	<input checked="" type="checkbox"/>	<input checked="" type="checkbox"/>
Hammering Test—	<input checked="" type="checkbox"/>	<input checked="" type="checkbox"/>	<input checked="" type="checkbox"/>
If made according to Rules and found satisfactory ...	<input checked="" type="checkbox"/>	<input checked="" type="checkbox"/>	<input checked="" type="checkbox"/>

SKETCHES OF FRAMES SHOWING POSITION AND DESCRIPTION OF WELDS OF FORGINGS.

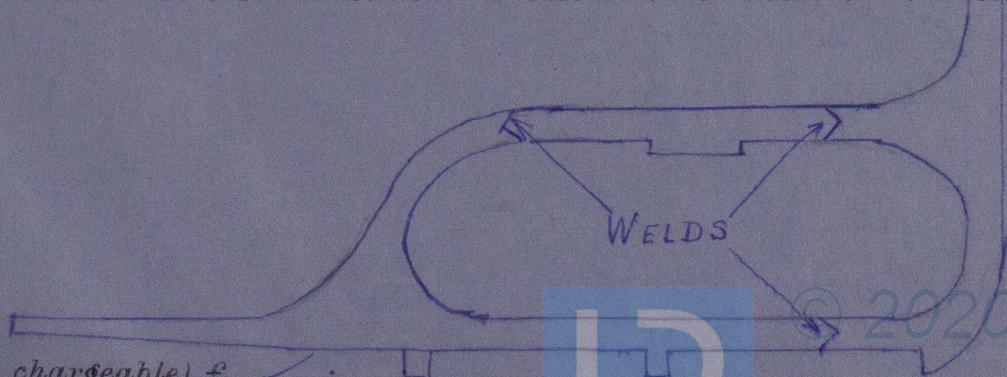

Fee (if any chargeable) £ ✓ :

To be paid at ✓



© 2020

Lloyd's Register
Foundation

W506-0214

21 01 11 00: 10 00 000 001 00 0000

PT 11N



© 2020
Lloyd's Register
Foundation