

10 NOV 1928

Lloyd's Register of Shipping.

SURVEYS FOR FREEBOARD.—STEAM SHIPS.

PARTICULARS RELATING TO ALL STEAM SHIPS EITHER FLUSH DECKED, OR WITH TOP GALLANT FORECASTLES, SHORT POOPS AND BRIDGE HOUSES DISCONNECTED, OR WITH TOP GALLANT FORECASTLES HAVING LONG POOPS, OR RAISED QUARTER DECKS CONNECTED WITH BRIDGE HOUSES, OR OTHERWISE.

Port of Survey NEWCASTLE-ON-TYNE

Date of Survey 9th Nov 1928

Name of Surveyor J. Macdonald

Ship's Name. <u>QUARRINGTON COURT.</u>	Port of Registry and Nationality.	Official Number. <u>160614</u>	Gross Tonnage.	Date of Build. <u>1928</u>	Particulars of Classification. <u>1-100A1 with freeboard (Contemplated)</u>
---	-----------------------------------	-----------------------------------	----------------	-------------------------------	--

Registered Length from Register. <u>420</u>	BREADTH. <u>56.5</u>	DEPTH. <u>33.8</u>	UNDER DECK TONNAGE. <u>6562.64</u>
Length on LOADLINE. <u>420</u>	Frame Depth Rule <u>12</u> <u>6</u> <u>6</u>	No. Ceiling + <u>.20</u> Sheer + <u>.37</u>	Peak Tank <u>+6.30</u> <u>+6.95</u> <u>-1.50</u>
Corrected Lengths. <u>420</u>	<u>55.5</u>	<u>34.37</u>	<u>6560.89</u>

Moulded Depth as measured 36'-4 1/2"
 Rulewood deck less stringer - 3 1/2"
36-1" use

Addition for Keel below base line for draught record.....inches.

NOTE.— If the depth is measured when vessel is afloat, the details of measurement should be reported.

CORRECTION FOR LENGTH

Length of Ship on Loadline.....	<u>420</u>
Length in Table	<u>433</u>
Difference	<u>13</u>
Correction for 10ft., Table A.	<u>1.7</u> Table C.
× Difference divided by 10	<u>2.21</u> (if required.)
If 1/10ths length covered divide by 2	<u>-2 1/4</u>

CORRECTION FOR IRON DECK.

Proportion covered, if less than 1/10ths length covered	
Thickness of usual wood deck, less stringer	<u>in moulded depth</u>

CORRECTION FOR ROUND OF BEAM.

Breadth at Gunwale amidships.....	<u>53.5</u>
Round of Beam	<u>13</u>
Normal round.....	<u>13.37</u>
Difference	<u>.37 ÷ 2 = .18</u>
Proportion of Deck uncovered (Para. 19)	<u>1/4</u>

NOTE.— The round of beam should be reported on the full breadth of vessel at the gunwale.

Efficient of fineness..... .82
 Modification necessary [Para. 4 (a) to (e)]* .02 C.D.B
 Efficient as corrected80

Mean Sheer { Stem..... 96
 Sternpost ... 42 } 138 ÷ 2 = 69 ... Mean

Mean Sheer at 1/4 of the length from { Stem 48
 Sternpost 24 } 72 ÷ 2 = 36 ... Mean

Standard mean Sheer [Table, Para. 18] 65.445 Correction .55-65.445
 Difference..... 13.445 ÷ 4 = 3.356

If limited as Para. 18 (f) -3 1/4

Rise in Sheer { At front of bridge house.....
 Para. 18 (e) } At amidships ✓
 { At after end of forecastle

Fall in Sheer {
 Para. 18 (d) } ÷ 2 = ✓
 Length uncovered

ALLOWANCE FOR DECK ERECTIONS:—

Freeboard, Table C..... ✓
 Correction for Length, if required (Para. 12, 13, and 14) ✓
 Freeboard by Table A, corrected for sheer, and for length, if required (Para. 12, 13, and 14) }
 Difference

Percentage as below.....

Correction for R. Q. Dk. if engine and boiler openings not covered by bridge house (Para. 11) }
 Allowance for Deck Erections

	Length.	Length allowed.	Height.
Forecastle.....	<u>41'-7"</u>		<u>7'-6"</u>
Bridge House			
Raised Qr. Dk.....		✓	
Op.....			
Total			
Length of Ship			
Responding percentage { Para. 11, 12, 13, or 14 } FREEBOARD recommended amidships from centre of Disc to top of Statutory Deck Line, Wood (Steel) Deck:—			

Fresh Water Line	above centre of Disc	...	6"
Indian Summer Line	" " "	...	6"
Winter Line	below " "	...	6"
Winter North Atlantic Line	" " "	...	6"

Freeboard, Table A	<u>10'-2 1/2"</u>
Correction for Sheer	<u>- 3 1/4"</u>
Correction for Length	<u>9-11 1/4"</u>
Allowance for Deck Erections	<u>- 2 1/4"</u>
Correction for Round of Beam.....	<u>9-9"</u>
Correction for fall in Sheer (if any).....	✓
Correction for Steel Deck (if required).....	✓ <u>+ 1/4"</u> <u>9-9 1/4"</u>
Additions for non-compliance with provisions of Para. 11 (d) and (e) †	
Other Corrections (if any) <u>For scantlings. The correspond to approved Summer Moulded draft of 26'-10"</u>	<u>+ 3 1/4"</u> <u>10-0 3/4"</u>
Winter Freeboard	<u>10-0 3/4"</u>
Summer Freeboard	<u>9-6 3/4"</u>
Indian Summer Freeboard	<u>9-0 3/4"</u>
N. A. Winter Freeboard	✓


Correction necessary because clearside amidships, measured in accordance with the Statute is not taken at the intersection of the wood or steel deck with side. + 1 3/4"

Winter Freeboard from deck line	<u>10'-2 1/2"</u>
Summer " " " "	<u>9-8 1/2"</u>
Indian Summer " " " "	<u>9-2 1/2"</u>
N. A. Winter " " " "	✓
Wood (Steel) Deck:—	<u>9-8 1/2"</u>
...	<u>6"</u>
...	<u>6"</u>
...	<u>6"</u>

† If the frames, skin planking, or ceiling are of unusual thickness the breadth of vessel to inside of ceiling should be reported if possible.
 ‡ In vessels obtaining an allowance for deck erections under Para. 11 where the sheer drops abaft amidships the height of the R.Q.D. is to be taken from the level of the top of the amidship beam.
 § In flush-decked vessels the total standard mean sheer means the sheer measured at the stem and sternpost. In vessels having poops and forecastles, it means the sheer measured at points distant one-eighth of the vessel's length from stem and sternpost.

† State dimensions of freeing port area on back of this form.
 ‡ The Surveyor should state whether the fall in sheer as reported is measured relatively to the straight line of keel or to the water line. If measured relatively to water line the vessel's draft at time of survey, and also the usual load draft forward and aft, should be reported.

W507-0211

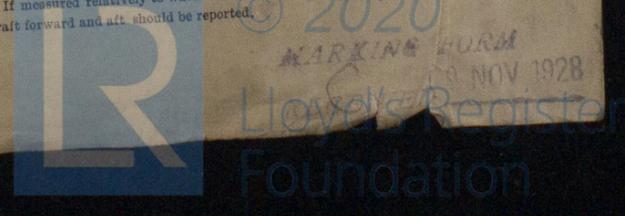

Do all the Frames extend to the top height in the Poop? Raised Quarter Deck? Bridge House? Forecastle?

To what height do the Reverse Frames extend? *Bulk angle frames*

Has the Poop or Raised Quarter Deck an efficient Iron Bulkhead at the fore end?

Give particulars of the means for closing the openings in Bulkhead

Is the Poop or Raised Quarter Deck connected with the Bridge House? Has the Bridge House an efficient Bulkhead at the fore end?

Give particulars of the means for closing the openings in Bulkhead

What is the thickness of the Bridge Front plating? and Coaming plate?

Give scantlings and spacing of the Stiffeners

Are bracket plates fitted at each end of the Stiffeners? Are hor'l. brackets fitted connecting Bridge Bulk'd. with Bulwarks?

Has the Bridge House an efficient Iron Bulkhead at the after end?

How are the openings closed?

Is the Forecastle at least as high as the main or top-gallant rail? *yes* Has the Forecastle an efficient Iron ~~or Wood~~ Bulk'd. at after end? *yes*

Are the Engine and Boiler openings covered by a Bridge, Poop, Raised Quarter Deck, or enclosed by a Strong Iron or Steel Deckhouse? *yes*

If the openings are not so protected are the exposed parts of the Casings efficiently constructed?

Give thickness of plating; scantlings and spacing of Stiffeners

What is the height of the exposed Casings? Are suitable means provided for closing all openings in them in bad weather?

Are the Weather Deck Hatchways efficiently constructed and at least equal to the requirements of Section 28 of the Rules for 1904-5? Give particulars below:— *yes*


Position and Size.	N ^o 1 = 30'-4" x 20'-0"		N ^o 2 = 30'-4" x 20'-0"		N ^o 3 = 14'-0" x 18'-0"		N ^o 4 = 30'-4" x 20'-0"		N ^o 5 = 30'-4" x 20'-0"	
	Ship.	Rule.	Ship.	Rule.	Ship.	Rule.	Ship.	Rule.	Ship.	Rule.
COAMING.	Height above top of DECK	2'-7"	2'-7"		2'-7"		2'-7"		2'-7"	
	Thickness	Sides	.44	.44	.44		.44		.44	
		Ends	.44	.44	.44		.44		.44	
SHIFTING BEAMS OR WEB PLATES.	Number	5	5	2	5	5	5	5	5	
	Section and Scantlings	11 1/2 x 18'-9" x 36	Same as N ^o 1	11 1/2 x 16'-8" x 34	Same as N ^o 1	11 1/2 x 4'-3" x 44	Same as N ^o 1	Same as N ^o 1	Same as N ^o 1	
	Material	11 1/2 x 4'-3" x 44								
FORE AND AFTERS.	Number	✓	✓	✓	✓	✓	✓	✓	✓	
	Section and Scantlings									
	Material									
HATCHES	Thickness	2 1/2"	2 1/2"	2 1/2"	2 1/2"	2 1/2"	2 1/2"	2 1/2"	2 1/2"	
Remarks										

* The depth of Fore and Afters should be stated from the underside of the hatches in all cases.
 (If the sill of the lowest side scuttle will be less than 6 inches above the Indian Summer Load Line if assigned under the tables, state vertical distance from top of deck at side amidships to lower edge of lowest side scuttle.)
 The following information is to be given in all Cases of vessels dealt with under Paras. 11, 12 (under 15 feet Moulded depth) and under Shelter Deck Rules.

What is the thickness of the Bridge Sheerstrake? _____ Strake between Main and Bridge Sheerstrakes? _____

Delete the words *The Crew are, are not,* berthed in the bridge house.
 that do not apply. *The arrangements to enable them to get backwards and forwards from their quarters are, are not* satisfactory.

Length of Bulwarks in well _____ Sq. ft.
 Area of Freeing Ports required by Para. 11 (e) each side of vessel = _____ Sq. ft.
 Ft. Tenths. Ft. Tenths. No. } Freeing Ports (each side of vessel) = _____ Sq. ft.
 × × }
 × × }
 Total deficiency or excess = _____ Sq. ft.

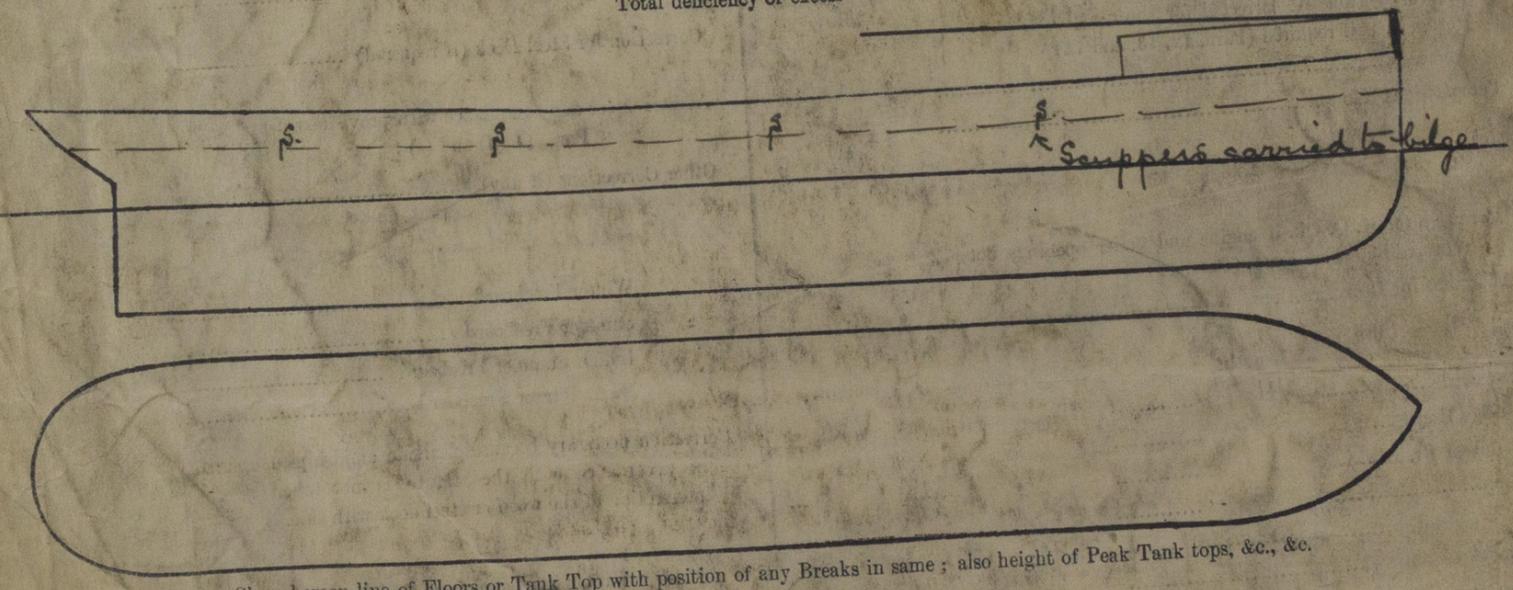

Show hereon line of Floors or Tank Top with position of any Breaks in same; also height of Peak Tank tops, &c., &c.

State any special features in the construction of the Vessel *100 A1 with freeboard.*

Builder's name and yard number *Northumberland S. M. Co. (1927) Ltd N^o 406*

Names of sister vessels *"Geddington Court" but tonnage opening permanently closed see Secretary's letter 7/12/27*

Owners *United British S. S. Co. Ltd (Haldin Ho - Ltd Mgrs)*

Address *London.*

Estimated Fee £ *11 : 0 : 0* Received by me *See L.C. Report.*

