


15/11/11



Pitch of stays from wing firebox to shell on approved plan is $8\frac{3}{4} \times 8\frac{3}{4}$ arranged in irregular rows. It is proposed to arrange the lower stays in regular rows making the pitch $12\frac{1}{16} \times 6$ so that they will clear the firebox landing which is being lowered to suit

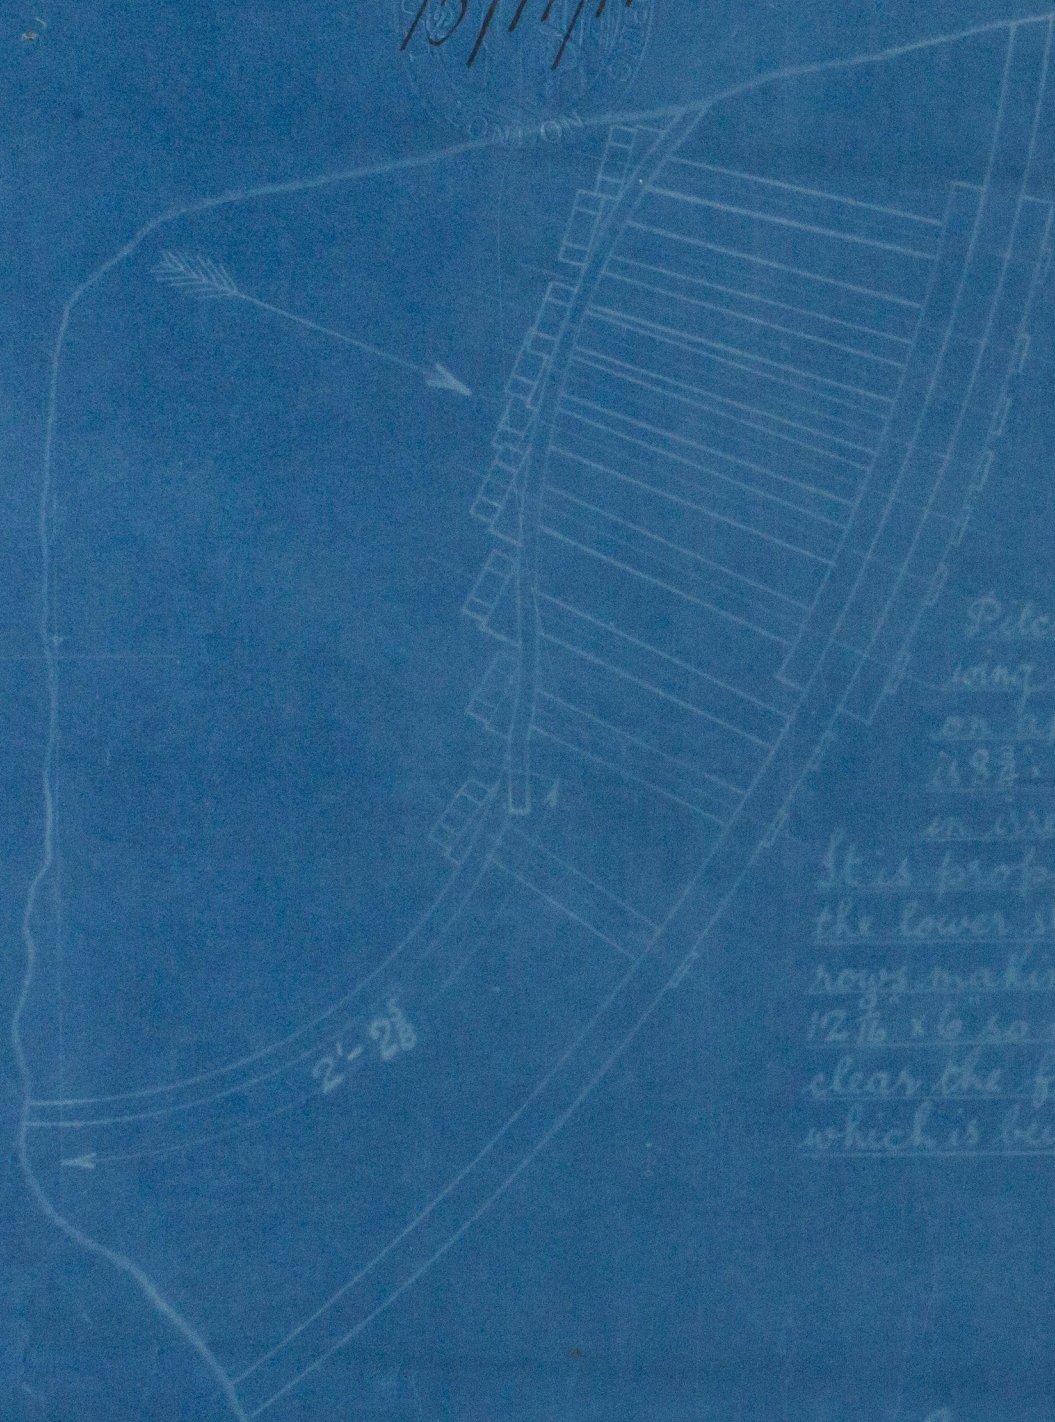

View looking in direction of arrow


Amended position of Screwed Stays from Wing Firebox to Shell

- Main Boiler -

- Cont. No. 575 -

- Scale $1\frac{1}{2}$ = one foot -

J. R. J.
15-11-11
18/11/11

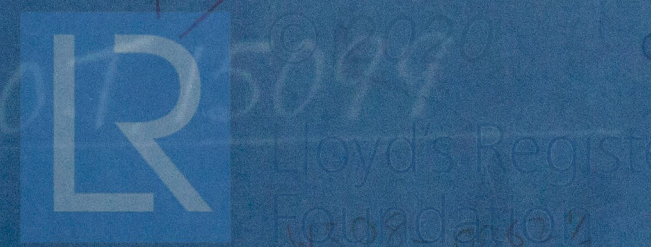

J. HALDEN &
2704

V568-00621~



© 2020

Lloyd's Register
Foundation

From DAVID ROWAN & CO., GLASGOW.
ENCLOSURE

FOR

Messrs Lloyds Registry

W508-00622/2