

PROFILE & DECK PLANS

LENGTH B.P. 408'-0" BREADTH M^{LD} 54'-9" DEPTH M^{LD} 29'-2"


SCALE $\frac{1}{8}" = 1 \text{ FOOT}$

"SHERWOOD" SYSTEM (PATENT)

W508 - 0063

Proble 12
Amended map

238
238

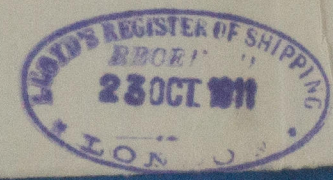

TRANS BERM 20' x 40'
FACE BAR 11' x 3 1/2' x 70' 8"

BALLAS

12'-0"

GER. 44

POOP FRONT

30'

S.S. No 238.

Profile & Deck.

Wm Hamilton & Coy.
convict.

Ss. Colusa
Greenock Report No. 16408.



RETAIN

W508 - 0063



© 2020

Lloyd's Register
Foundation