

For the information of Surveyors and the Committee only.

Received at \_\_\_\_\_ Office, \_\_\_\_\_ 100

# Lloyd's Register of British & Foreign Shipping.

(Report on Vessel No. 24755 Port Hull  
L. Davard)



No. \_\_\_\_\_ SHIP FORGINGS OR CASTINGS.

The words FORGINGS or CASTINGS, IRON or STEEL, should be struck out as may be required.

I have to report that the undermentioned Iron ~~or Steel~~ Forgings ~~or Castings~~, manufactured by J. S. Forster & Sons Ltd. of Sunderland for the Vessel No. 514, being built by Cochrane & Sons of Gilly have been inspected by me as set forth below and found to be, so far as can be seen, sound

Mark on Forgings.


Lloyd's  
No 4641  
me

Matt Robertson


Sunderland, 11-12-11

	STERN FRAME.	RUDDER FRAME.	STEM.
Material*	<u>Scrap Iron</u>	<u>Scrap Iron</u>	/
How made	<u>Forged</u>	<u>Forged</u>	
Dimensions	<u>6 1/2' x 3"</u>	<u>4 1/2' dia to 3 1/2' x 3"</u>	
Progress on Inspection	<u>Forged and</u>	<u>Forged and</u>	
Date when Inspected	<u>Smithed</u>	<u>Smithed</u>	
	<u>2.11.11 to 10.11.11</u>	<u>15.11.11 to 11-12.11</u>	

SKETCHES OF FRAMES SHOWING POSITION AND DESCRIPTION OF WELDS OF FORGINGS, OR PARTICULARS OF TESTS APPLIED TO CASTINGS.

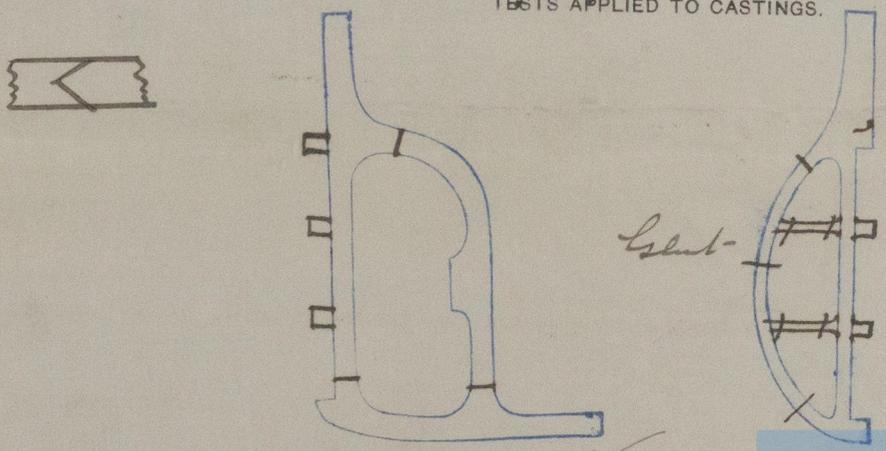

Fee (if any chargeable) £  
To be paid at \_\_\_\_\_

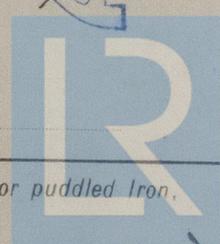

© 2021

Lloyd's Register Foundation

\* If of Iron, state whether scrap or puddled Iron.

W509-0058