


SCALE $\frac{1}{4}$ INCH = ONE FOOT.

2. 10. 11

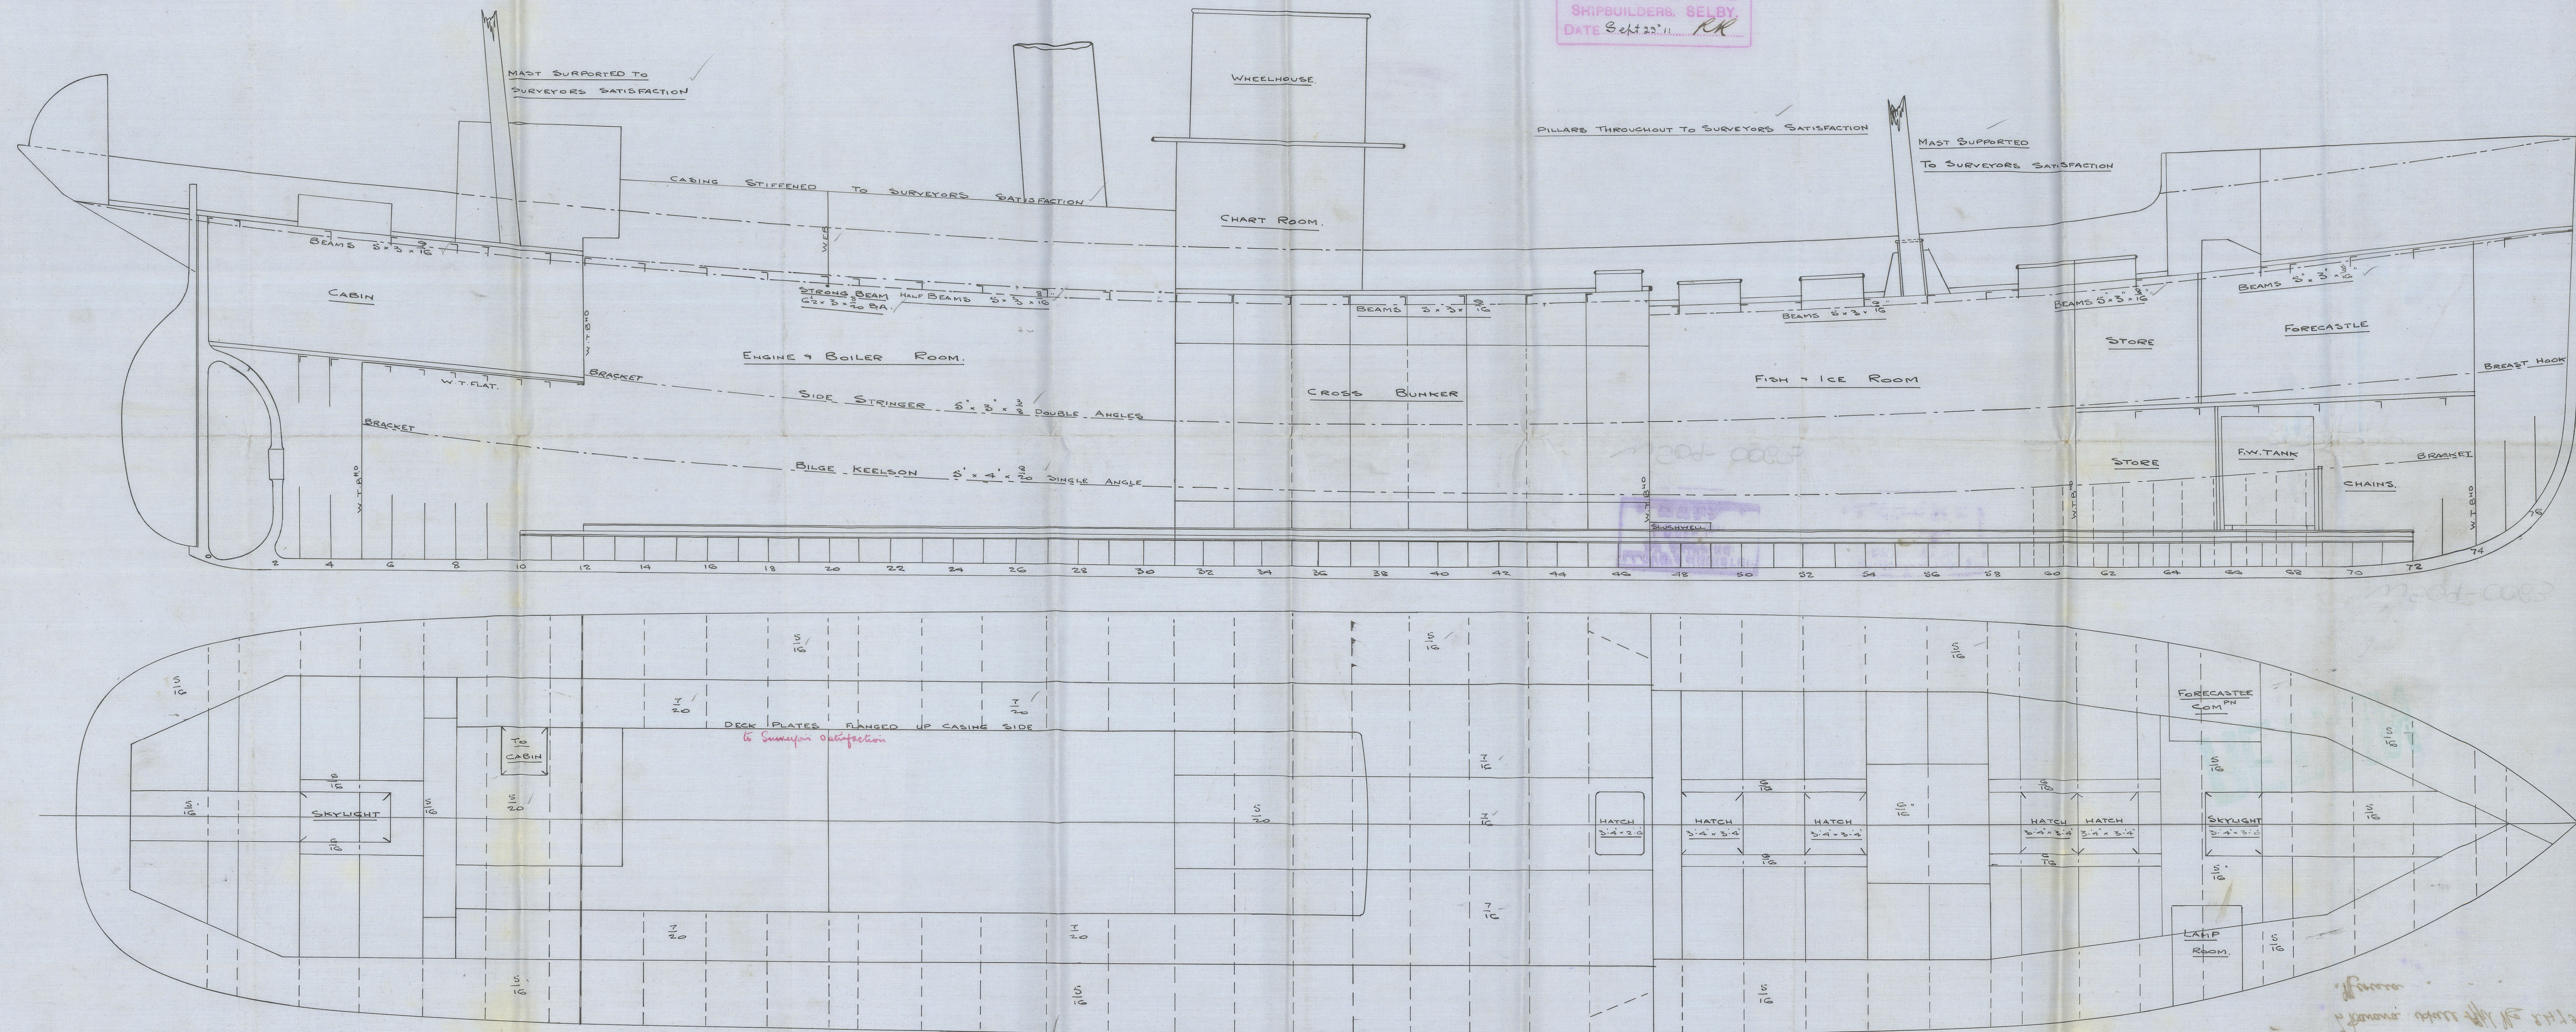

25748 of the 22nd of March 1892

21.1 and 21.2
 21.1 and 21.2

W509-0063
Cochrane & Sons.

N^o 517 and 518.

Profile and Decks

1/2 Davara Hull No 24755.

Mosca . . .

