

work & amended
 212 in 512 07
 material 11/10/11

2.10.11

MIDSHIP SECTION.

STEEL SCREW TRAWLERS.


N^o 517 & 18.

DIM^s 130'-0" x 23'-6" E x 13'-3" M^{LD}

SCALE $\frac{1}{2}$ INCH = ONE FT

PLAN No. 748
 FOR ENCLOSURE TO
 Messrs Lloyd's Surveyors
 Hull FROM
 COCHRANE & SONS,
 SHIPBUILDERS, SELBY.
 DATE Sept 29th 11 RK

TO BE CLASSED 100 A1 AT LLOYDS FOR FISHING
 PURPOSES. ENGINE & BOILER CASING AS
 PREVIOUSLY APPROVED. DECK PLATED OVER IN
 WAY OF MACHINERY SPACE.

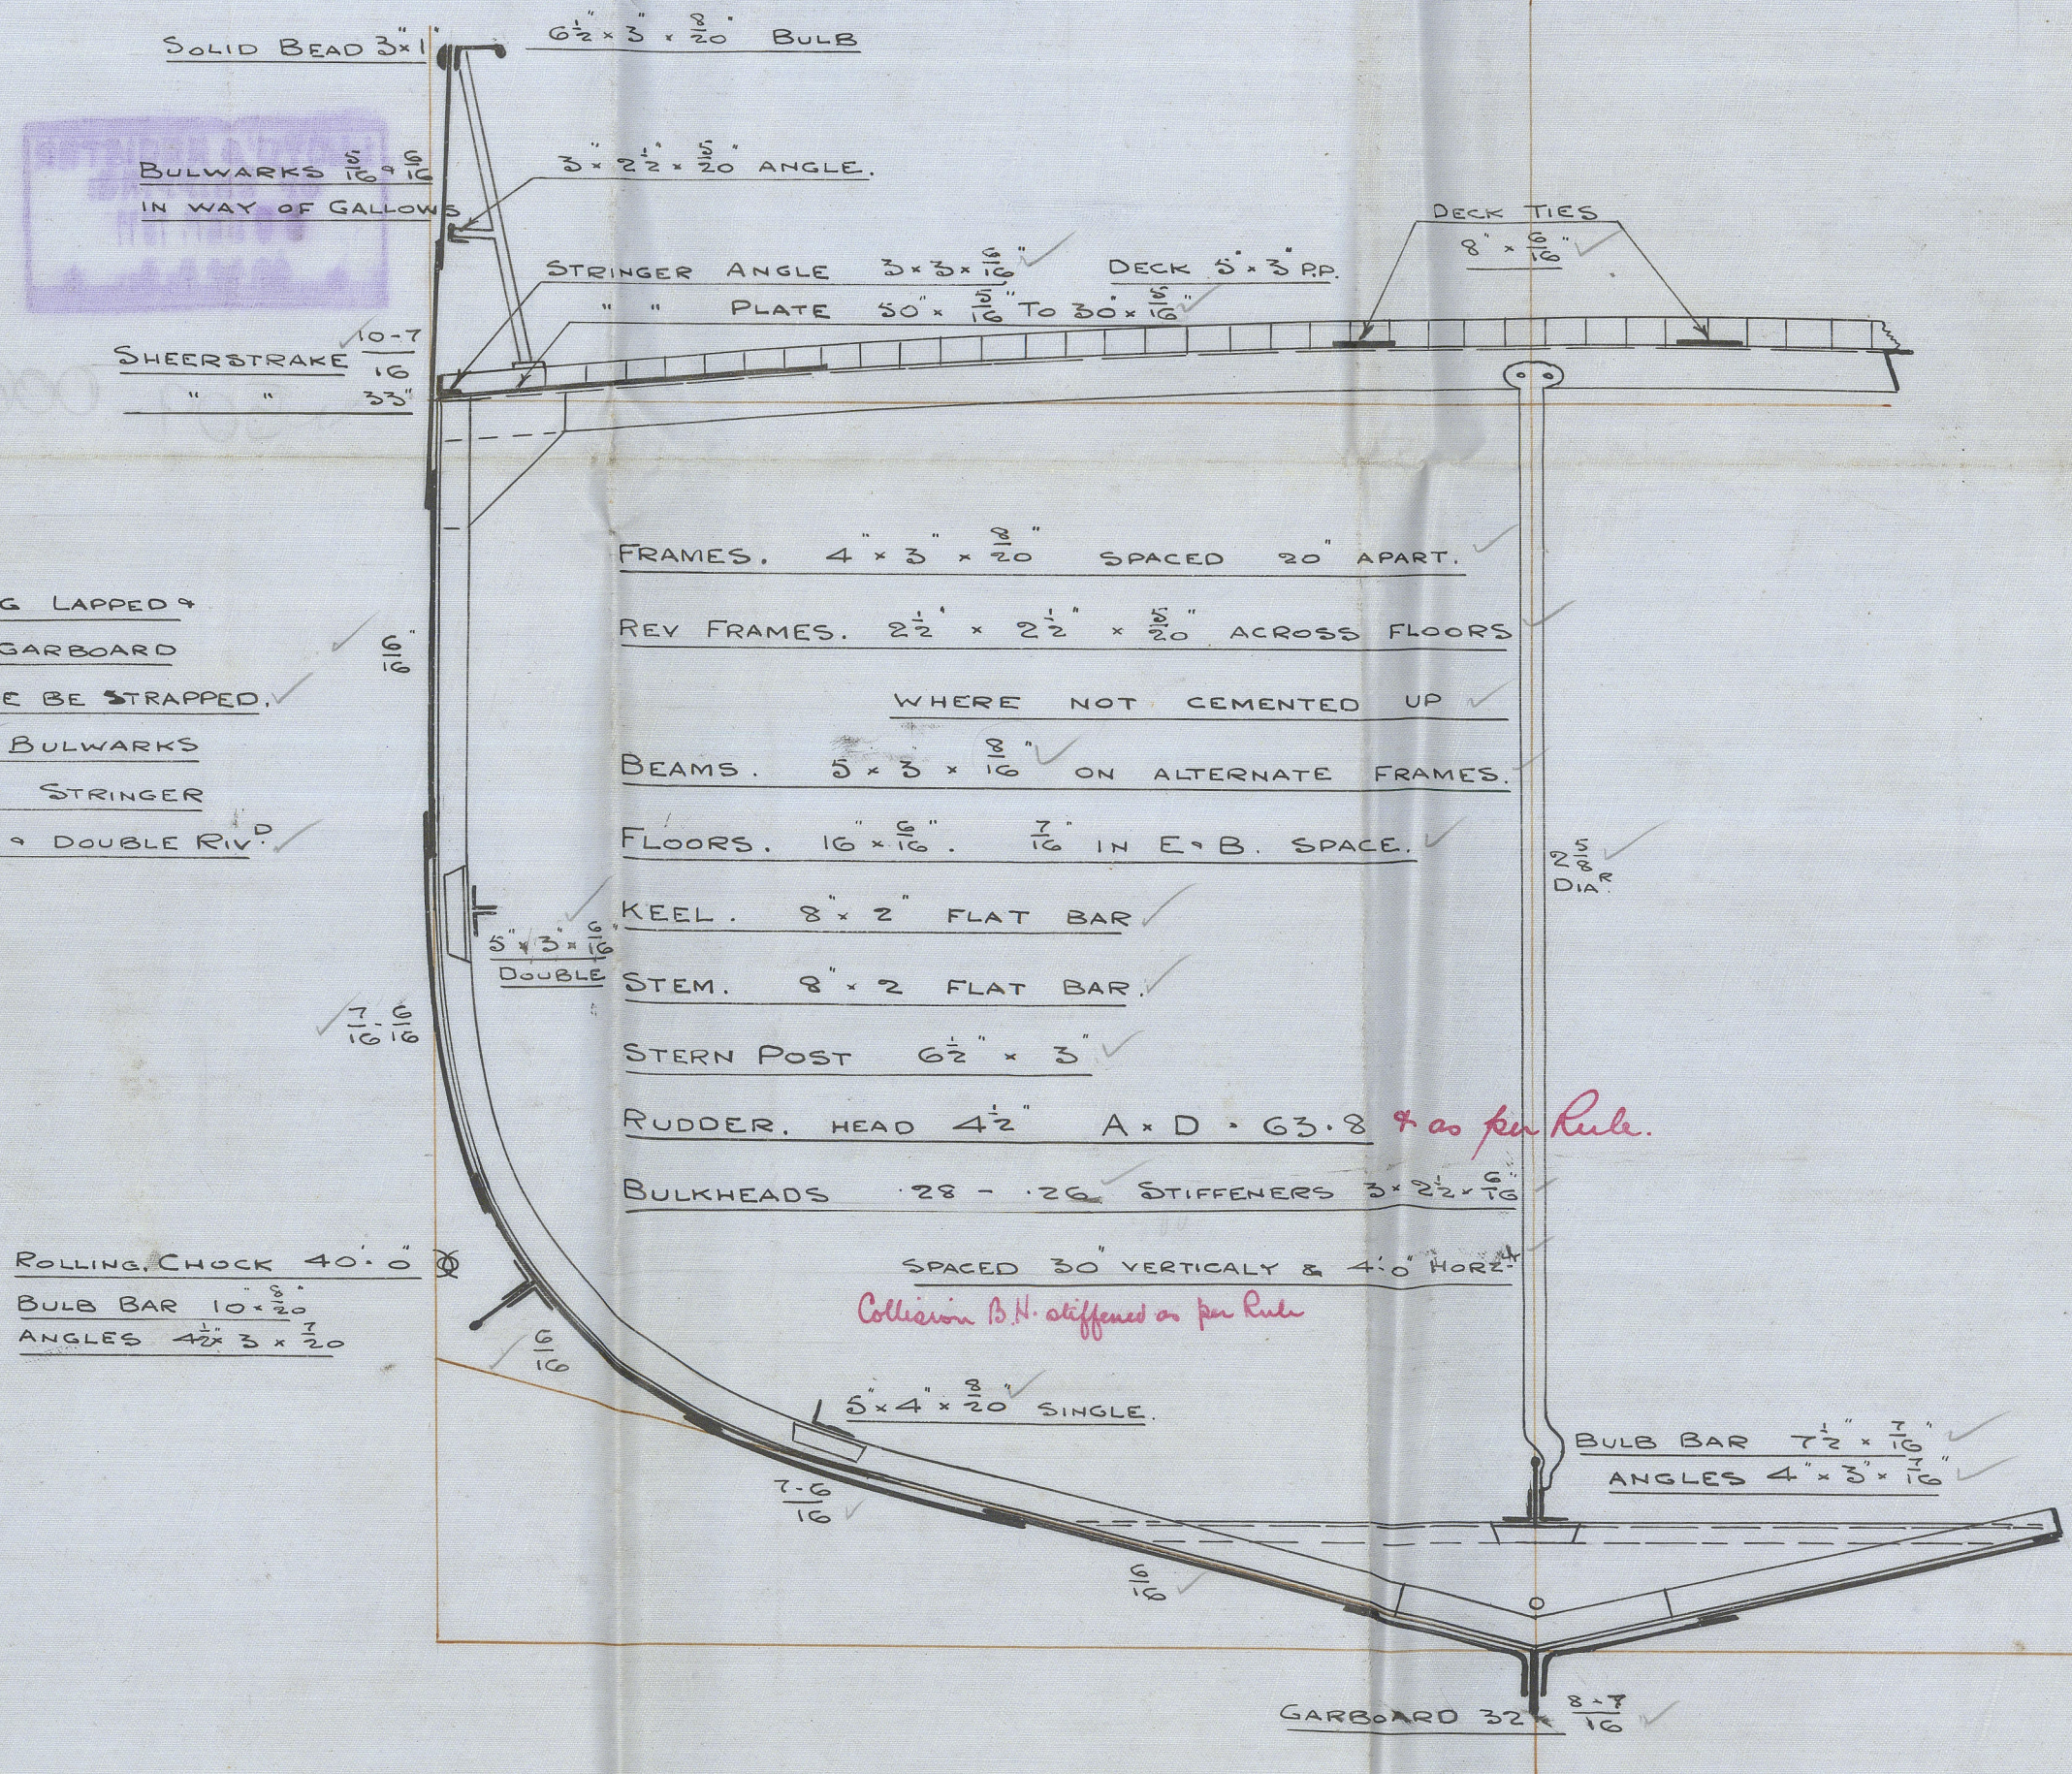

RIVETING.

BUTTS OF SHELL PLATING LAPPED &
 DOUBLE RIVETED, EXCEPT GARBOARD
 & SHEERSTRAKE, WHICH ARE BE STRAPPED.
 LANDINGS DOUBLE RIV^d, BULWARKS
 SINGLE RIV^d BUTTS OF STRINGER
 & TIE PLATES OVERLAPPED & DOUBLE RIV^d

NUMERALS

B + D = 36.62 ✓
 L x (B + D) = 4760.60 ✓

PROPORTIONS

D/B = 5.5 ✓
 D/L = 9.8 ✓

EQUIPMENT

1 st	BOWER ANCHOR	7 1/2 x 3	CWT ^s	EX STOCK
2 nd	"	6 1/2 x 3	"	"
3 rd	"	3	"	"
105	FATHOMS	1 1/2	CABLE	
60	"	6	HAWSER	
60	"	5	WARP.	

JS 2/10/11



Cochrane & Sons.

No: 517 and 518

Midship Section

1/2 Davara Hull Pl No: 24755

Merised

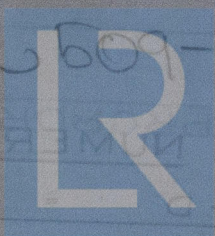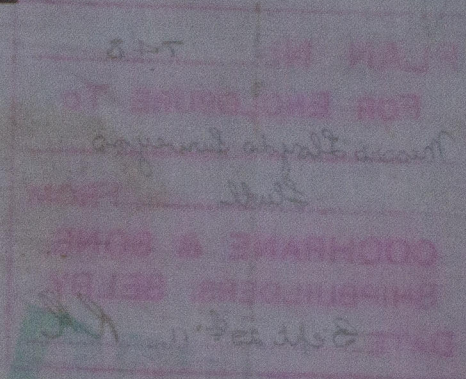

© 2021

Lloyd's Register
Foundation

MIDSHIP

STEEL

No

13

SCA

TO BE CLASS

PURPOSES

PREVIOUSLY

WAY OF M

DECK

2 x 2








