

# MIDSHIP SECTION TO CLASS 100.A.1 AT LLOYDS.

SCALE 1/2" = 1 FOOT.

195'0" B. PERPS. x 32'6" MLD x 13'9" MLD.

Nº 125 SHIP.

EQUIPMENT Nº 12536.7193

20.12.106	2 Bower Anchors Stockless (Each)	19 Cwts	54 1/2 Cwts
19.4.07	1 Stream " Be Stock	5 1/4 "	Collective.
	1 Kedge " "	2 1/2 "	
	210 Fathoms of 1 5/8" Stud Chain Cables		
	60 " " 1 1/2" Stream chain or 3 1/4" Steel Wire		
	90 " " 9" Hemp or 3" "		
	90 " " 6" Hawser or 2 1/4 " "		
	90 " " 5" Warp or 1 3/4 " "		

with Owners consent to steel wire.

Forecastle Deck Beams 7" x 3" x 1/20 Bulb Angles on alternate frames.

Stringer 30" x 5/20  
Angle 3" x 3" x 1/20  
3 1/2" x 3 1/2" x

CHART HOUSE.

1/2 Plate 10" x 6"

3" x 3" x 1/20

Wood Deck 5" x 3" Pitch Pine 3" x 2 1/2" x 1/20

Stringer 36" x 5/20

3" x 3" x 1/20

3 1/2" x 3 1/2" x

Through Beams 5 1/2" x 3" x 1/20 Angles on alternate frames.

Beam Knees 2 1/2" times the depth of Beam

Forecastle Sides 5" Butt straps Double Riveted.

Butt straps Double Riveted Single Riveted on Bulwarks.


Gunwale Bar 3 1/2" x 3 1/2" x 1/20  
Sheerstrake 35" x 1/20 for 1/2 L (Plus 20 for 1/2 L in line)  
Butt straps 2 1/2" thick for 1/2 length  
And treble Riveted, double at ends.

Overlapped quadruple Ribble Double at Ends.  
2-3/4 Rivets through Angle.

Quadruple Ribble Double at Ends Overlapped.

Plus a 20 all fore and aft  
Overlapped Ribble for 1/2 L Double at Ends.

Base plates same thickness as plates and double riveted.  
Bottom strengthened forward according to Rule.  
After End plates same thickness as plates.

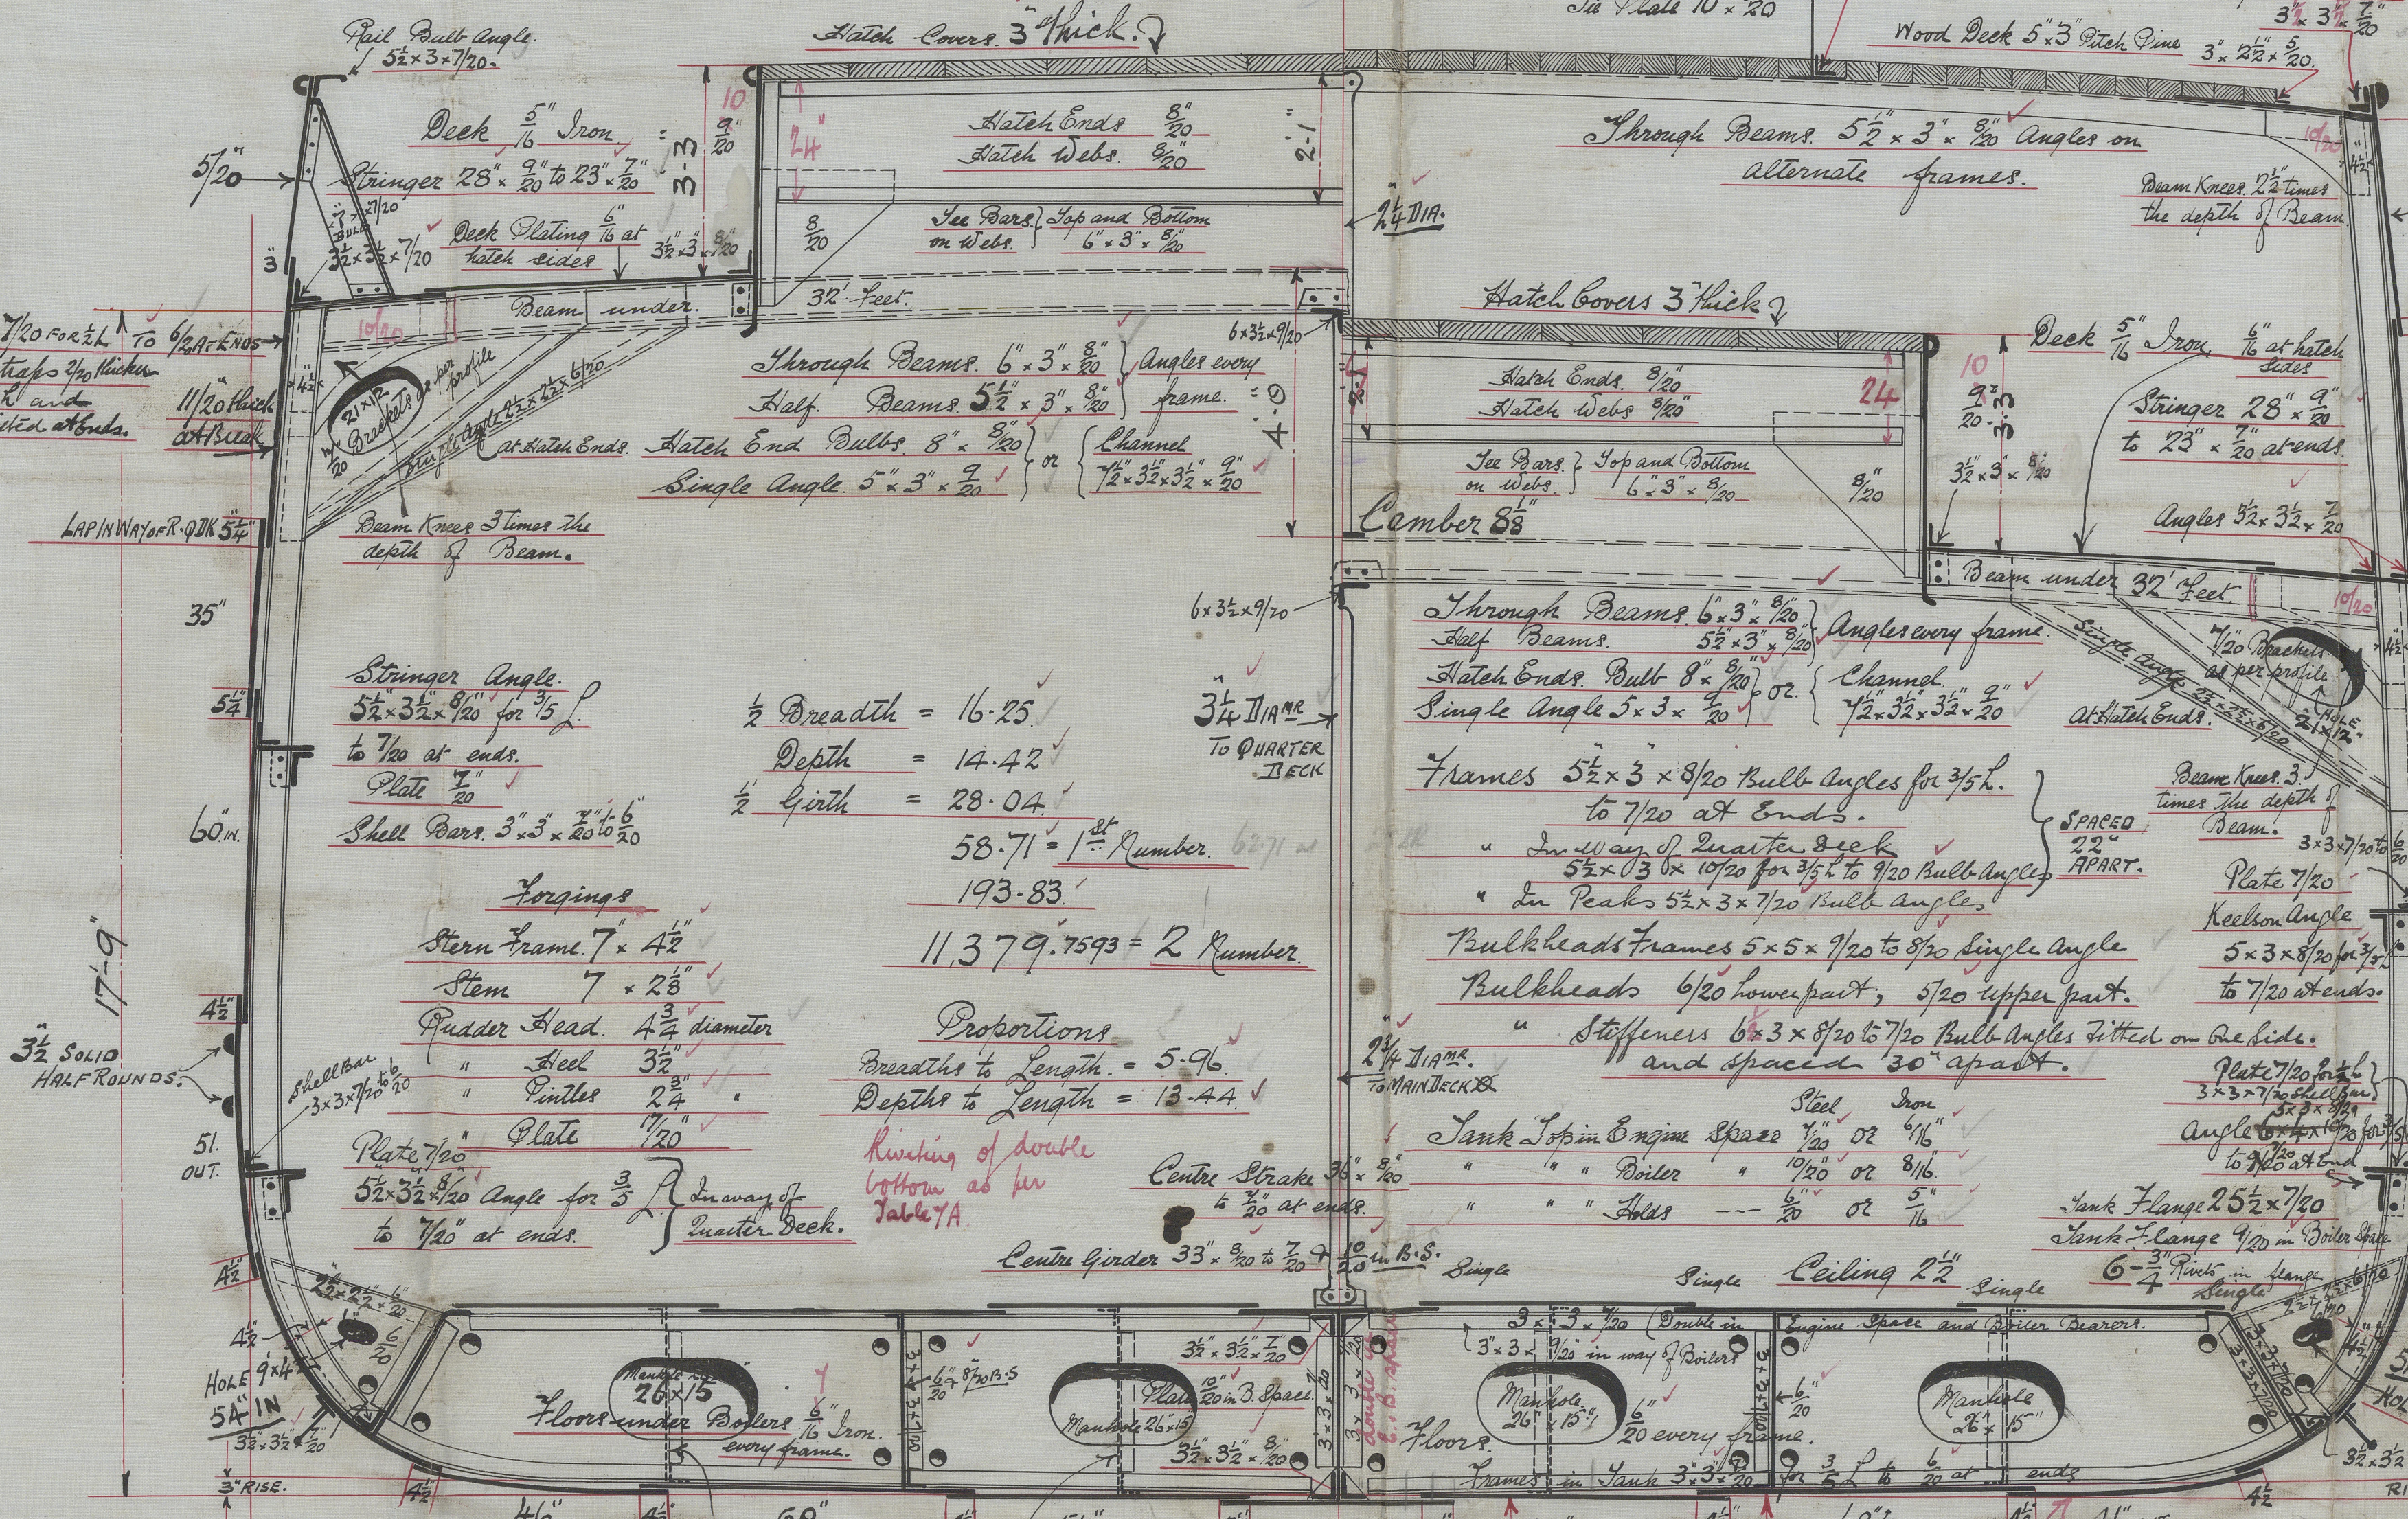

John Brown & Sons Ltd.  
Shipbuilders  
Graham Slipways  
Sunderland.  
Dec 13th/06. A.L.

EXTRA INTERCOSTALS  
IN WAY OF ENGINES.

Flat Plate Keel  
33" x 1/20 to 2 1/2"  
Proposed 4 1/2" x 1/20 for 1/2 L  
Double at ends.  
Butt straps for 1/2 L  
Double at ends.  
Overlaps.

54" IN AND OUT  
20 for 1/2 L  
120 at ends  
Butt straps for 1/2 L  
Double at ends.  
Overlaps.

60" IN AND OUT  
80 for 1/2 L  
120 at ends  
Butt straps for 1/2 L  
Double at ends.  
Overlaps.



Messrs J. Burns & Co

No 125


P.S. <sup>my</sup>Knottley

Sold F.C. No. 23325

W51-0201

1220 B. J. 1882 x 57.6

© 2021

Lloyd's Register  
Foundation