

Rpt. 6.

For the information of Surveyors and the Committee only.

Received at Greenock Office 7. 7. 1920

Lloyd's Register of Shipping.

(Report on Vessel No. 40992 Port Glasgow.)

SHIP FORGINGS OR CASTINGS.

have to report that the undermentioned Iron or Steel Forgings or Castings, manufactured by Messrs R Kerr & Sons Ltd of Glasgow for the Vessel No. 25, being built by Glasgow Shipbuilding Co. Ltd of Glasgow have been inspected by me as set forth below and found to be, so far as can be ascertained, Sound


Lloyd Royal Belge.

30. 6. 20

J Dale
Glasgow

| | STERN FRAME. | RUDDER FRAME. | STEM. |
|-------------|-----------------------------|---------------|-------|
| Section | <u>Scrap iron</u> | | |
| | <u>Forged & Smithed</u> | | |
| | <u>9 x 10 1/2 x 7 1/2</u> | | |
| ected | <u>Forged & Smithed</u> | | |
| | <u>30-6-20</u> | | |
| rd Test | | | |
| ach | | | |
| t. | | | |
| st- | | | |
| ure | | | |
| and | | | |
| it- | | | |
| ig to Rules | | | |
| atisfactory | | | |

ETCHES OF FRAMES SHOWING POSITION AND DESCRIPTION OF WELDS OF FORGINGS.

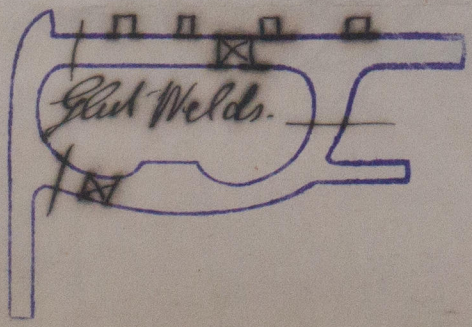


Fee (if any chargeable) £ nil

To be paid at

* If of Iron, state whether scrap or puddled Iron. If of Steel, state whether made on the Open Hearth process.

3m. 12.19 T.

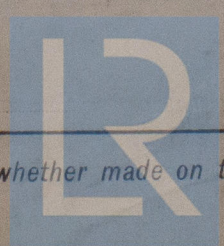

7 5 11
10. 10. 10. 0

Lloyd's Register
Foundation

| | | | | | | |
|--|-------|-------|-------|--------|-------|-------|
| BEAMS, Forecastle Deck, Angle, Bulb Angle, | 10 | 3 1/2 | 6 1/2 | 10 1/2 | 3 1/2 | 5 1/2 |
| Plate, Tee, Bulb, or Channel | 9 1/2 | 3 1/2 | 5 1/2 | 9 1/2 | 3 1/2 | 5 1/2 |

DECK, Material and thickness