


SCALE $\frac{1}{2}$ " = 1 FOOT

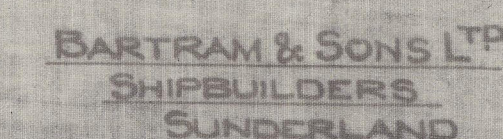

S.S. "Benruines"

Midship Section Scantlings
as fitted in S/S No. 233.


SUNDERLAND RPT. No. 26181

RETAIN



© 2020

Lloyd's Register
Foundation

WS10-0330