

23/1/23





PROFILE & DECK PLANS.

STEEL SCREW STEAMER.

DIMENSIONS: LENGTH BP 212'-0" x 39'-0" B^{MLD} x 21'-0" D^M MLD.

SCALE 1/8" = ONE FOOT.

TO CLASS: 100A1 AT LLOYDS.

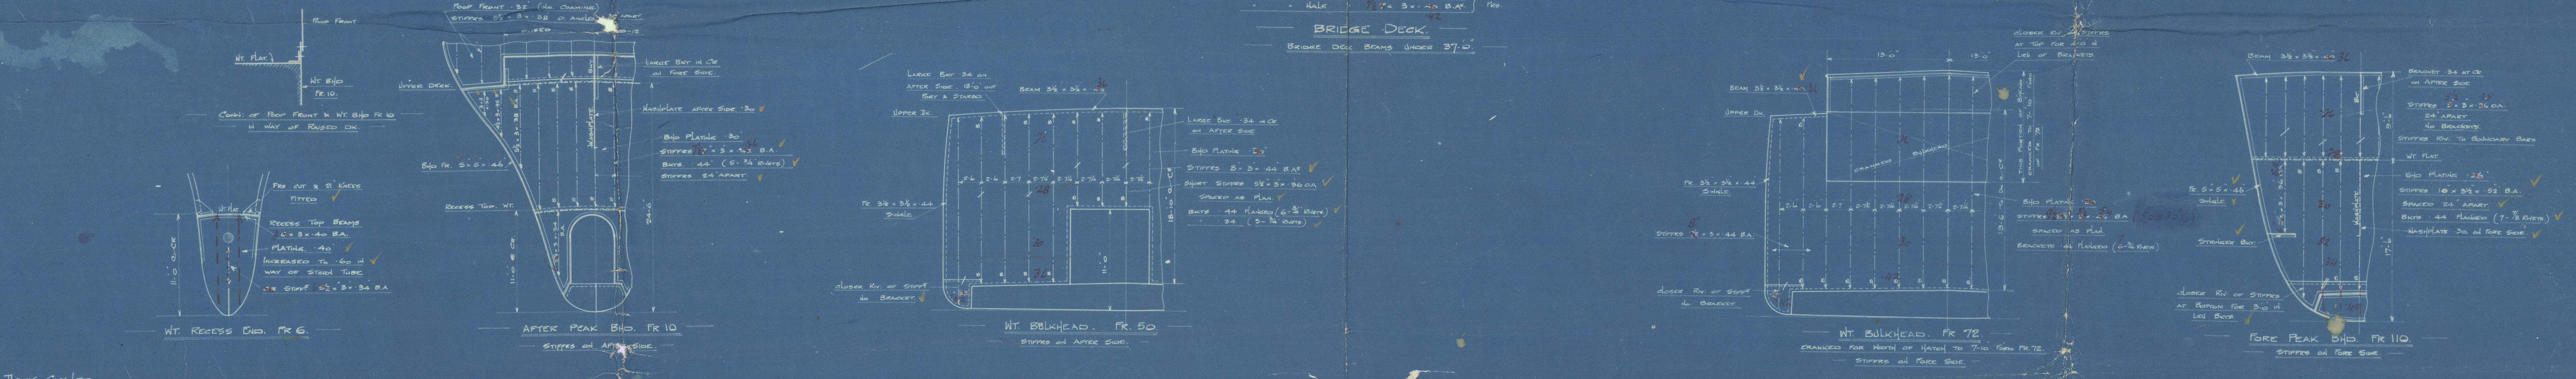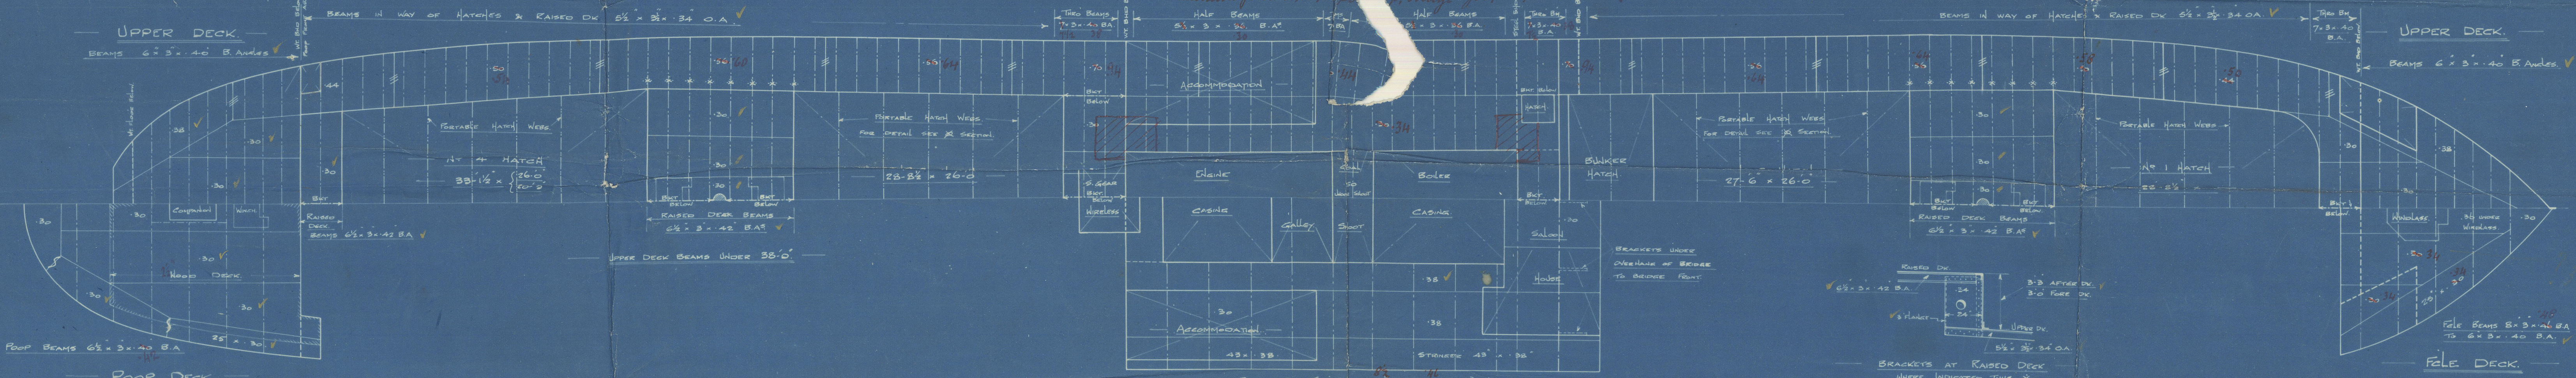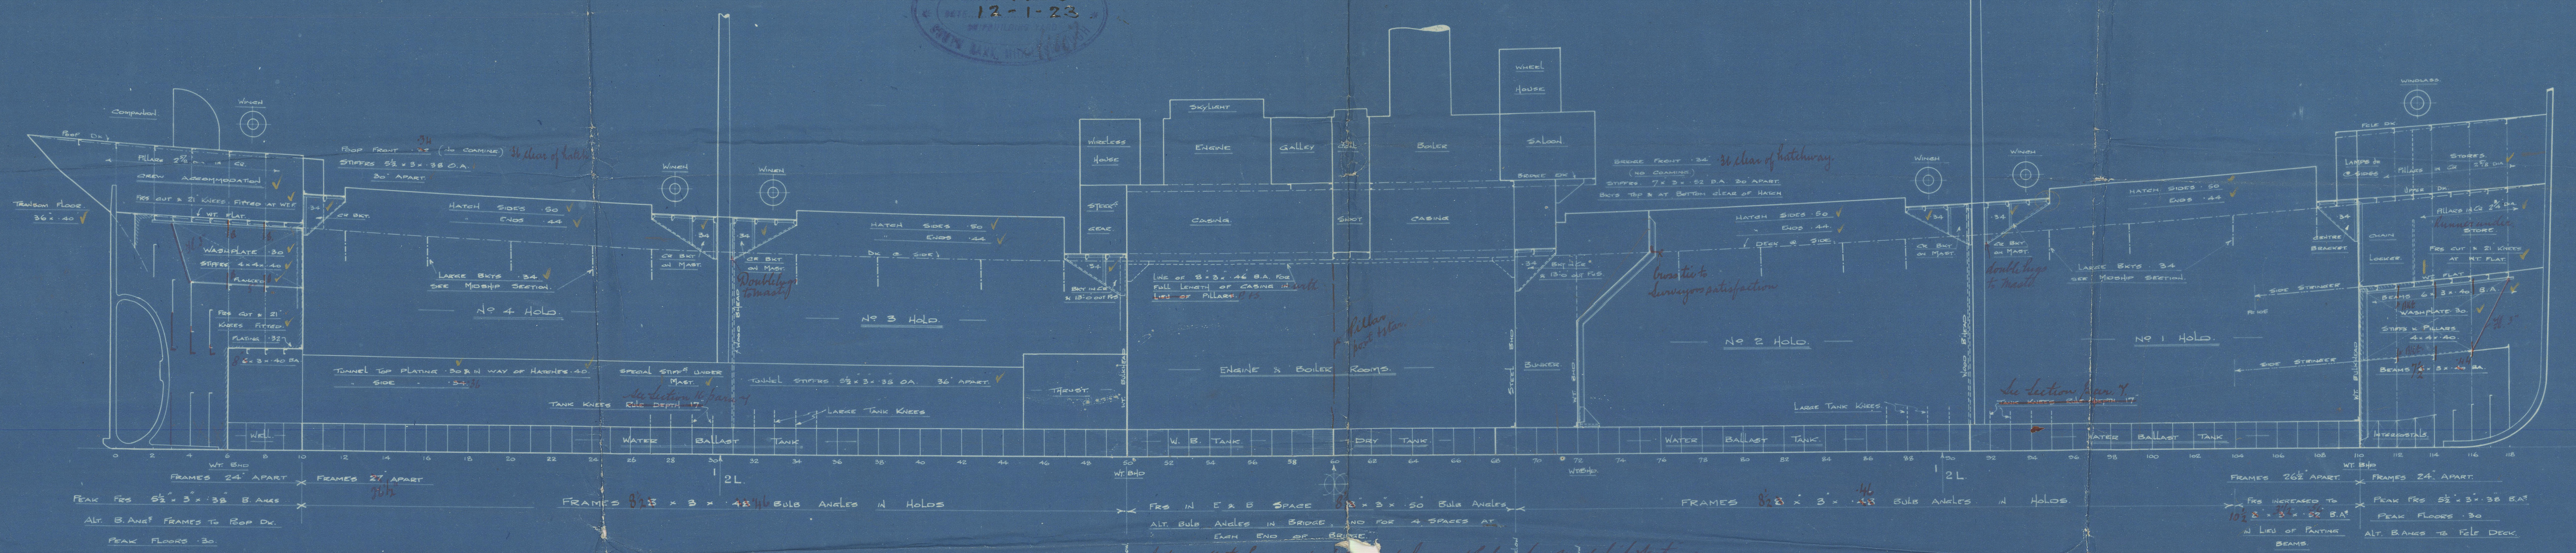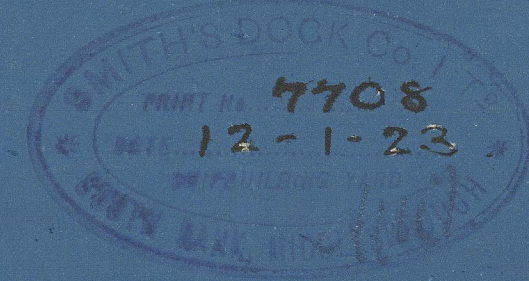


Nº 782.

23/1/23

Smith's Dock Co. Ltd

No. 782.

Profile & D.M. Plans.

S.S. PEGAWAY

MDB. RPT. No. 11954

RETAI

W511-0080 © 2020

R

Lloyd's Register
Foundation