

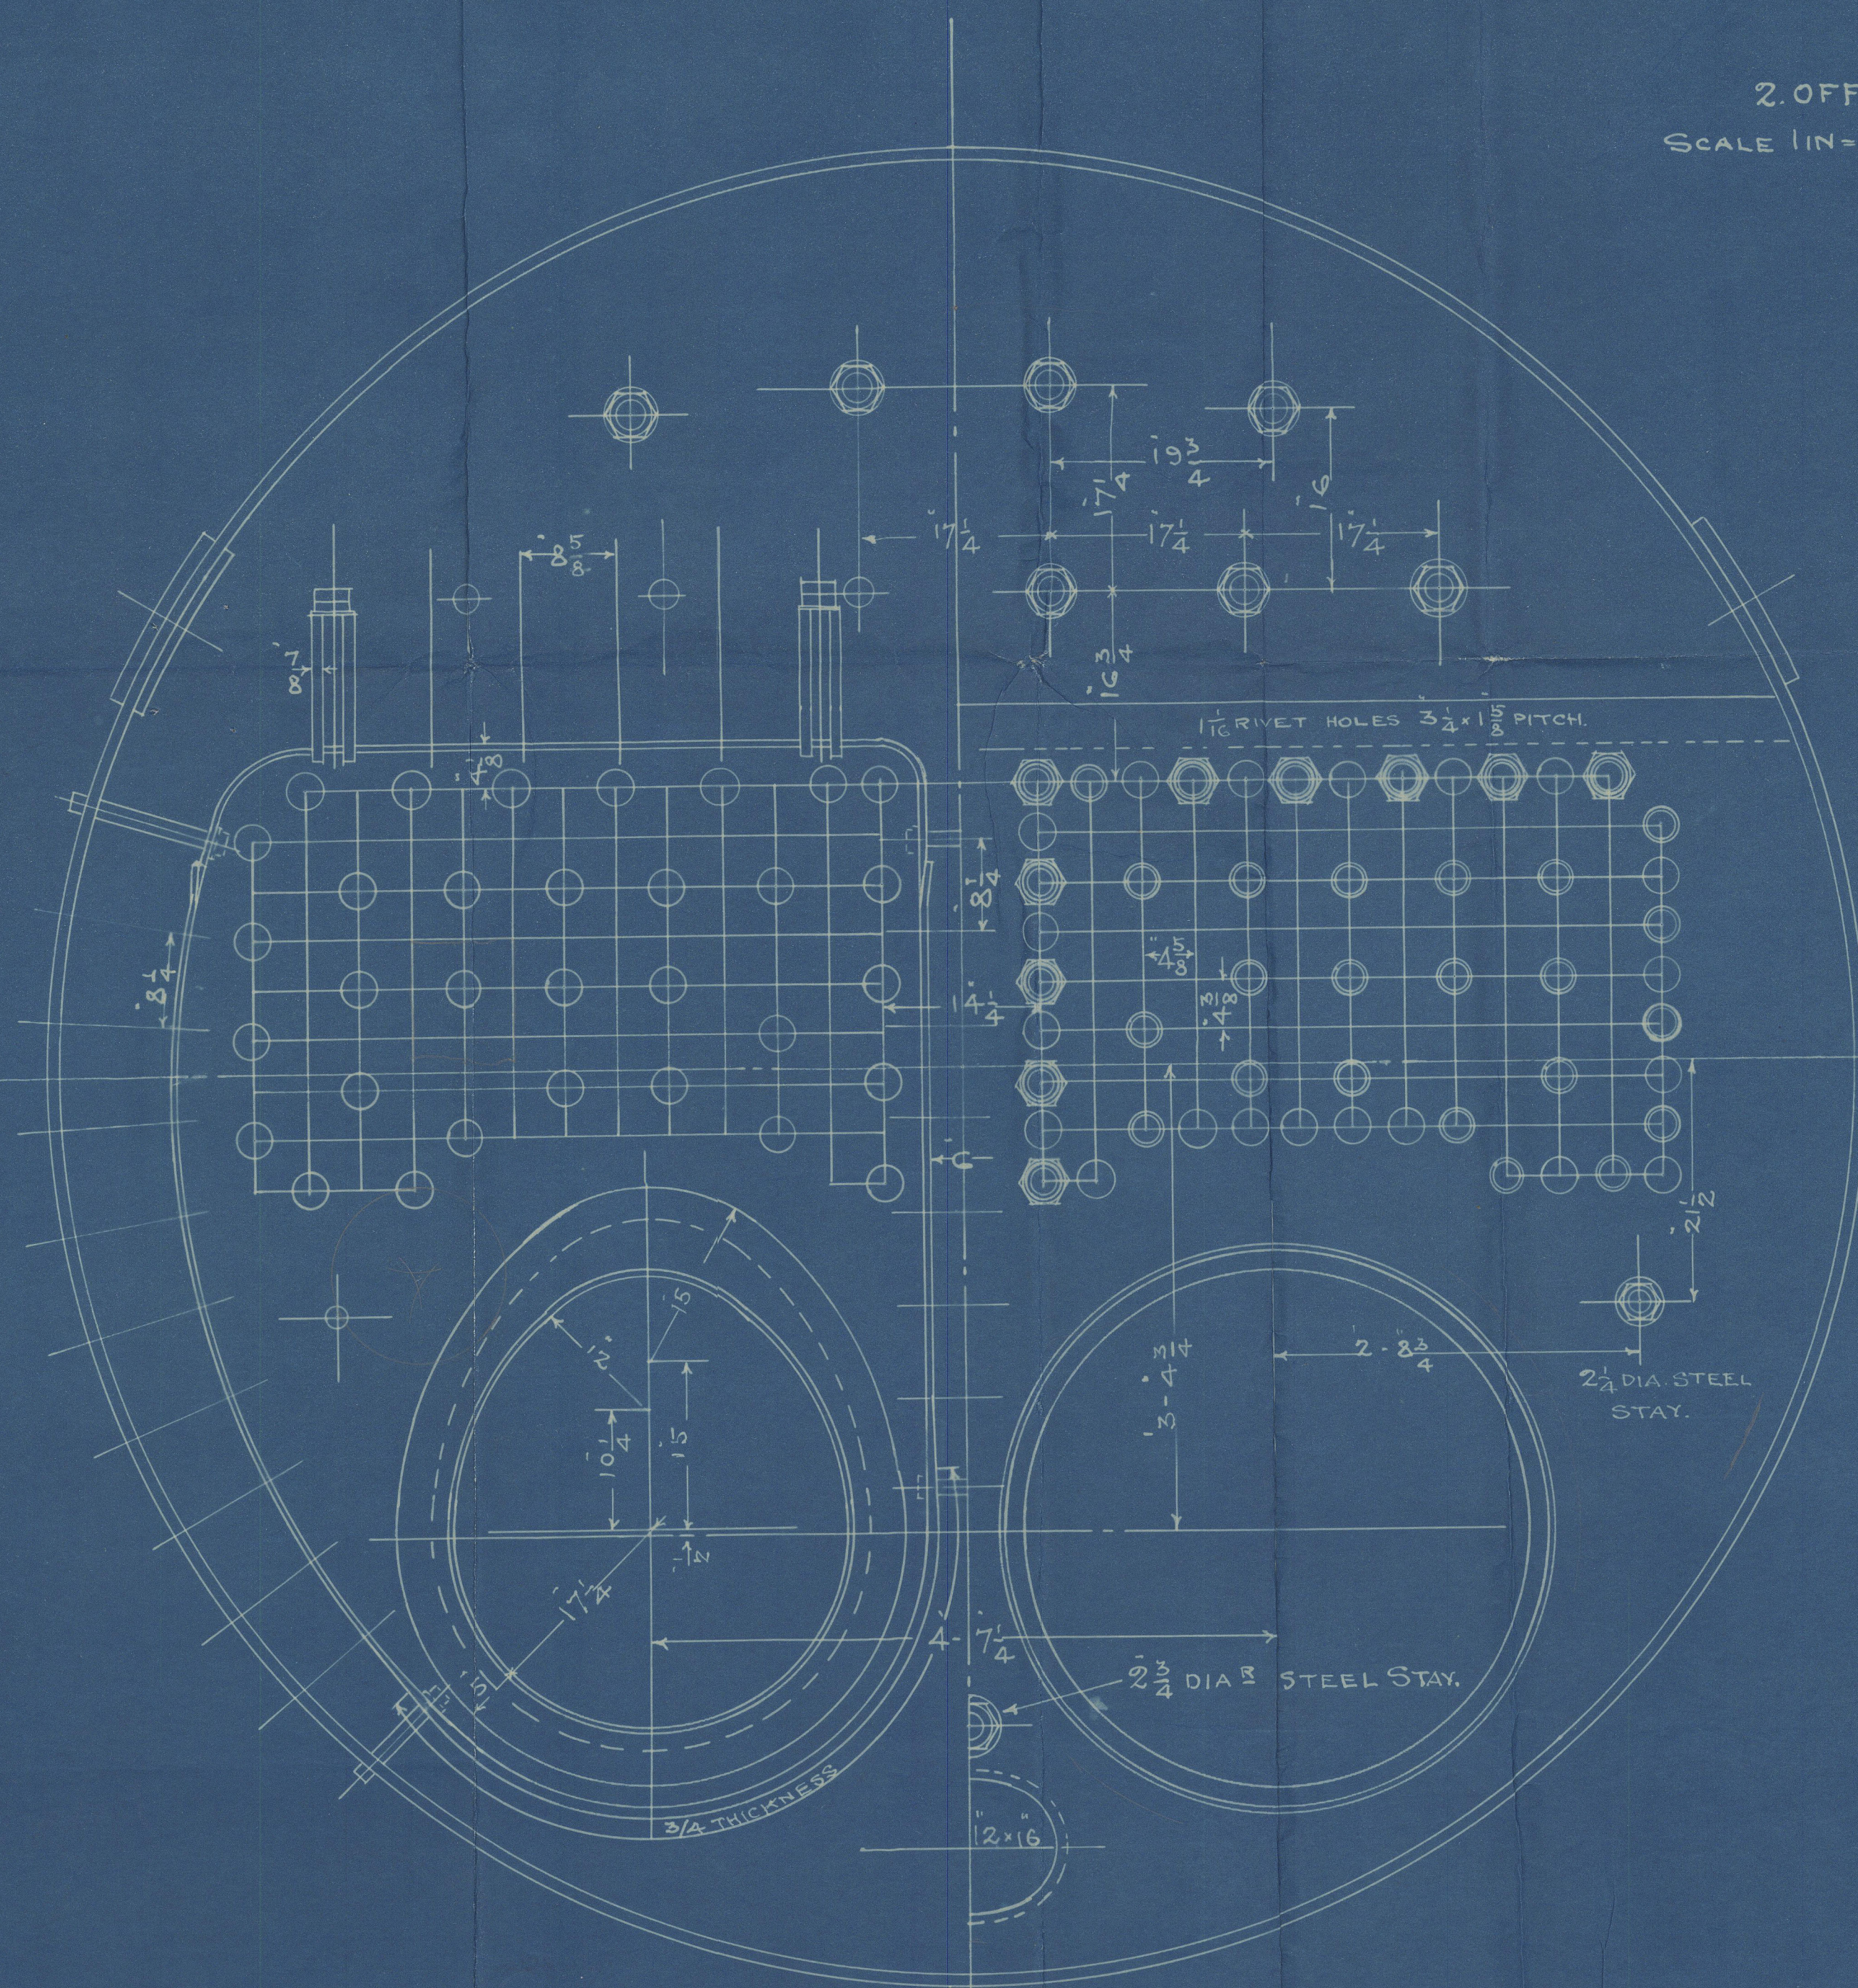


TO BE FITTED TO MESSRS SMITH'S DOCK C<sup>o</sup> LTD S.S. NO.  
TO PASS LLOYDS SURVEY FOR A WORKING PRESSURE OF 180 LBS PER SQ INCH  
TO BE TESTED IN THE PRESENCE OF LLOYDS & OWNERS SURVEYORS.


TENSILE OF SHELL PLATES	28.0 TO 32.0 TONS
" OTHER	26.0 - 30.0
" FURNACES	26.0 - 28.0
" MAIN STAYS	28.0 - 32.0
" SCREW	26.0 - 30.0
" RIVET	26.0 - 30.0

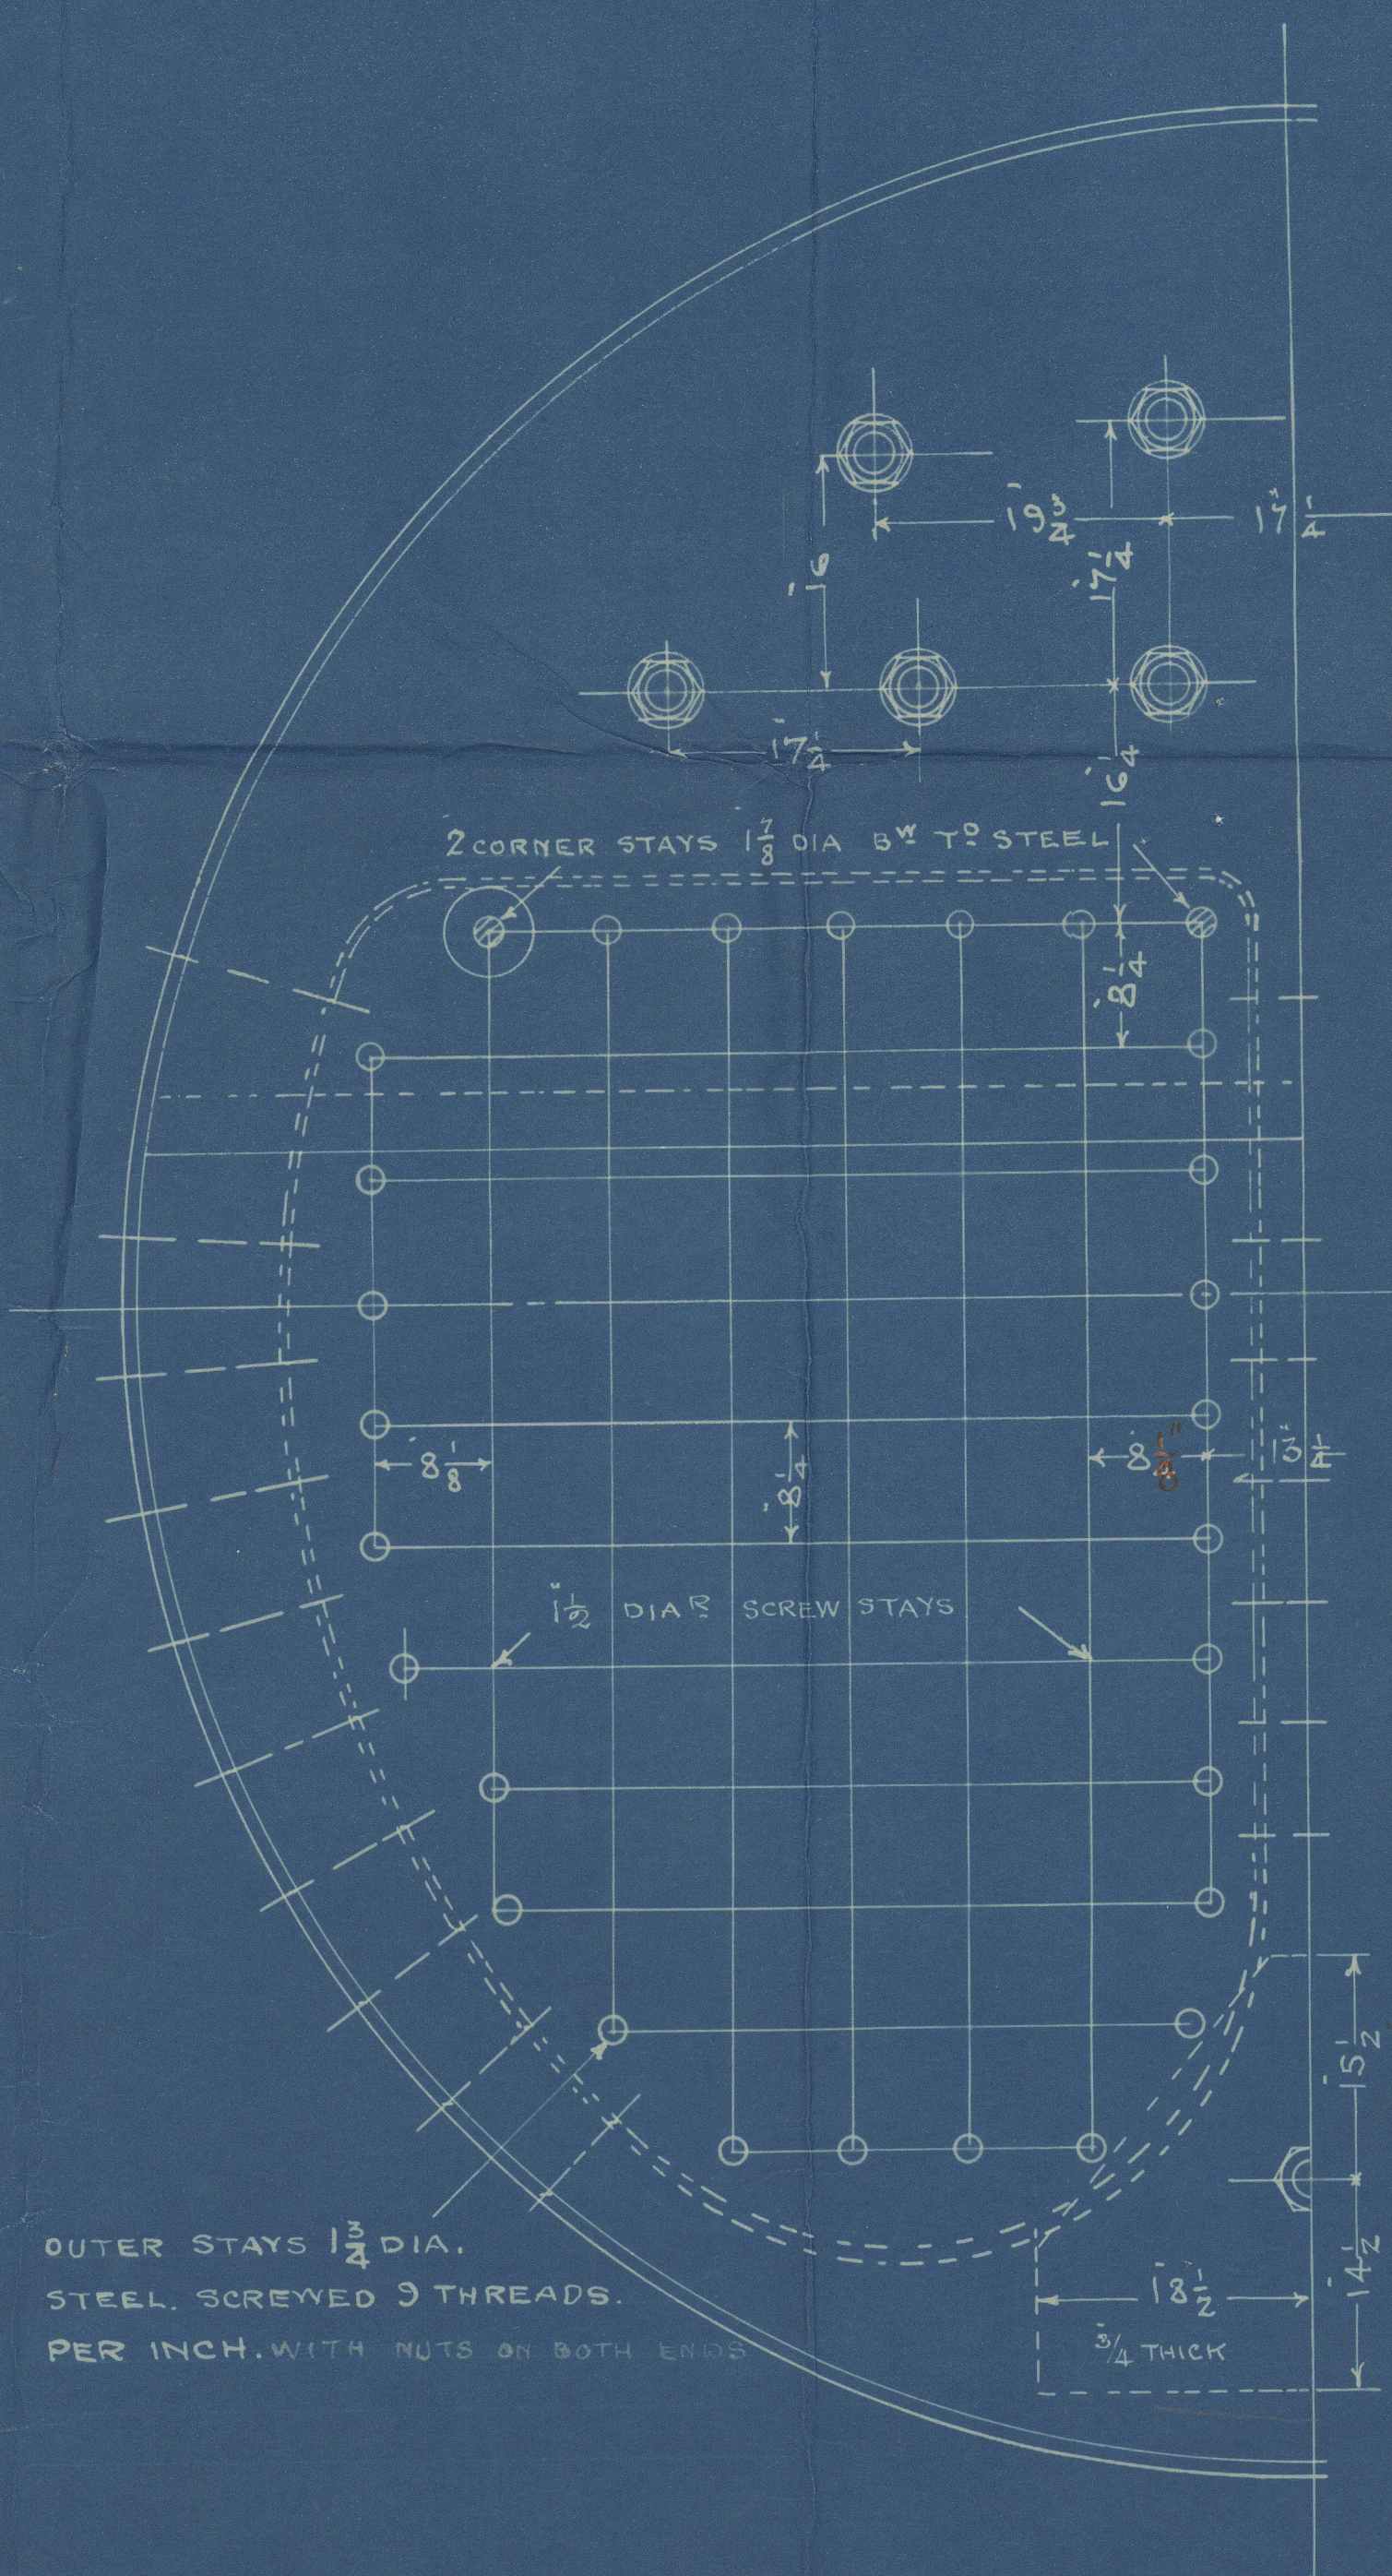

2. OFF.  
SCALE 1"=1 FOOT.

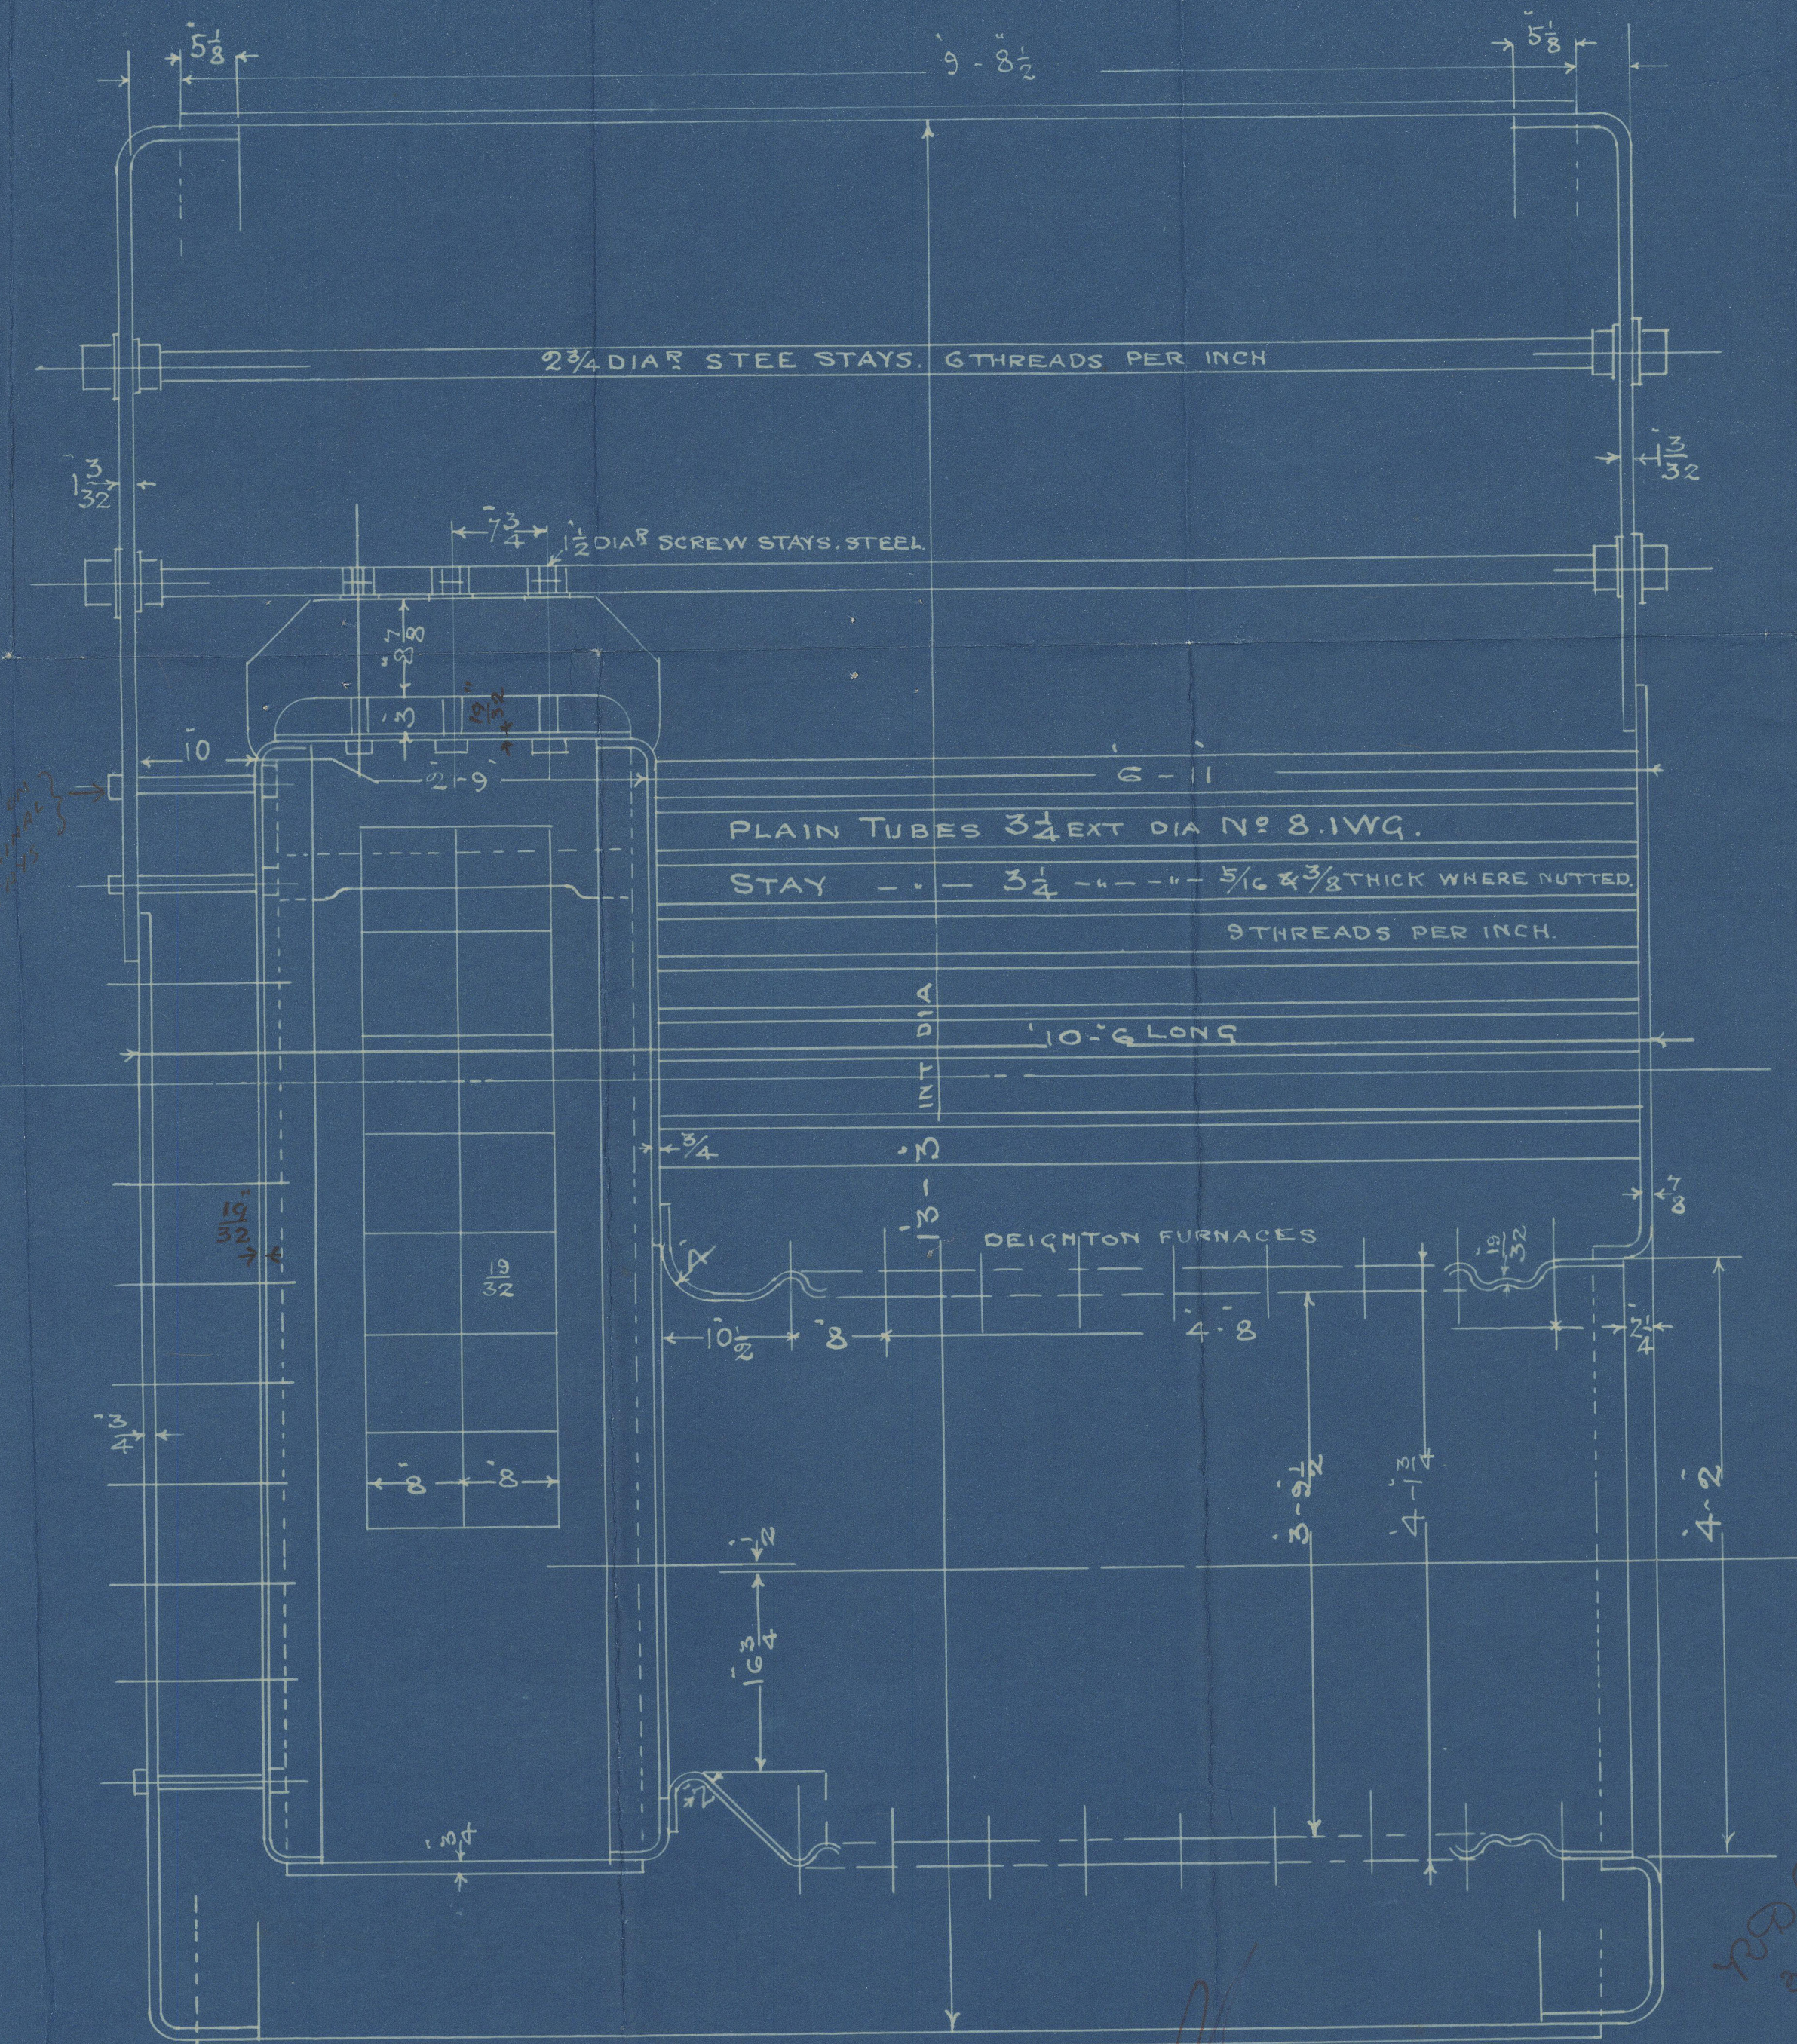

BOILERS D 153

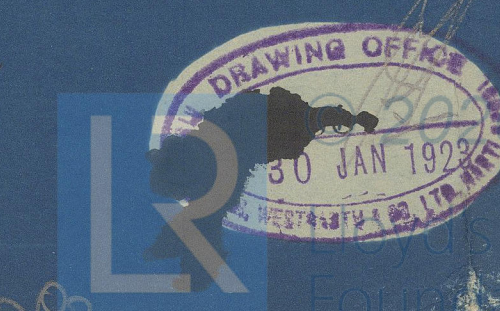



MAIN BOILERS

ID 153

RICHARDSONS

WESTGARTH

& Co LD

SMITH'S DOCK

Co LD

ENG. N° 238

N° 3623
LLOYDS TEST
320 LBS
W.P. 180 LBS
1.5.23 RDS

S.S. "Pegaway".

782  
Hpl Rpt N° 16080.

Inab. 11954.

RETAINED  
© 2020

Lloyd's Register  
Foundation  
W511-0082