


Lloyd's Register
Foundation

Atlantic

W511-0148 (1/2)

Superstructure bulkheads, trunks, deckhouses, casings, cargo and coaling hatchways, extent and thickness of sheathing on the freeboard deck, gangway, cargo and coaling ports, and any other openings, etc., which would affect the seaworthiness of the ship are to be shown on the following sketches:—

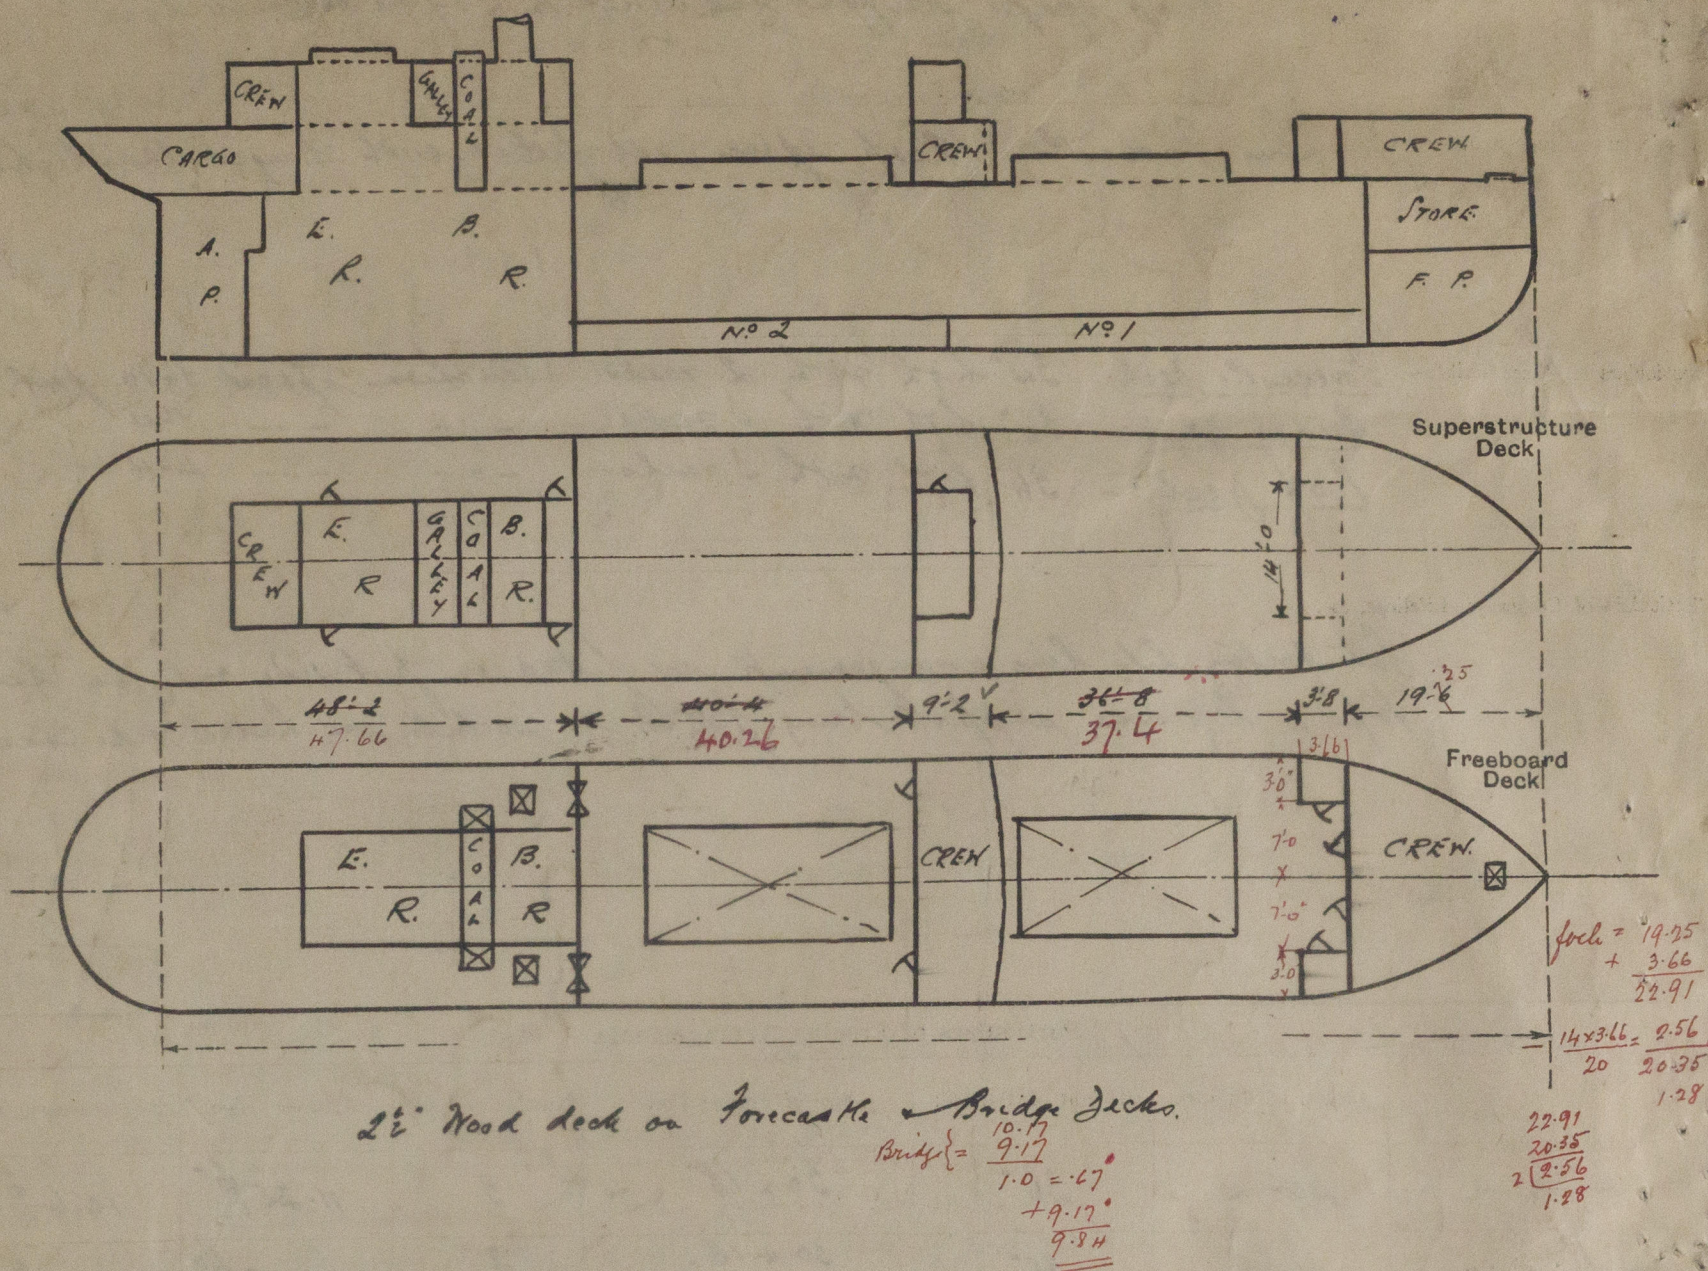

State any special features in the construction of the ship:—

From Disp. Scale on board:-

Disp.	Disp.	T.P.I.
11-0	930	7.70
12-0	1025	7.77
12-3	1045	7.78

Survey held afloat whilst loading.

~~Blasting appliances on Casings, Superstructures & Companionways~~
~~to be overhauled & placed in order.~~

Builder's name and yard number Men & Solby Bros Yard Nº 105.

Names of sister ships

Owners General Steam Nav. Co. Ltd.

Fee £ 5 : 2 : 0 Received by me (s) 25 AUG 1932