






# SHIP NO 105 PROFILE

SCALE 1/4" = 1 FOOT  
DIMENSIONS 15' 6" x 24' 11" MLD x 15' 3" MLD

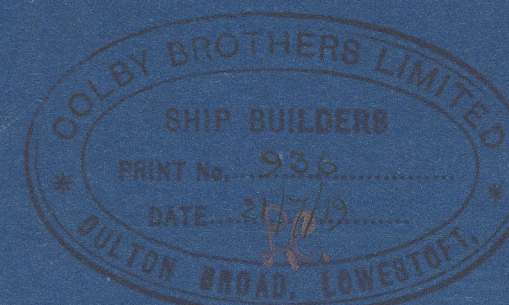


W.T. Bulkhead No 76

LOOKING FORWARD  
STIFFENERS 23x14x12 BA

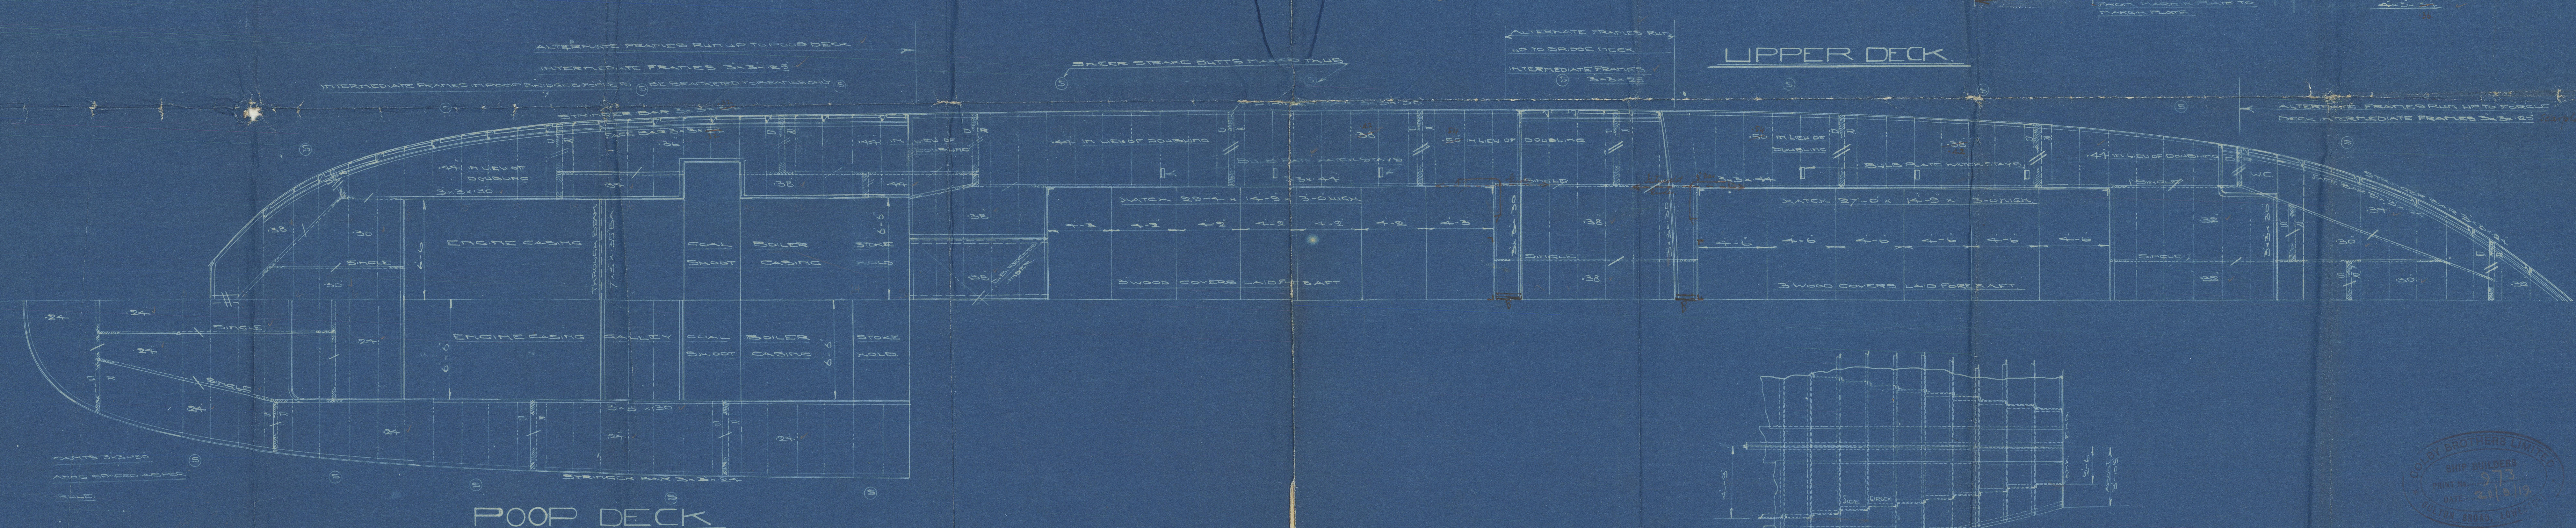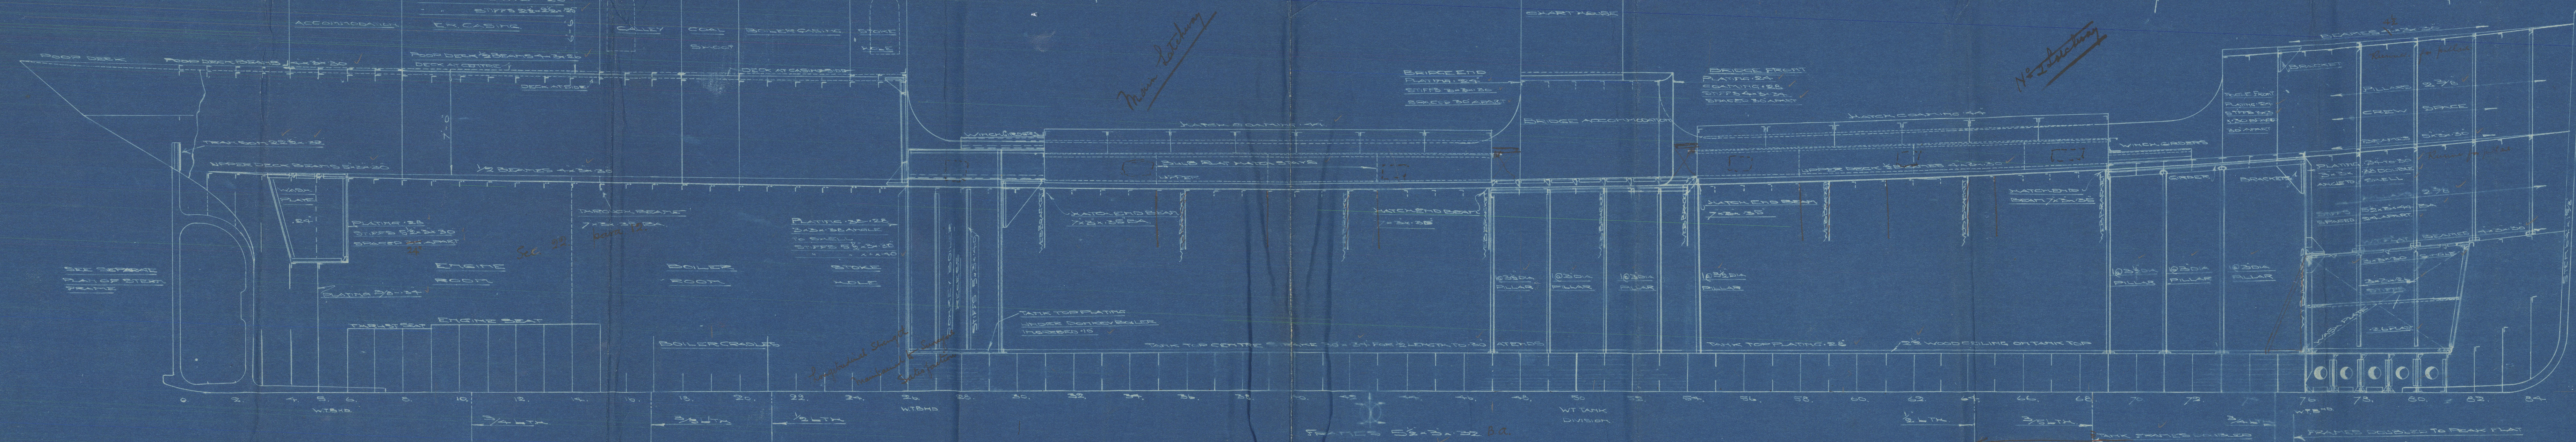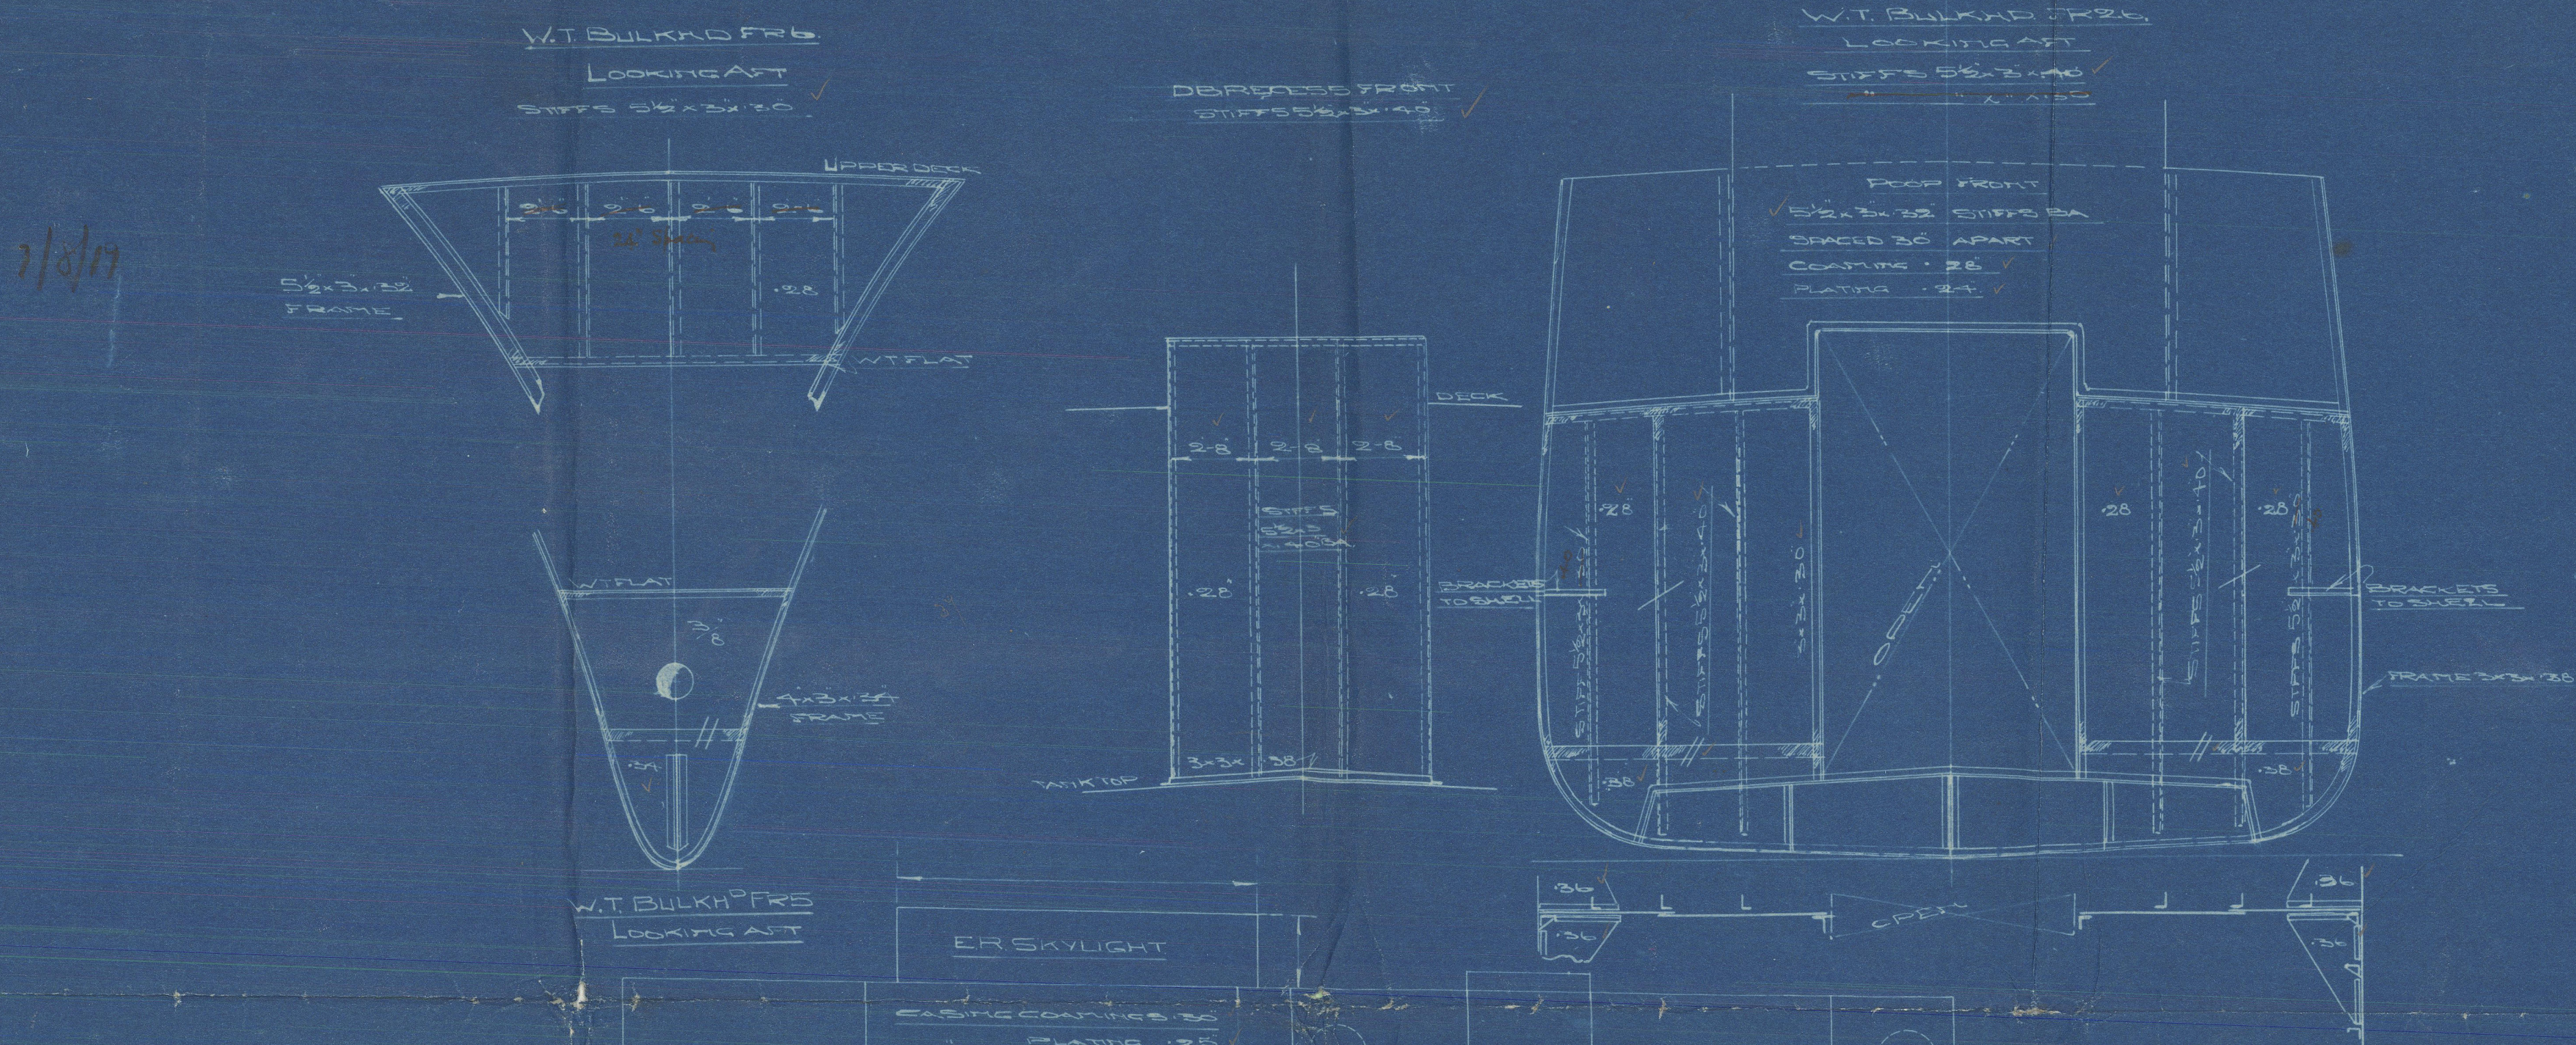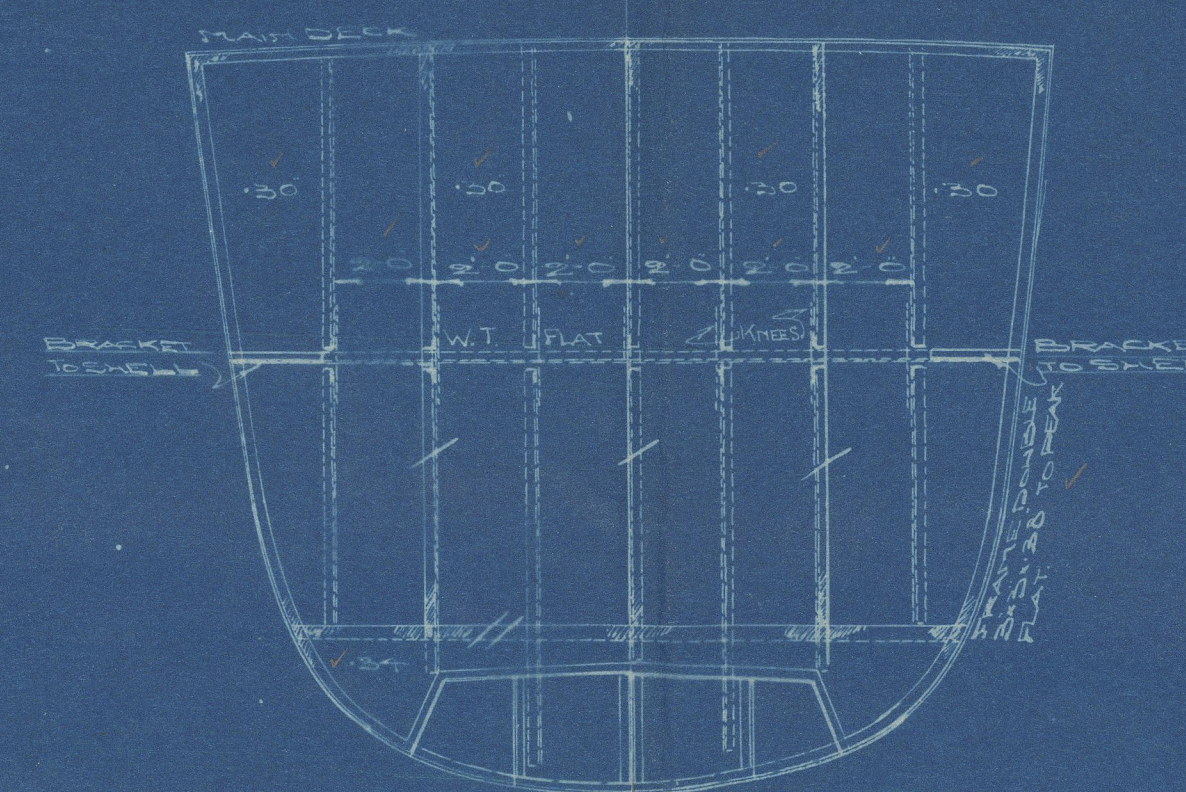


UPPER DECK

POOP DECK

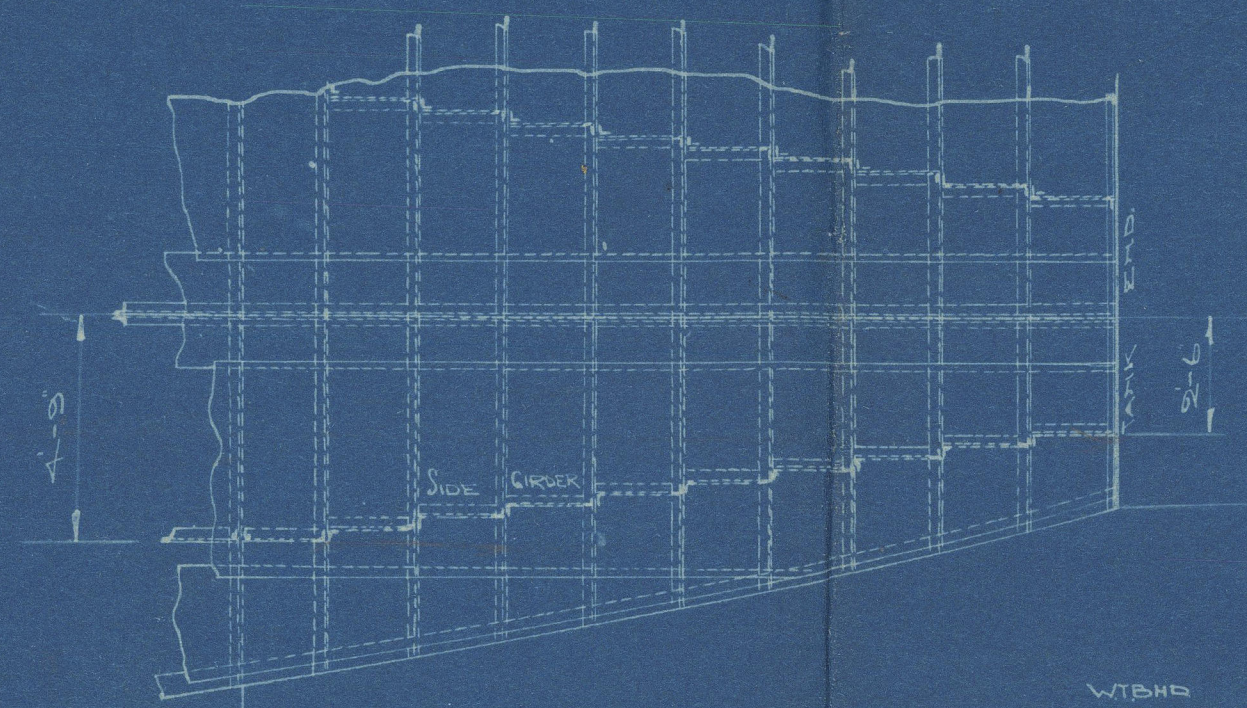

PLAN OF TANK TOP (YACHT END)  
SHOWING SIDE STRUCTURE

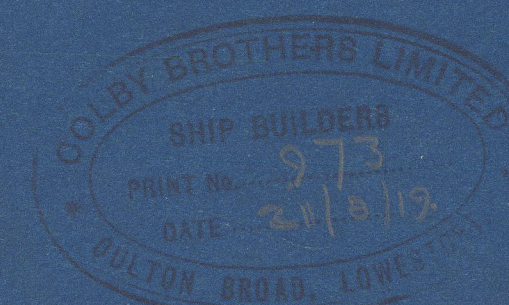

W511-0181



W511-0187



© 2020


Lloyd's Register  
Foundation



Colly Bros

S.S. 105

PROFILE

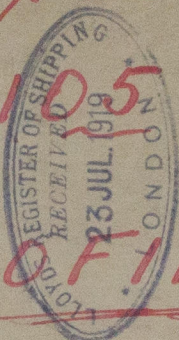

105

Lloyds Approved  
Plan:- Profile.

"Glenmor"

Jan 83/32  
**RETAIN**

W511-0187



© 2020

Lloyd's Register  
Foundation