

Scale 1:25

Numbers

<u>Length</u>	277' 00"
<u>Breadth</u>	42' 50"
<u>Depth</u>	23' 70"
<u>Girth of half midship frame</u>	41' 80"
<u>Round of beam</u>	1' 00"
<u>Spacing of frames</u>	2' 00"




9.1 $21.25 + 25.70 + 41.80 = 88.75$

9.2 $88.75 \times 2.77 = 24583.75$

9.3 $24583 + \frac{24583}{15} = 26221$ Equipement minimal

$$\frac{\text{Length}}{\text{Breadth}} = 6.51 \quad \frac{\text{Length}}{\text{Depth}} = 10.77$$

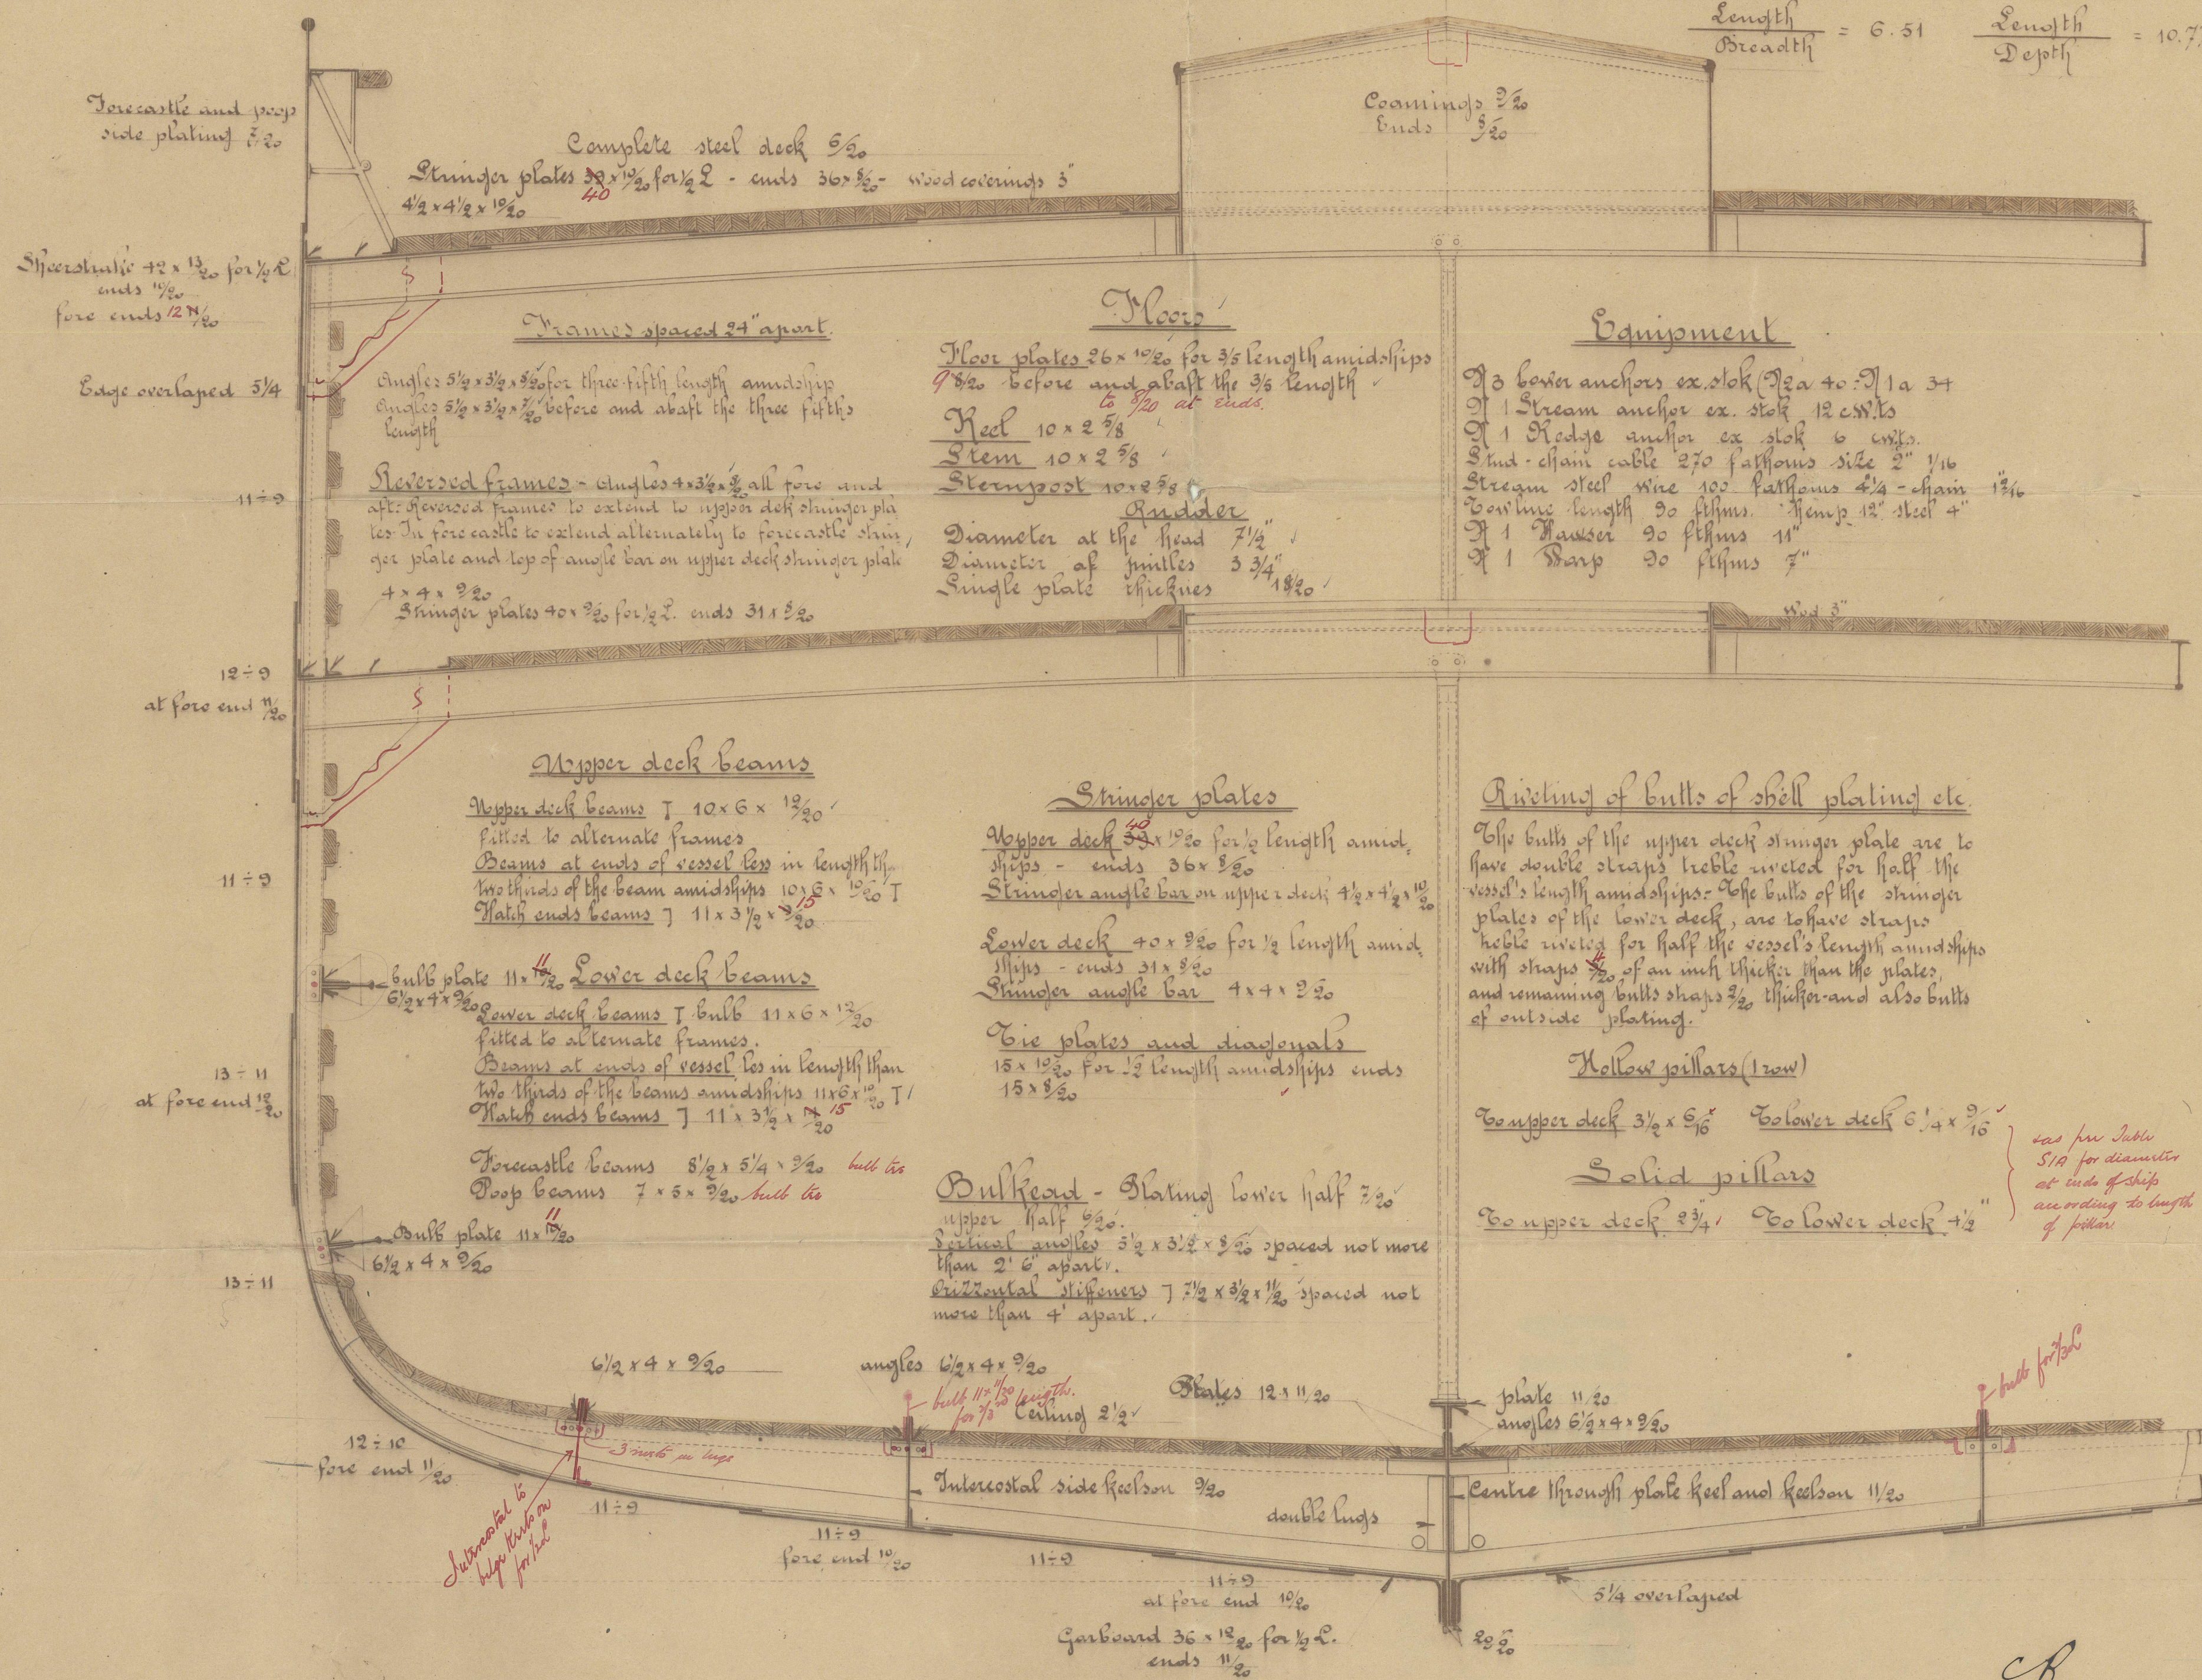

C.B.
18.4.02

RETAIN

S. Sh. "Regina Elena"

Gen. 2901.


Riva Lugoso

No 23

Midship Section

RETAIN

approved
18/4/03

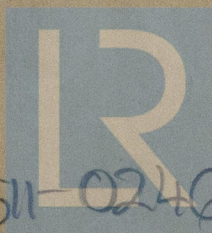

© 2020

Lloyd's Register
Foundation

