

General dimensions

Length	87.00
Breadth	19.50
Depth	26.70
Girth of half and ship frame	41.50
Round of beam	1.00
Spacing of frames	2.00

18.4.02




Numbers &c.

N ^o 1	$21.25 + 25.70 + 41.50 = 88.75$
N ^o 2	$88.75 \times 2.77 = 2455.75$


Length	88.75
Breadth	19.50
Depth	26.70

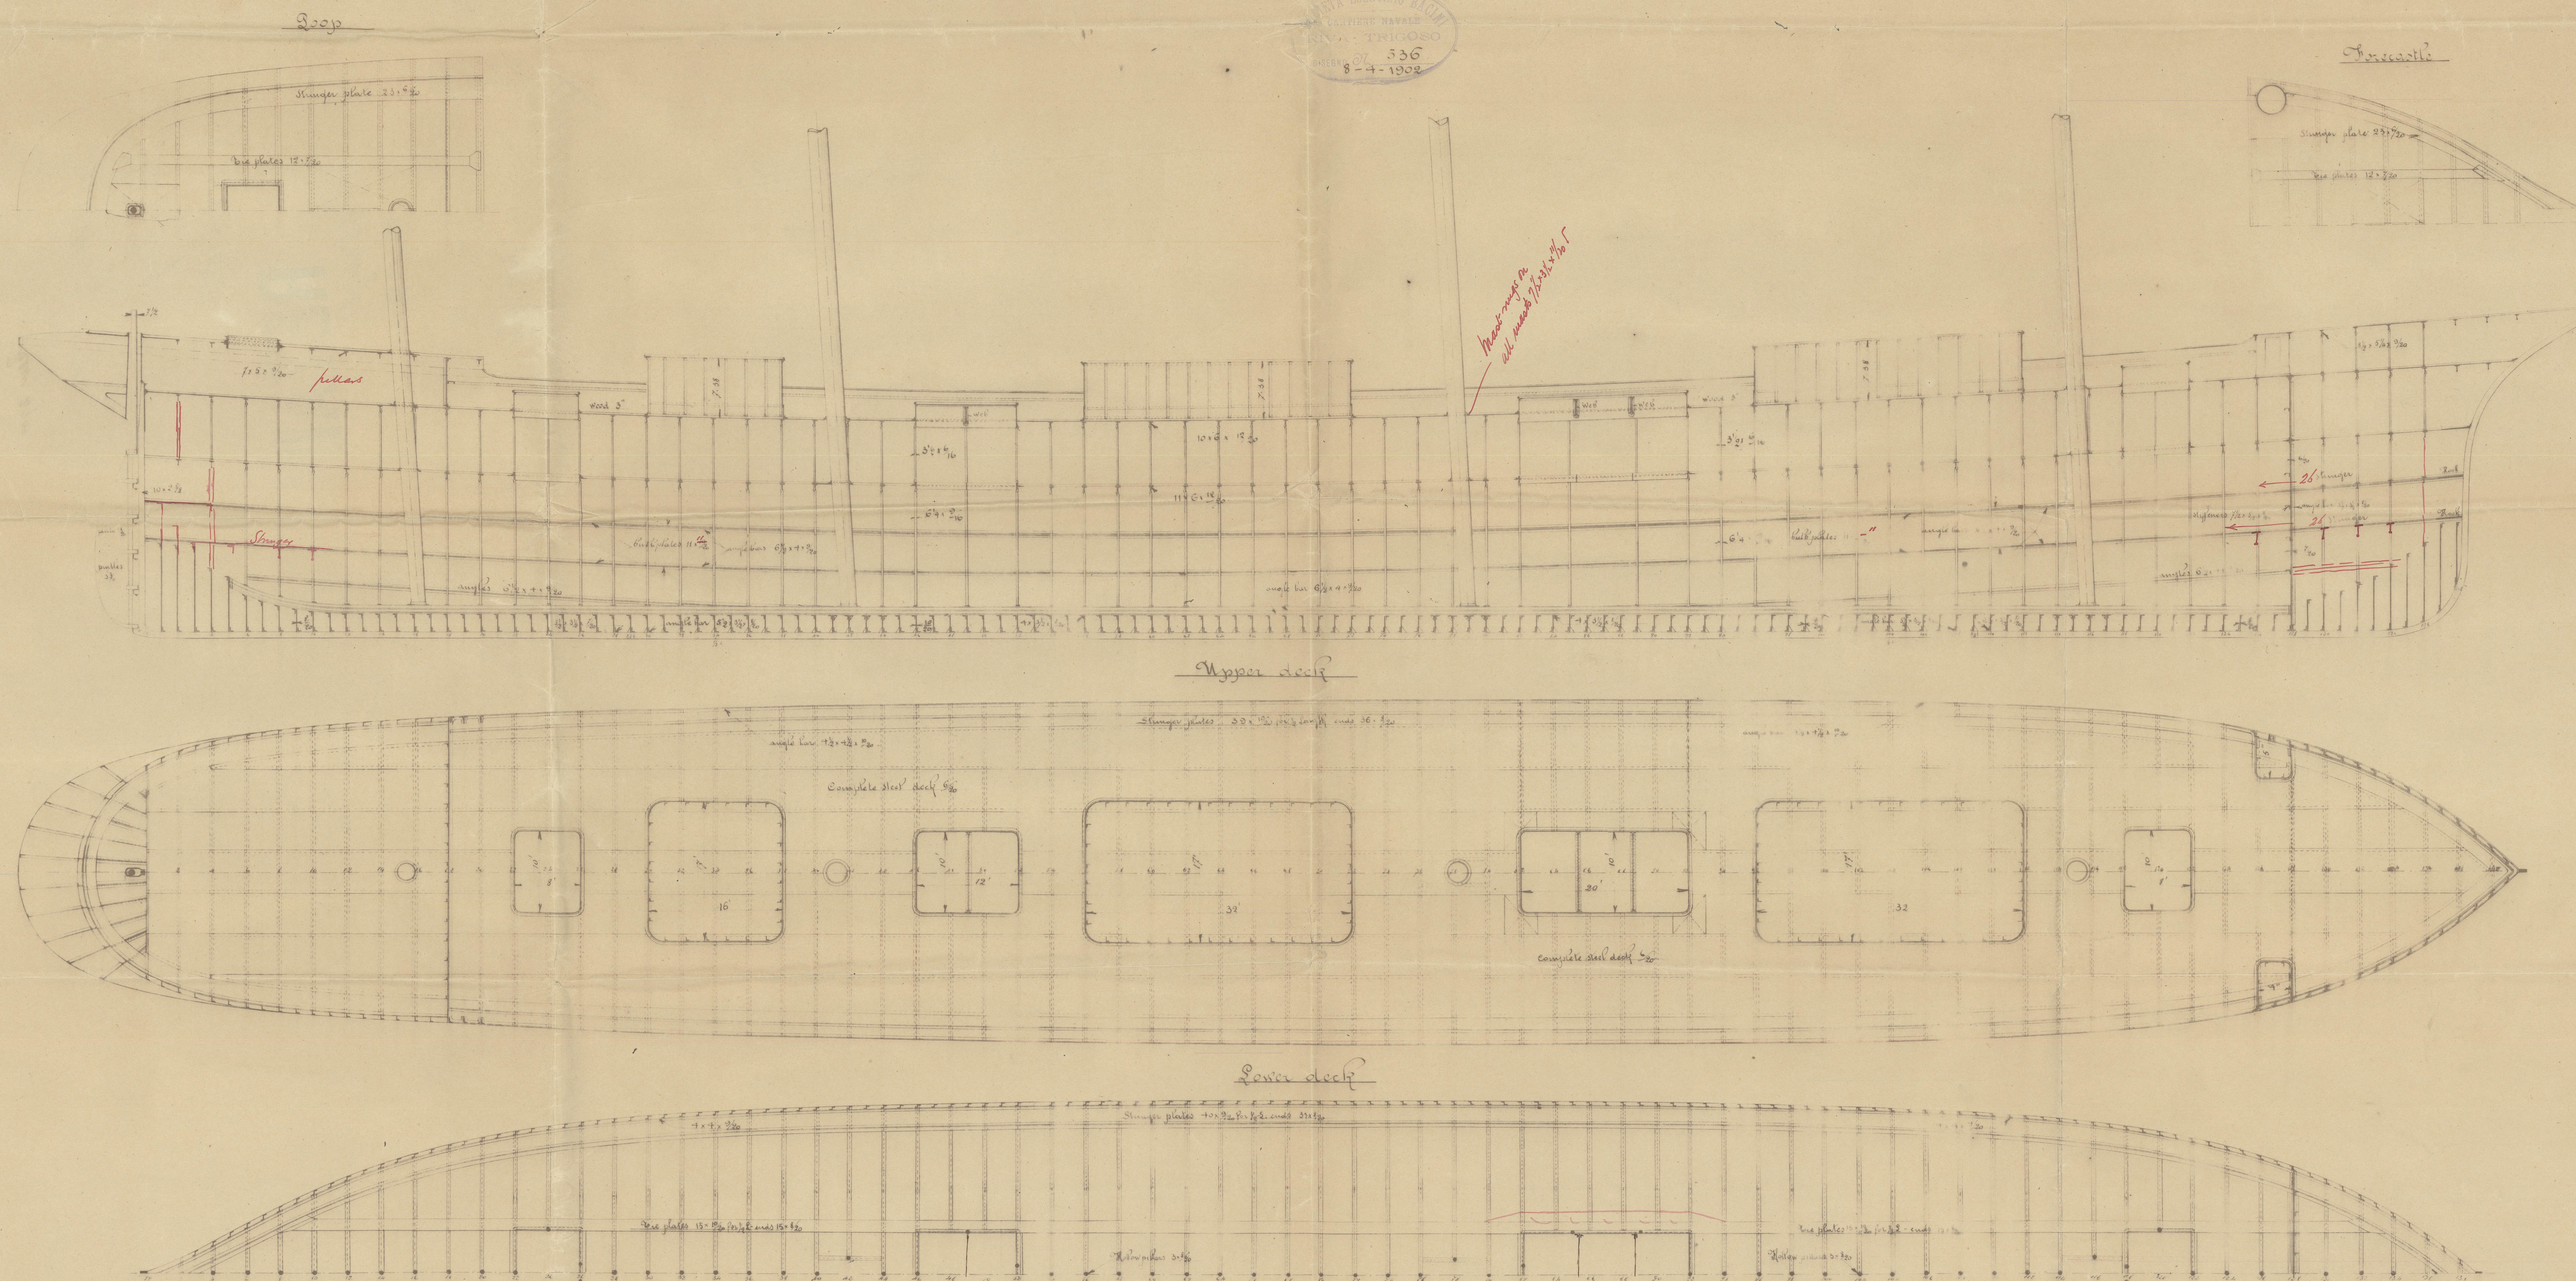

c.b.
18.4.02

N^o 23

RETAIN

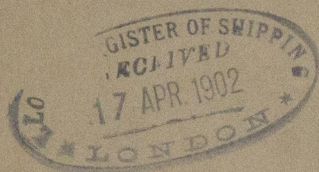

S.S. "Regina Elena"

Gen. 2901.

Profile Plan

Pina Lugoso

No 23

RETAIN

approved
18/4/02

WSH 0247



© 2020

Lloyd's Register
Foundation