


Steel yards for sailing vessel N^o 23 - Scale 1:20

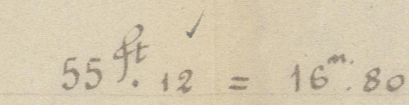

C.B.
2-10-82

RETAIN

S. Sk. "Regina Elea"

Gen. 2901.

*Plan of Yards
Pina Lugoro
No 23*

*approved
2/10/02*

RETAIN

© 2020

W511-0248

Lloyd's Register
Foundation

W511-0248