

SCALE $1/4" =$ FOOT


WILLIAM DENNY & BROTHERS LTD.
DRAWING OFFICE
221
J.P.

NUMERALS	
B	49.96
D	24.50
TRANSVERSE N°	74.46
L	3.90
LONGITUDINAL N°	29.06
b	7.80
D	9.63 TO BRIDGE OK
d	13.67
under 12 to shade OK	
EQUIPMENT NUMERL	32600

BUTTS

KEEL BUTTS DOUBLE STRAPPED & TREBLE RIVETTED FOR 1/2" ALL FORE & AFT. ✓
STRAPPED & TREBLE RIVETTED AT ENDS ✓
SHEER STRAKE & BOTTOM PLATING TO UPPER TURN OF BILGE LAPPED ✓
& QUADRUPLE RIVETTED FOR 1/2" TREBLE RIVETTED AT ENDS ✓
SIDE PLATING LAPPED & TREBLE RIVETTED ALL FORE & AFT ✓
BRIDGE DECK STRINGER LAPPED & QUADRUPLE RIVETTED ✓
OTHER STRINGERS LAPPED & TREBLE RIVETTED ALL FORE & AFT ✓
DECK PLATING LAPPED & DOUBLE RIVETTED FOR 1/2" ✓
" " " SINGLE " *treble* AT ENDS ✓
INNER BOTTOM MID STRAKE LAPPED & DOUBLE RIVETTED ALL FORE & AFT. ✓
REMAINDER LAPPED & DOUBLE RIVETTED FOR 1/2" SINGLE AT ENDS ✓
CENTRE GIRDER & MARGIN PLATES LAPPED & TREBLE RIVETTED. ✓

LANDINGS
SHELL DOUBLE RIVETTED THROUGHOUT ✓
DECK PLATING SINGLE THROUGHOUT ✓
INNER BOTTOM MID STRAKE DOUBLE ALL FORE & AFT ✓
REMAINDER SINGLE ALL FORE & AFT.
BUTTS ON BOTTOM PLATING INSIDE LINE OF TANK TREBLE
RIVETED.

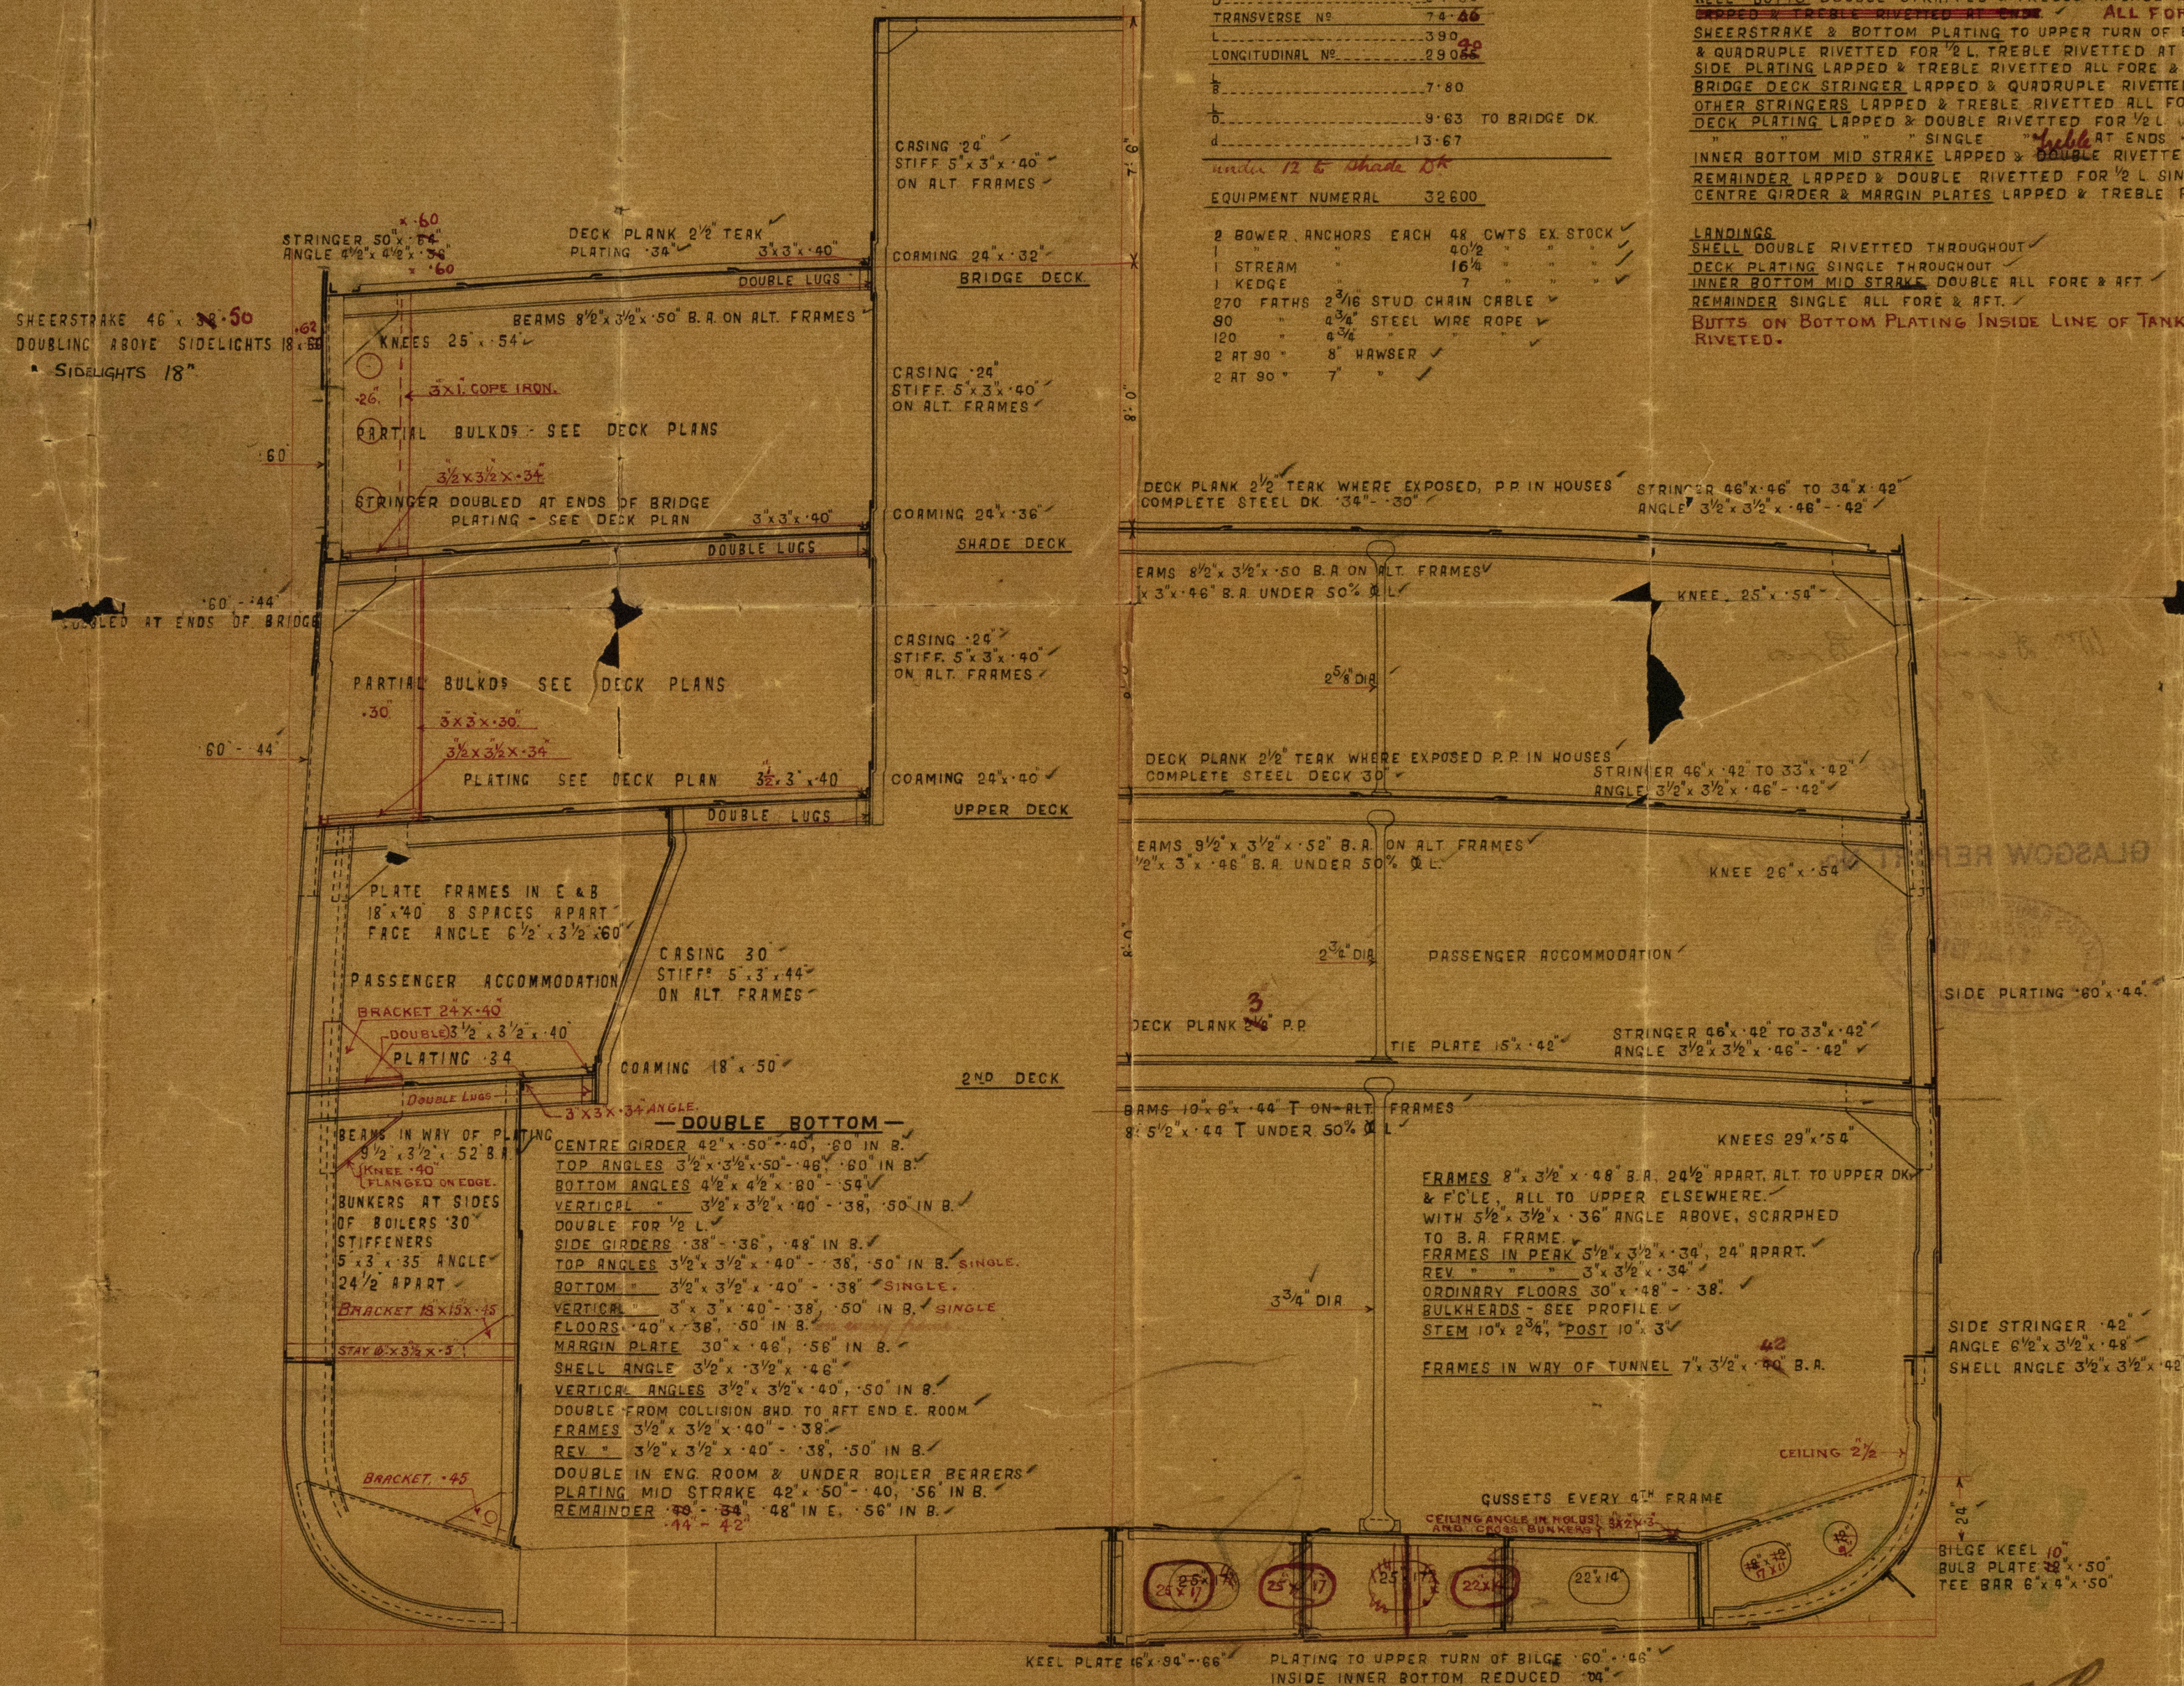

SIDE PLATING .60" x .44"

SIDE STRINGER .42"
ANGLE 6 1/2" x 3 1/2" x .48"
SHELL ANGLE 3 1/2" x 3 1/2" x .4


BILGE KEEL 10"
BULB PLATE 32" x .50"
TEE BAR 6" x 4" x .50"

C.B.
31. 1-10

Ct

Wm. Denny & Bros.
No 925.
S/S "Angora"

GLASGOW REPORT No. 29791

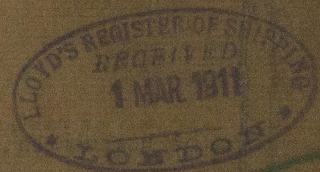

MIDSHIP
SECTION

REMAIN

W512-0319



© 2020

Lloyd's Register
Foundation