
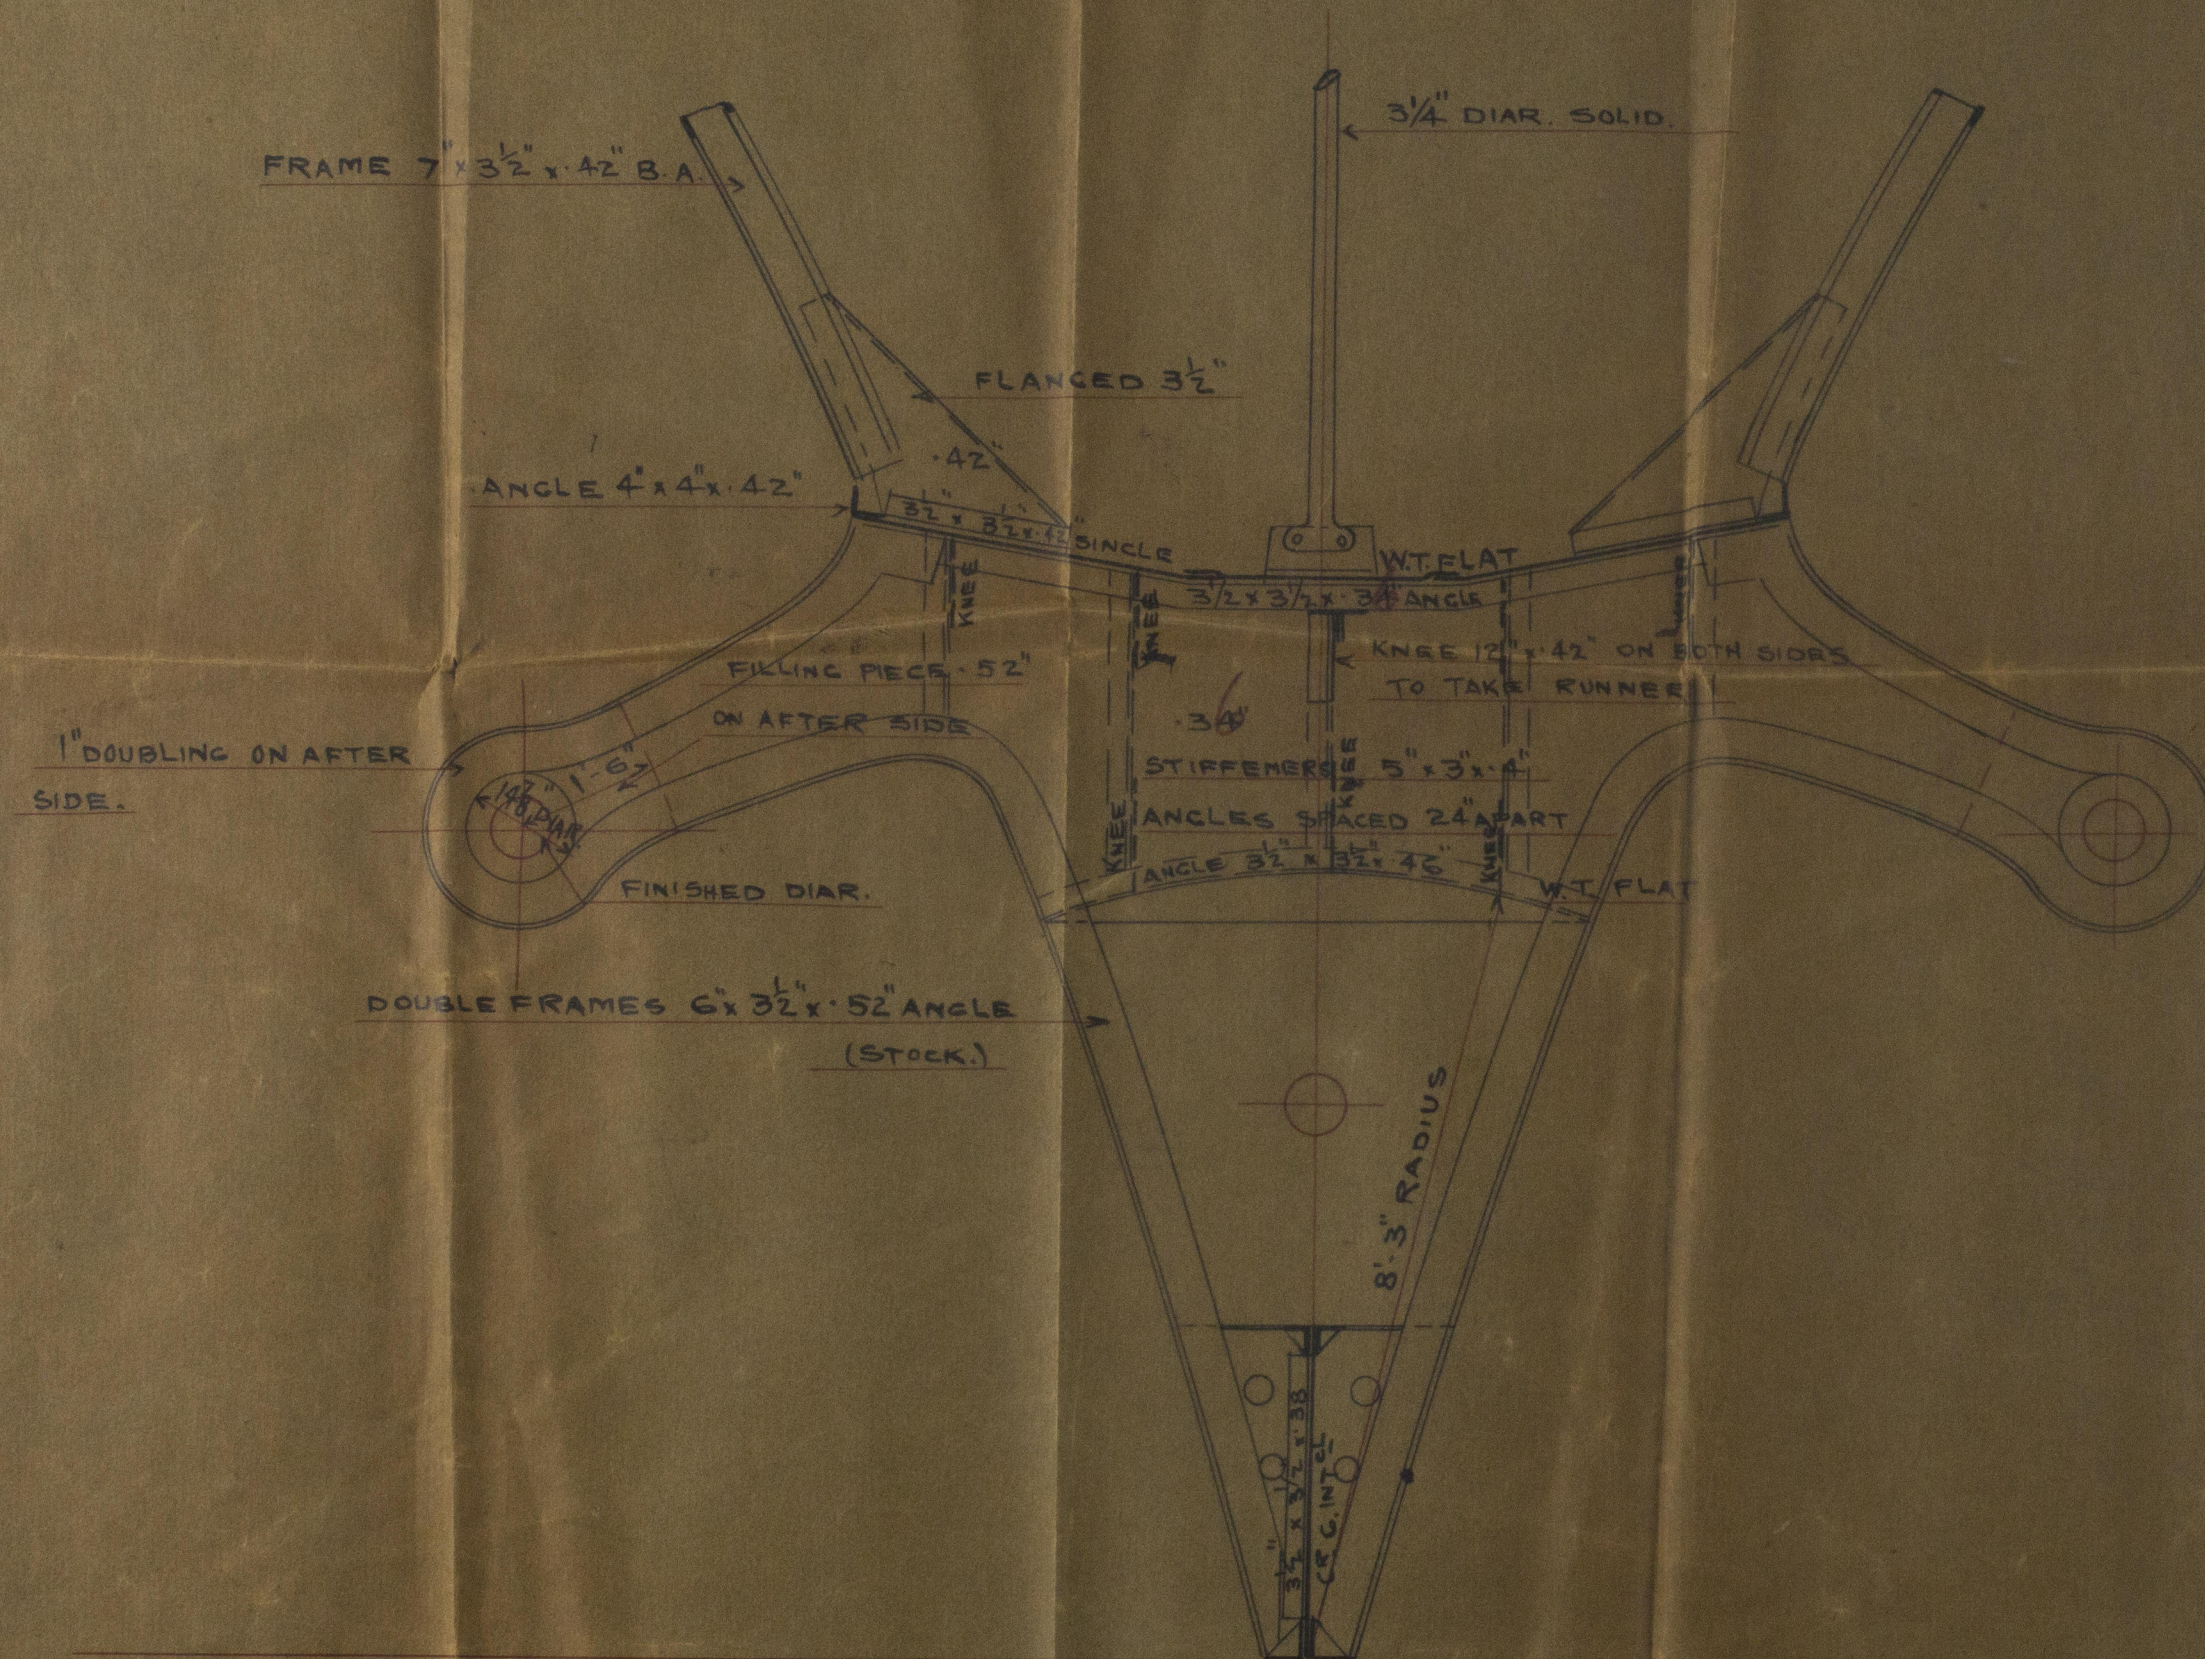


Nº 925


PROPOSED ALTERATION TO  
FRS. Nº 14 & 18.

SCALE 1/2" = 1 FT

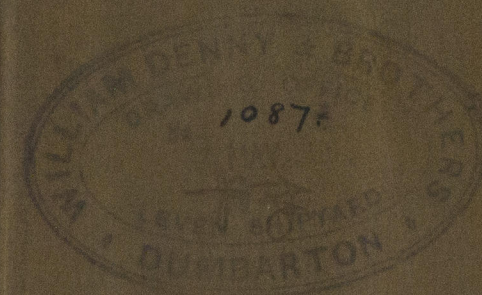

SECTION AT FR. 14 (LOOKING AFT)

W.T. BETWEEN FLATS

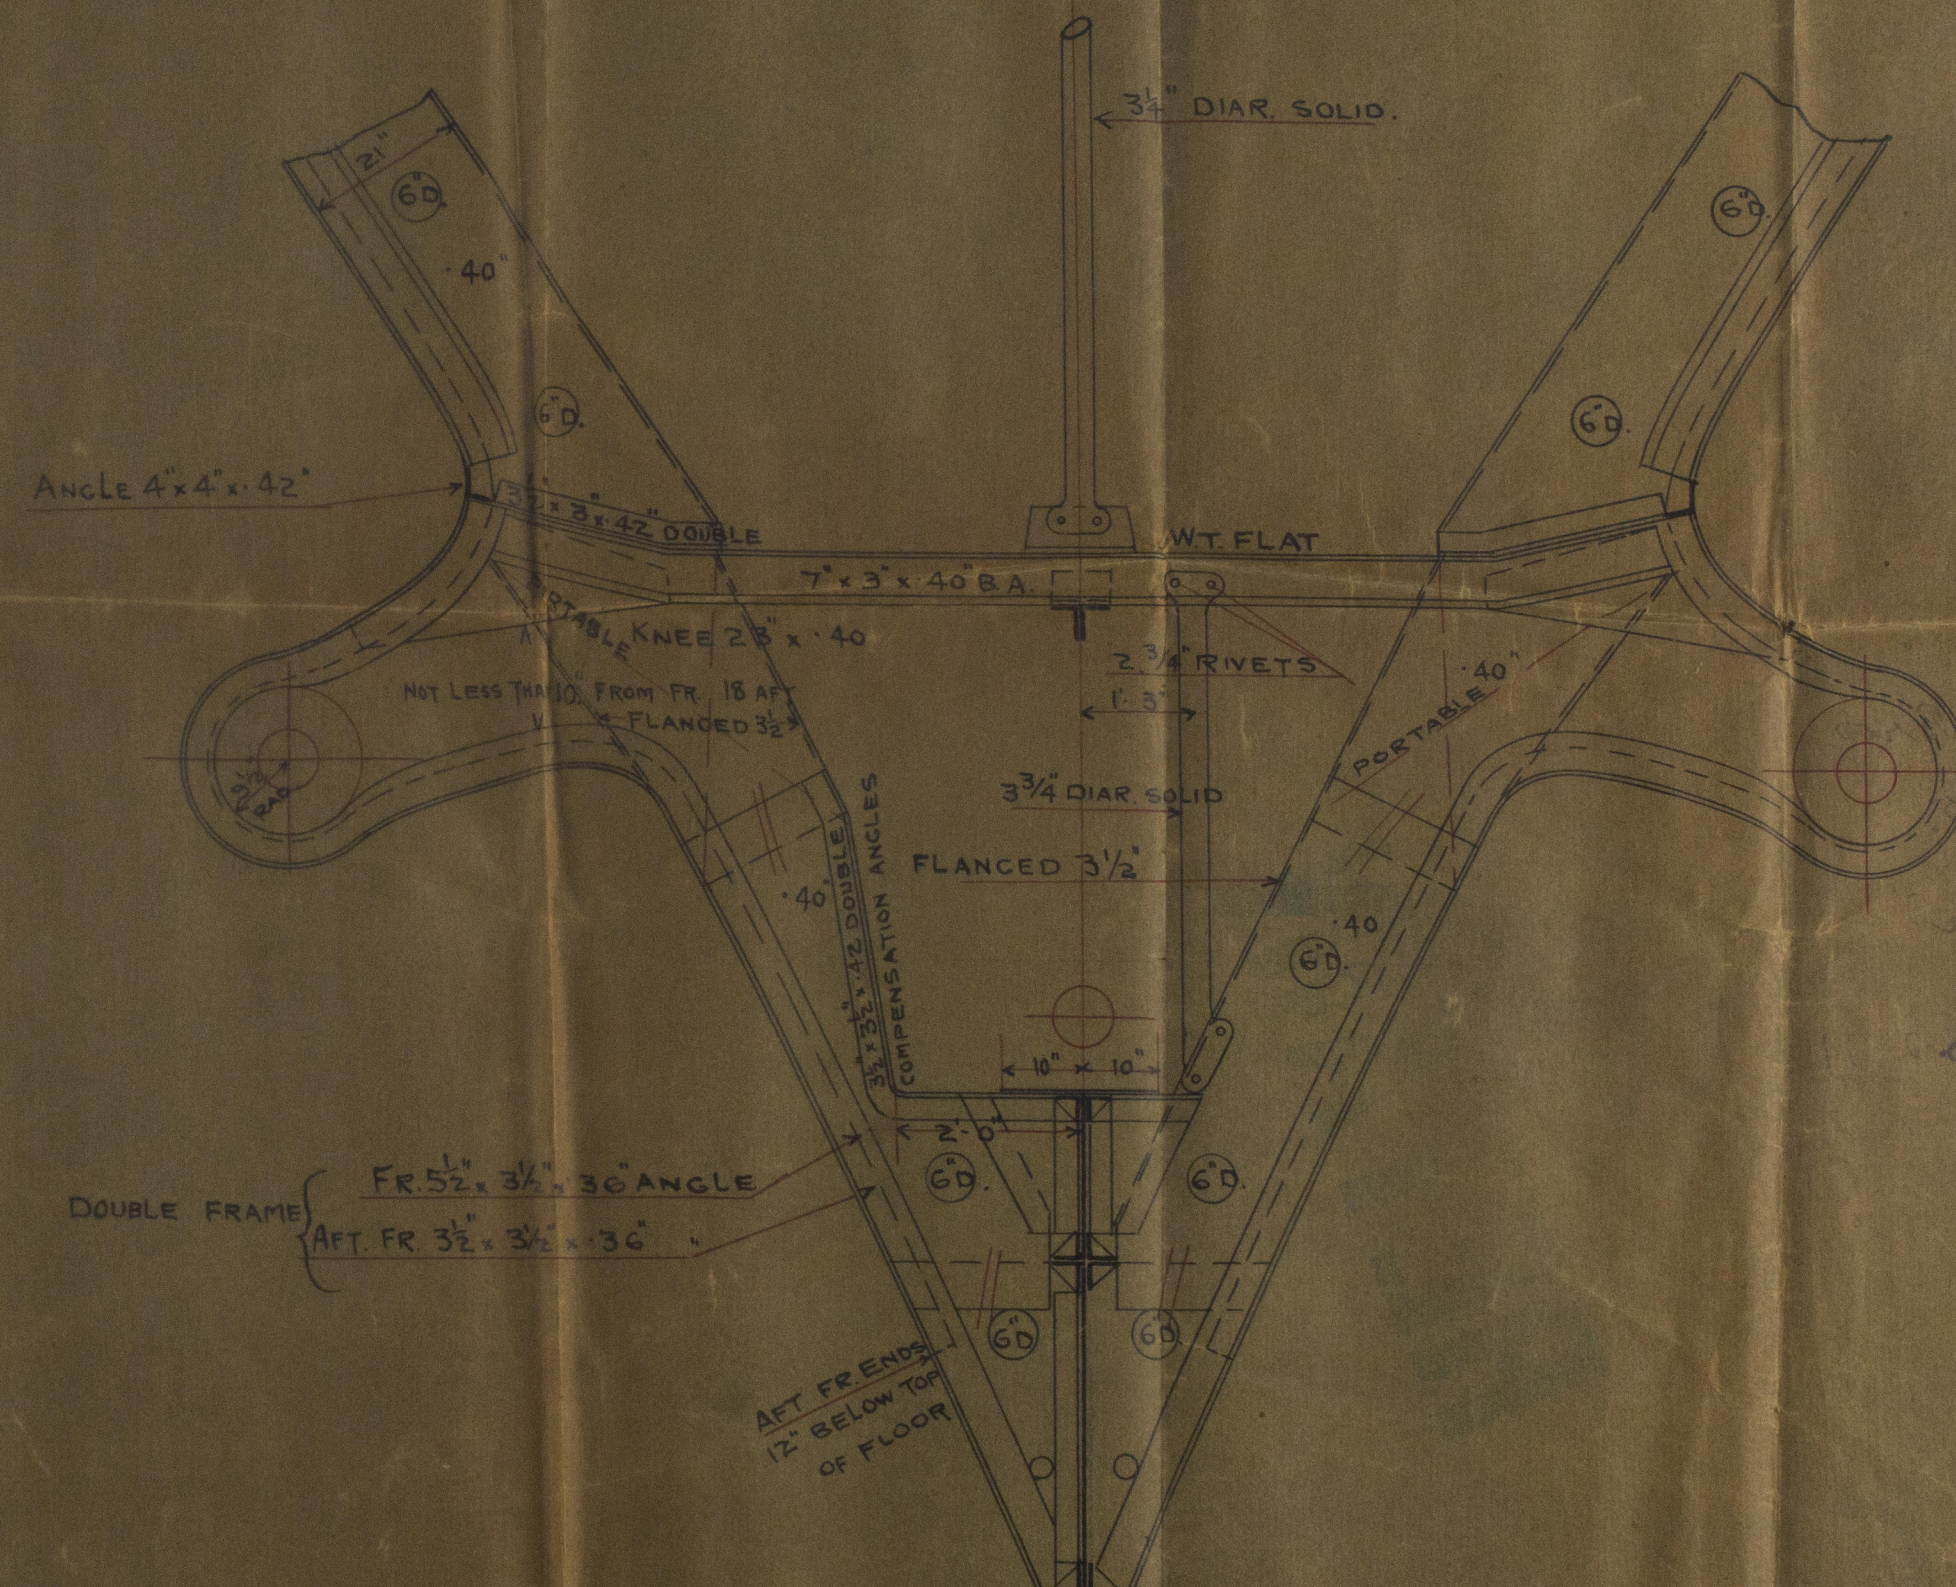

SECTION AT FR. Nº 18

LOOKING AFT





Glasgow Register  
Foundation




*Handwritten notes in top left corner.*

PROPOSED ALTERATION TO  
FRS NO 1A & 1B  
SCALE 1/2" = 1' 0"

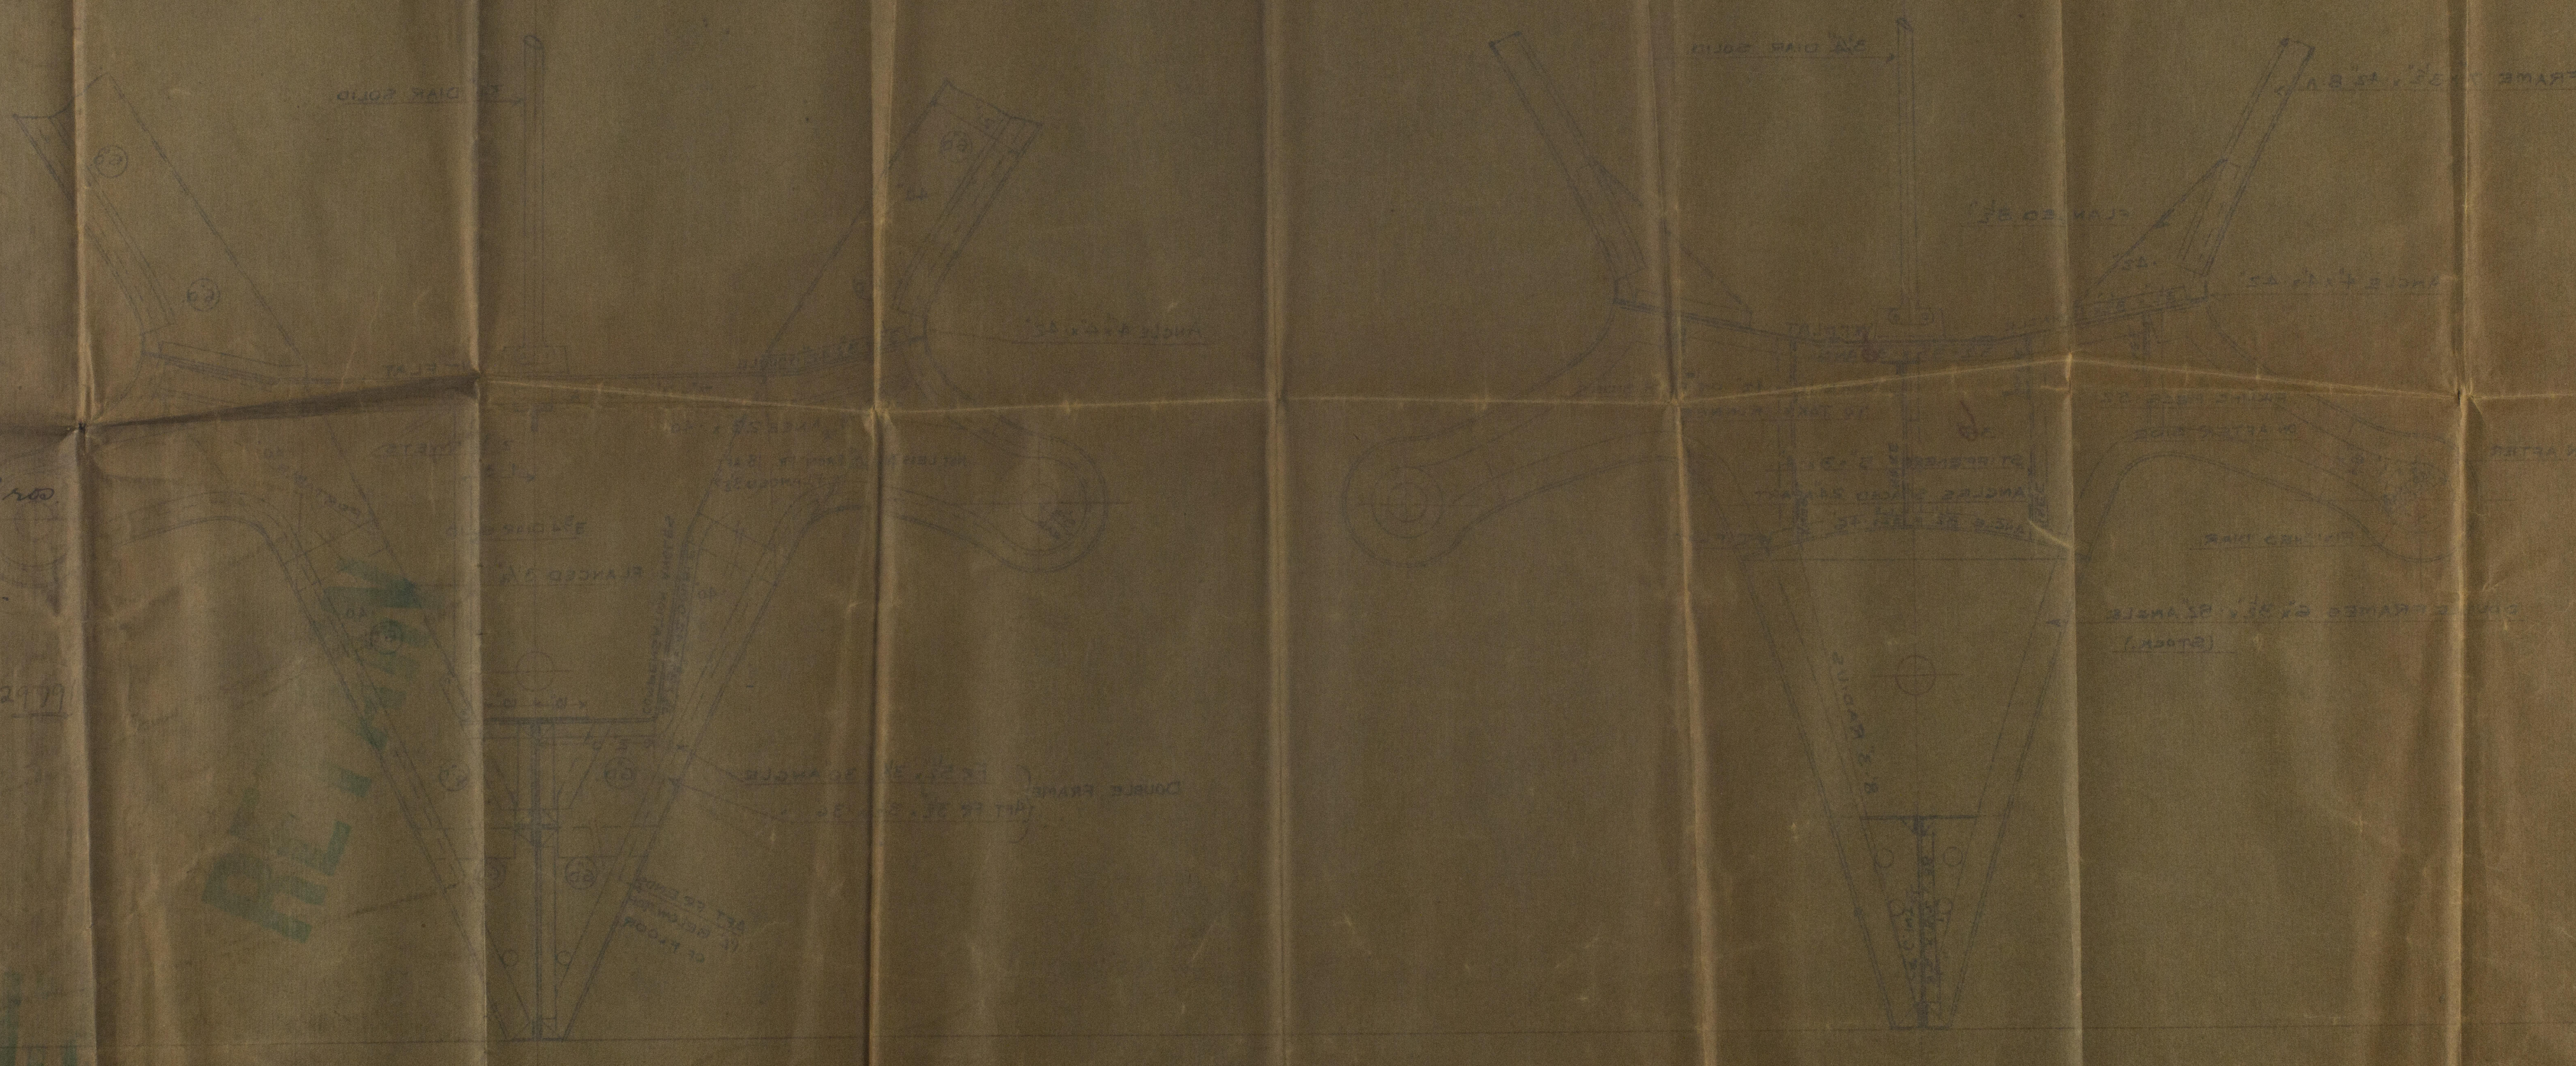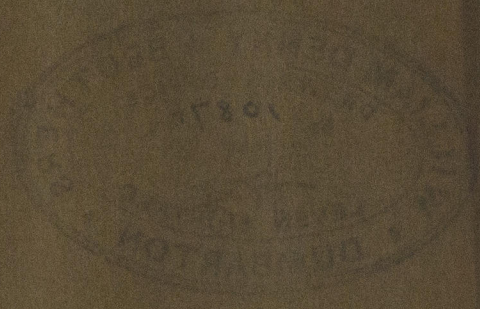

Wm Denny & Bros  
No 925  
1/2 "Angora"

GLASGOW REPORT No 2977

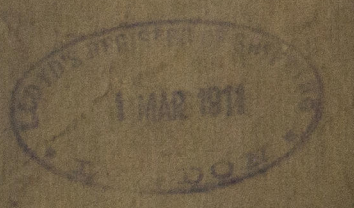

REPAIR

W512-0320