


— SCALE  $\frac{1}{8}'' = \text{ONE FOOT}$  —

31. 1. 10  
10. 2. 10  
7. 3. 10  
22. 3. 10  
2. 4. 10

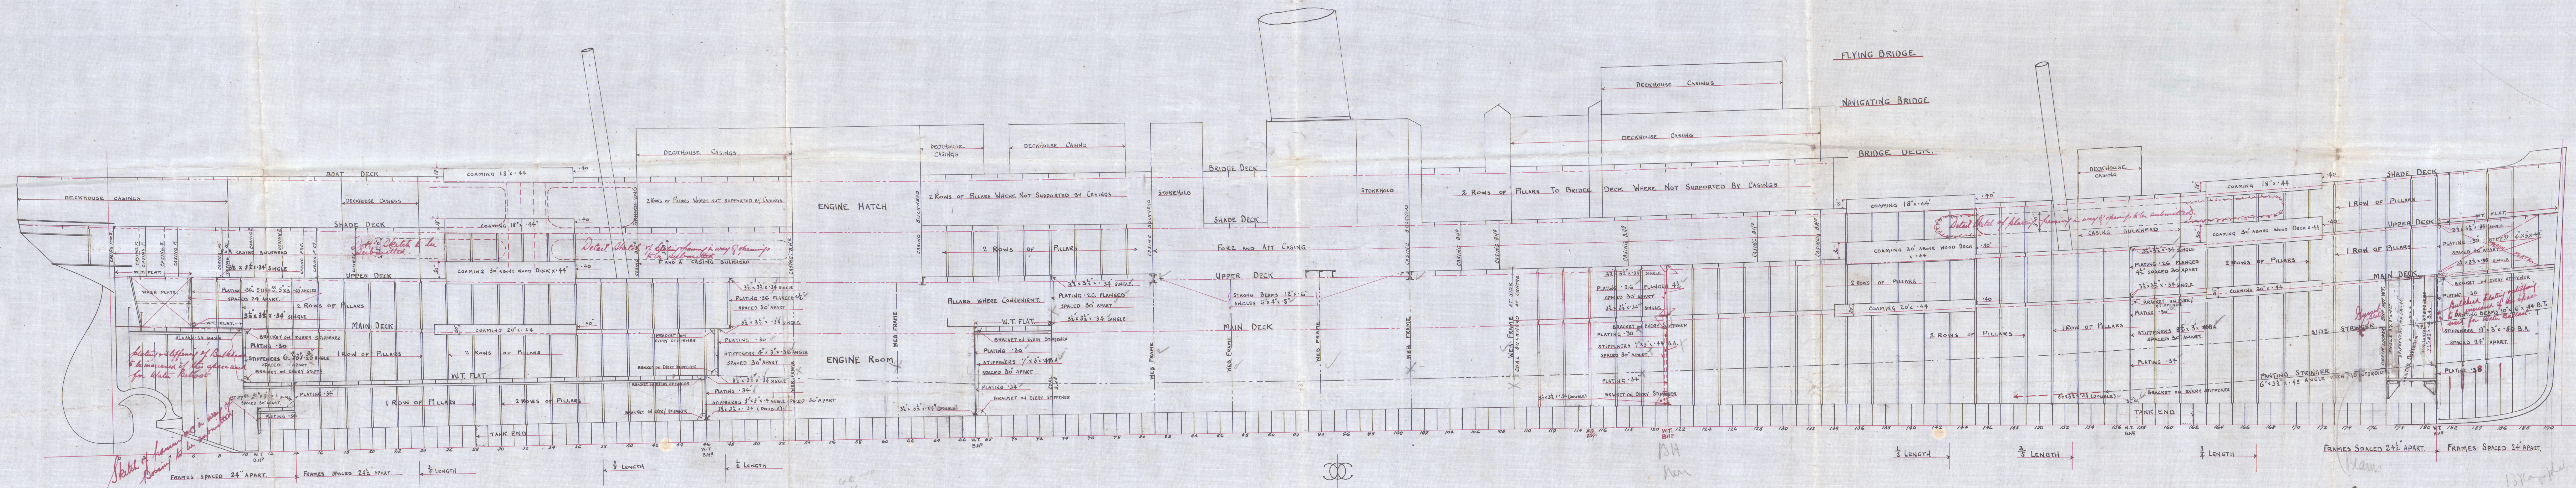

CB C.T.  
31/1/10



Denny Bro

925

Profile

GLASGOW REPORT No.

29791

RETAIN

RETAIN

BRIDGE

BRIDGE

Profile



© 2020

Lloyd's Register  
Foundation