


SCALE $\frac{1}{2}" = 1 \text{ FT}$

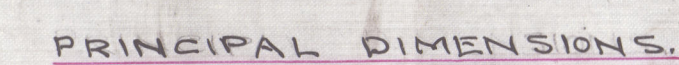

CLASS 100 A.I. LLOYD.

LLOYD'S NUMBERS.

LENGTH R.P. = 440.0

389⁷⁵~~35~~ = LONGITUDINAL NO

PROPORTIONS.

DEPTHS IN LENGTH 11.57 TO SHALTER DS
9.56 TO BRIDGE DS

FORGINGS.

STEM BAR $10\frac{1}{2} \times 2\frac{7}{8}$ "
STERN FRAME $10\frac{1}{2} \times 3\frac{1}{2}$ "
RUDDER HEAD. PLATE.
" HEEL PINTLES. AS PER FORMULA.

BULKHEADS AMIDSHIPS, ENDS AS PER RULE

PLATES .36 AT DOUBLE BOTTOM .30 AT UPPER DECK.
VERTICAL STIFFENERS 7x3x.2 BA SPACED 2'-6" APART.
BEAM 3 1/2 x 3 1/2 x .36 SINGLE ANGLE.
TANK TOP ANGLES 6" x 6" x .50" SINGLE.

EQUIPMENT NUMBER = 43666

TWO	STOCKLESS POWER 'ANCHORS	77	CNFS. EACH.
ONE	" " " "	65½	"
"	" STREAM	22	EX. STOCK.
"	" KEDGE	10	" "
300	FATHOMS STUD CHAIN CABLE	2 7/8	DIA.
120	" STREAM	1 7/8	DIA. OR 3 STEEL WIRE
130	" TOW LINE 15' HEMP OR 5/4	STEEL WIRE.	
TWO	MANILLA WARPS 100 FATHOMS EACH		
"	" " " " " "	8	"

Lloyd's Register
Foundation

Palmer.
No. 812 #13
Midship Section

S.S. "LA ROSARINA"
NEWCASTLE ON TYNE
REPORT No. 62600

S.S. "LA NEGRA"
NEWCASTLE ON TYNE
Report no 64054



© 2020

Lloyd's Register
Foundation

W 512 @ 265