



BRIDGE DECK '36 STEEL IN WAY OF DECKHOUSES '40 ALONGSIDE OPENINGS. ✓
'40 FROM WHERE EXPOSED, '44 ALONGSIDE OPENINGS. ✓
BUTTS OVER LAPPED & DOUBLE RIVETTED. ✓

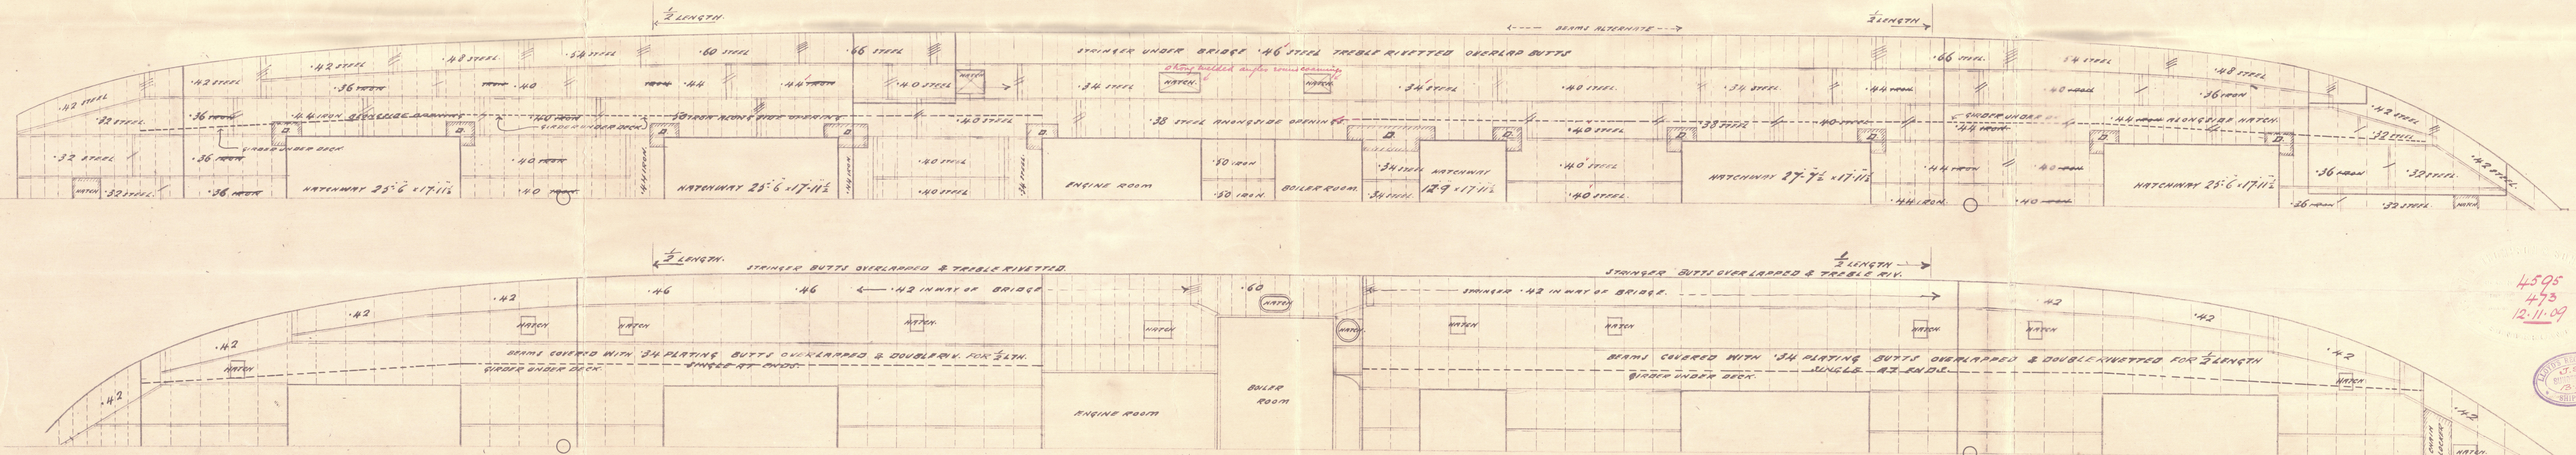

4595
473
12.11.09

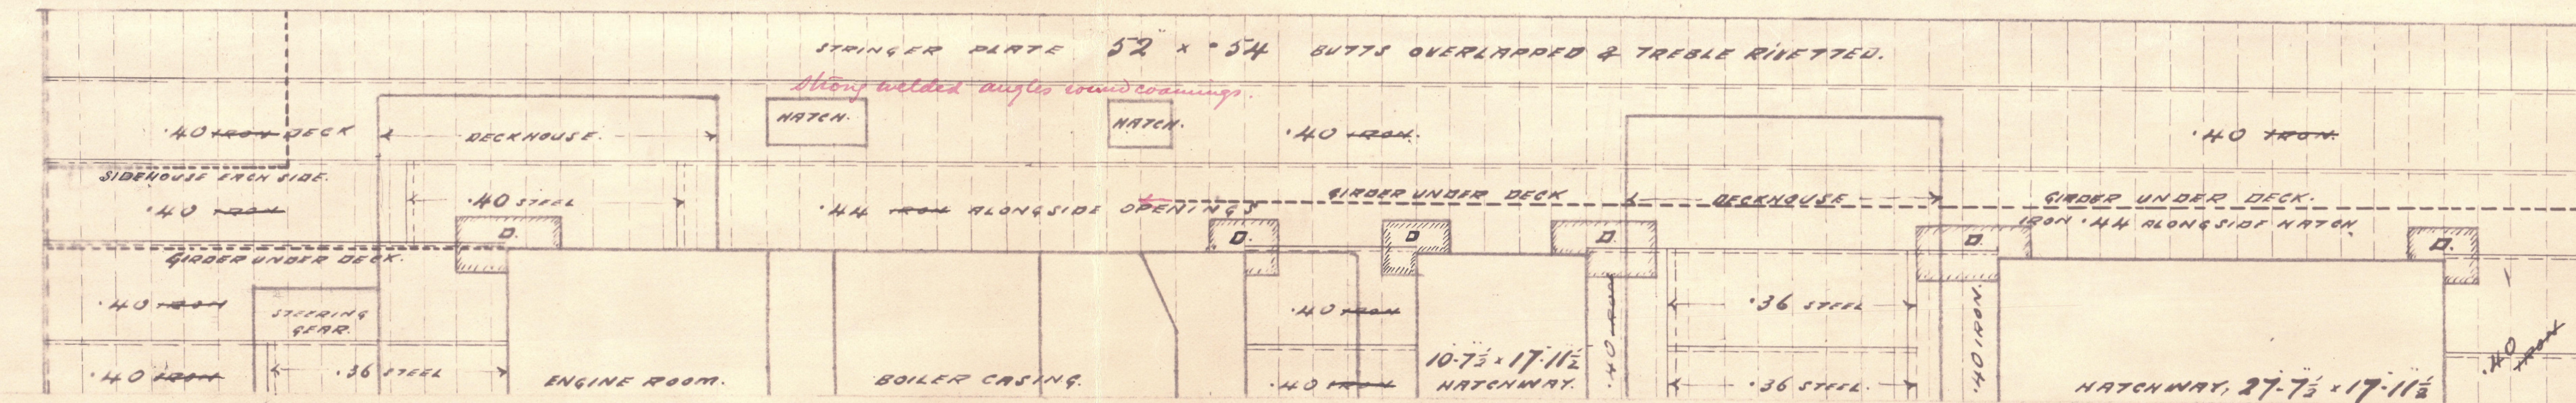

C.F.
22/11/09

J L Thompson

No 473.

Deck Plans.

Boyne

Ed Rpt 24561

RETAI

W512-0413



© 2020

Lloyd's Register
Foundation