






20.11.14

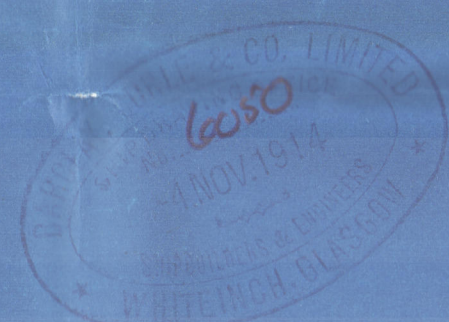

N<sup>os</sup> 517-18 788

# STRENGTH AT DECKHOUSE ENDS

SCALE  $\frac{1}{4}$ " = 1 FOOT

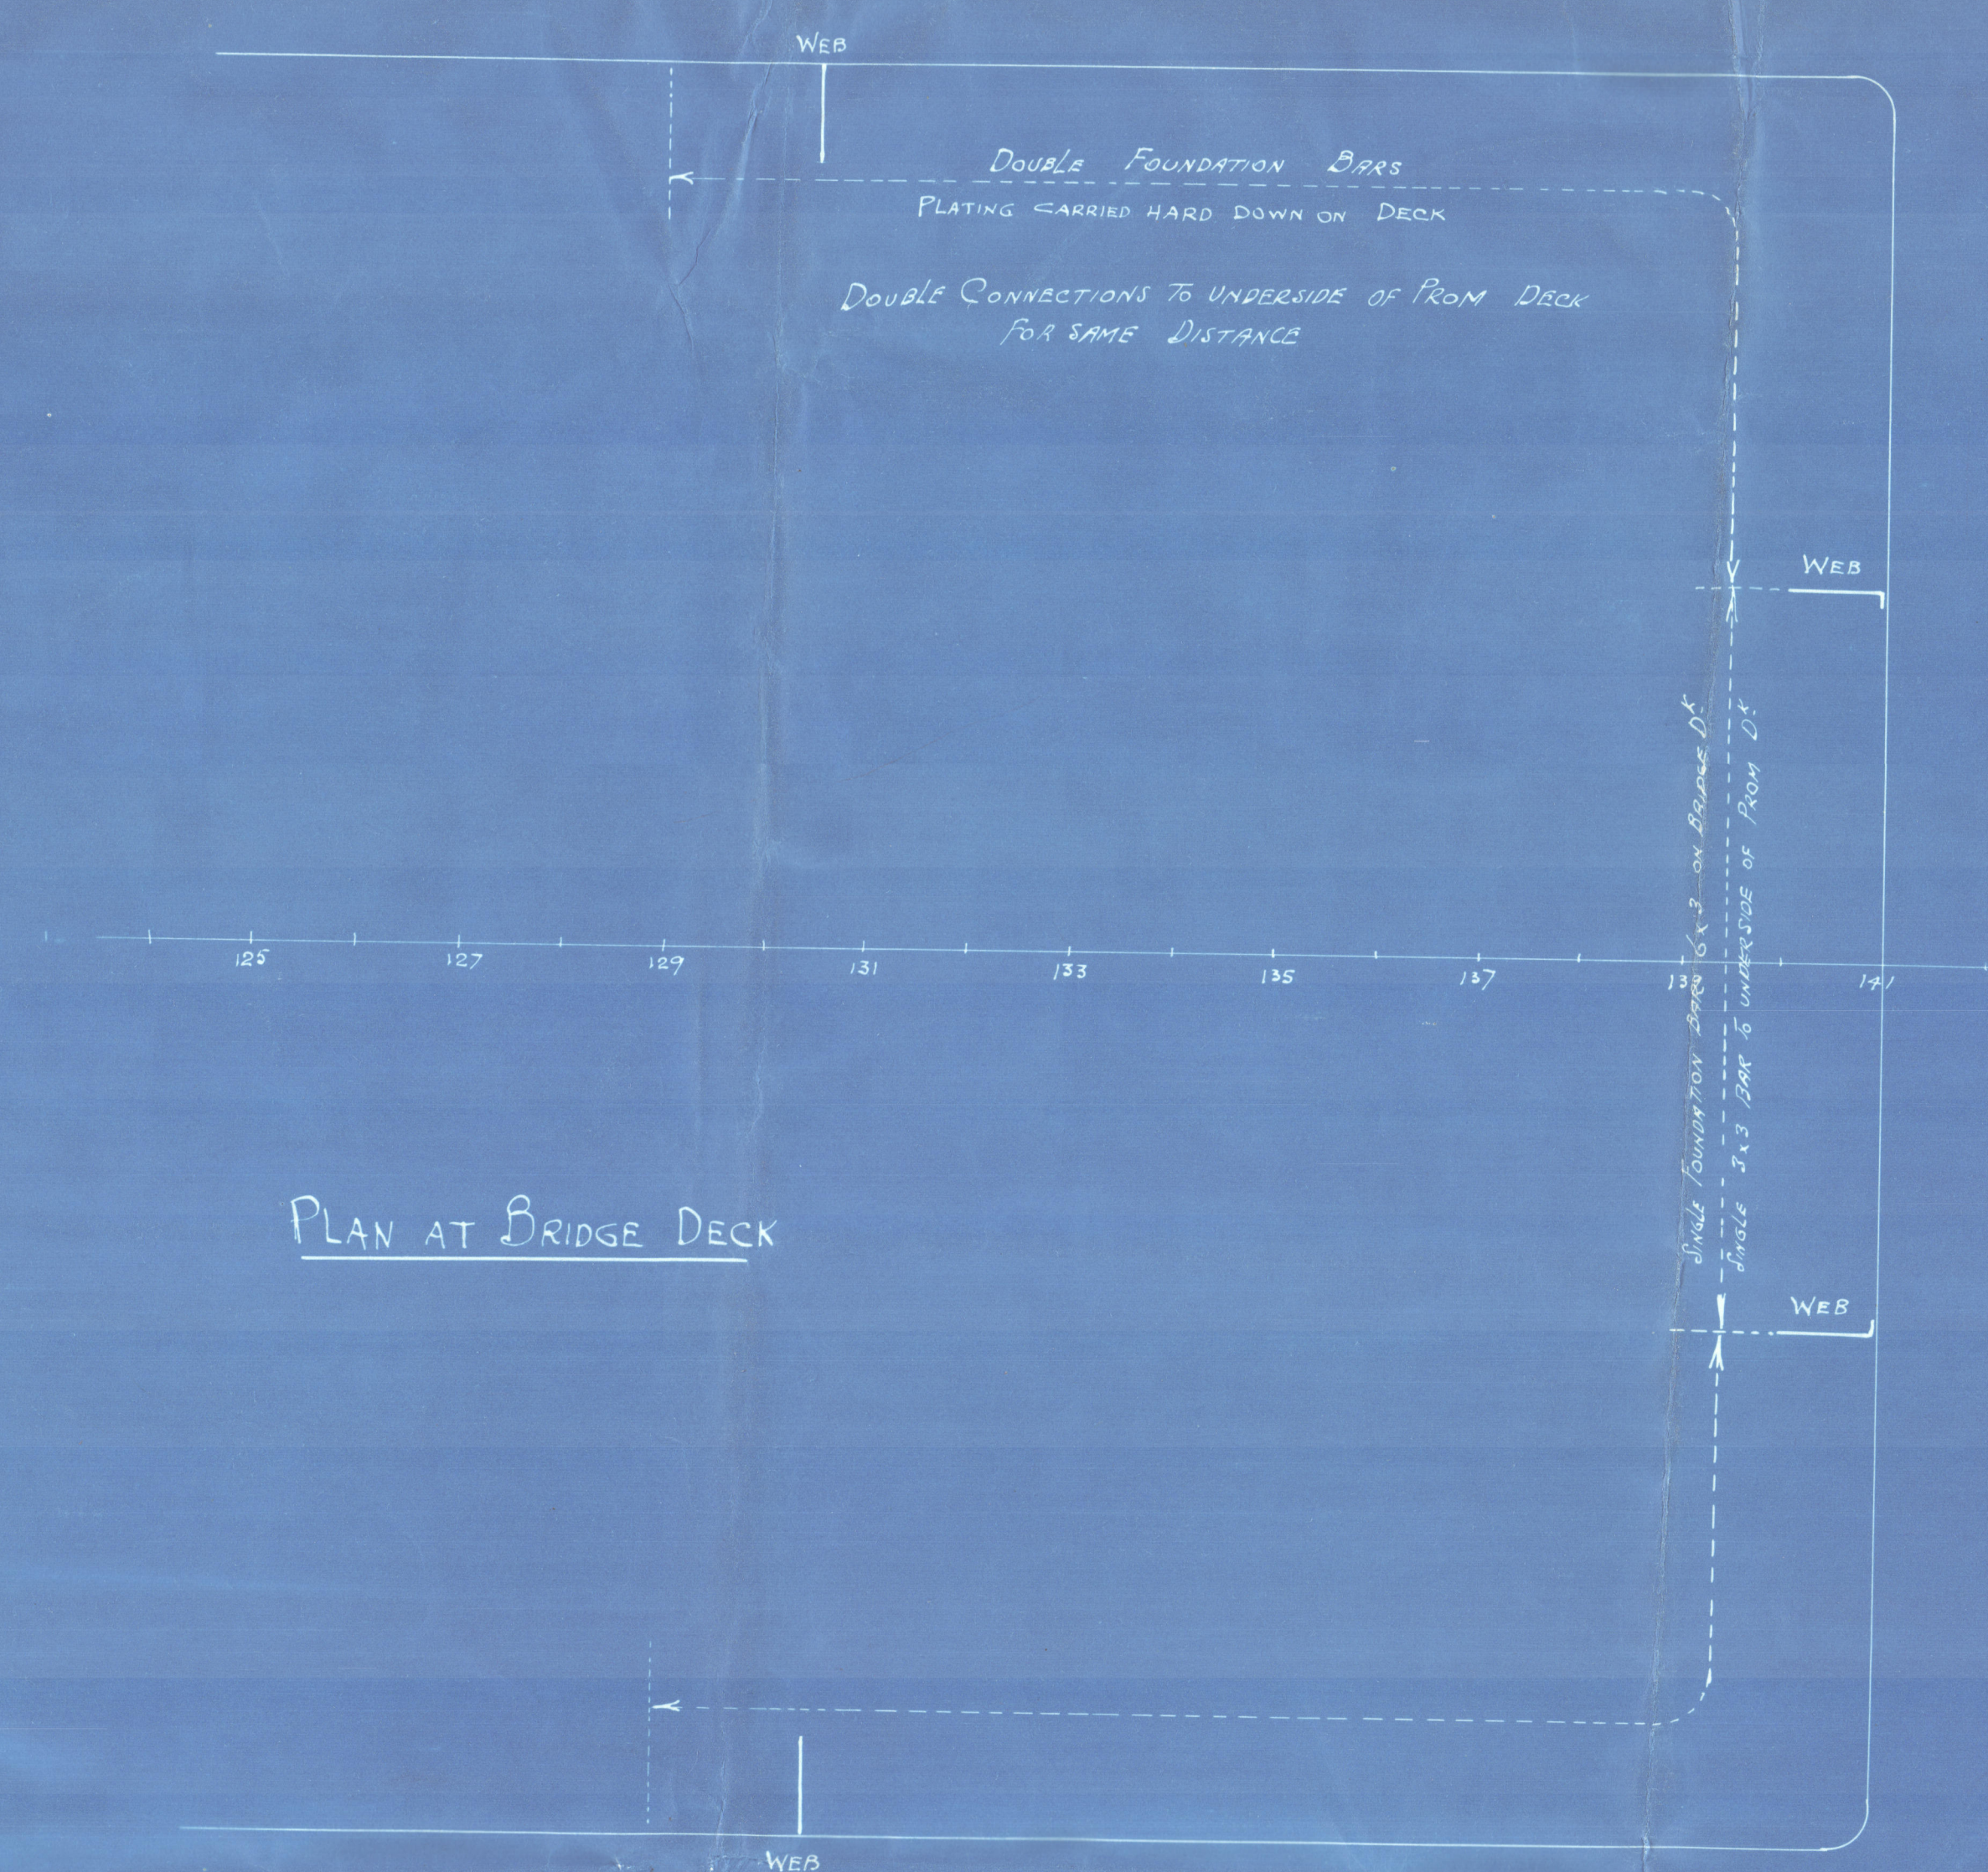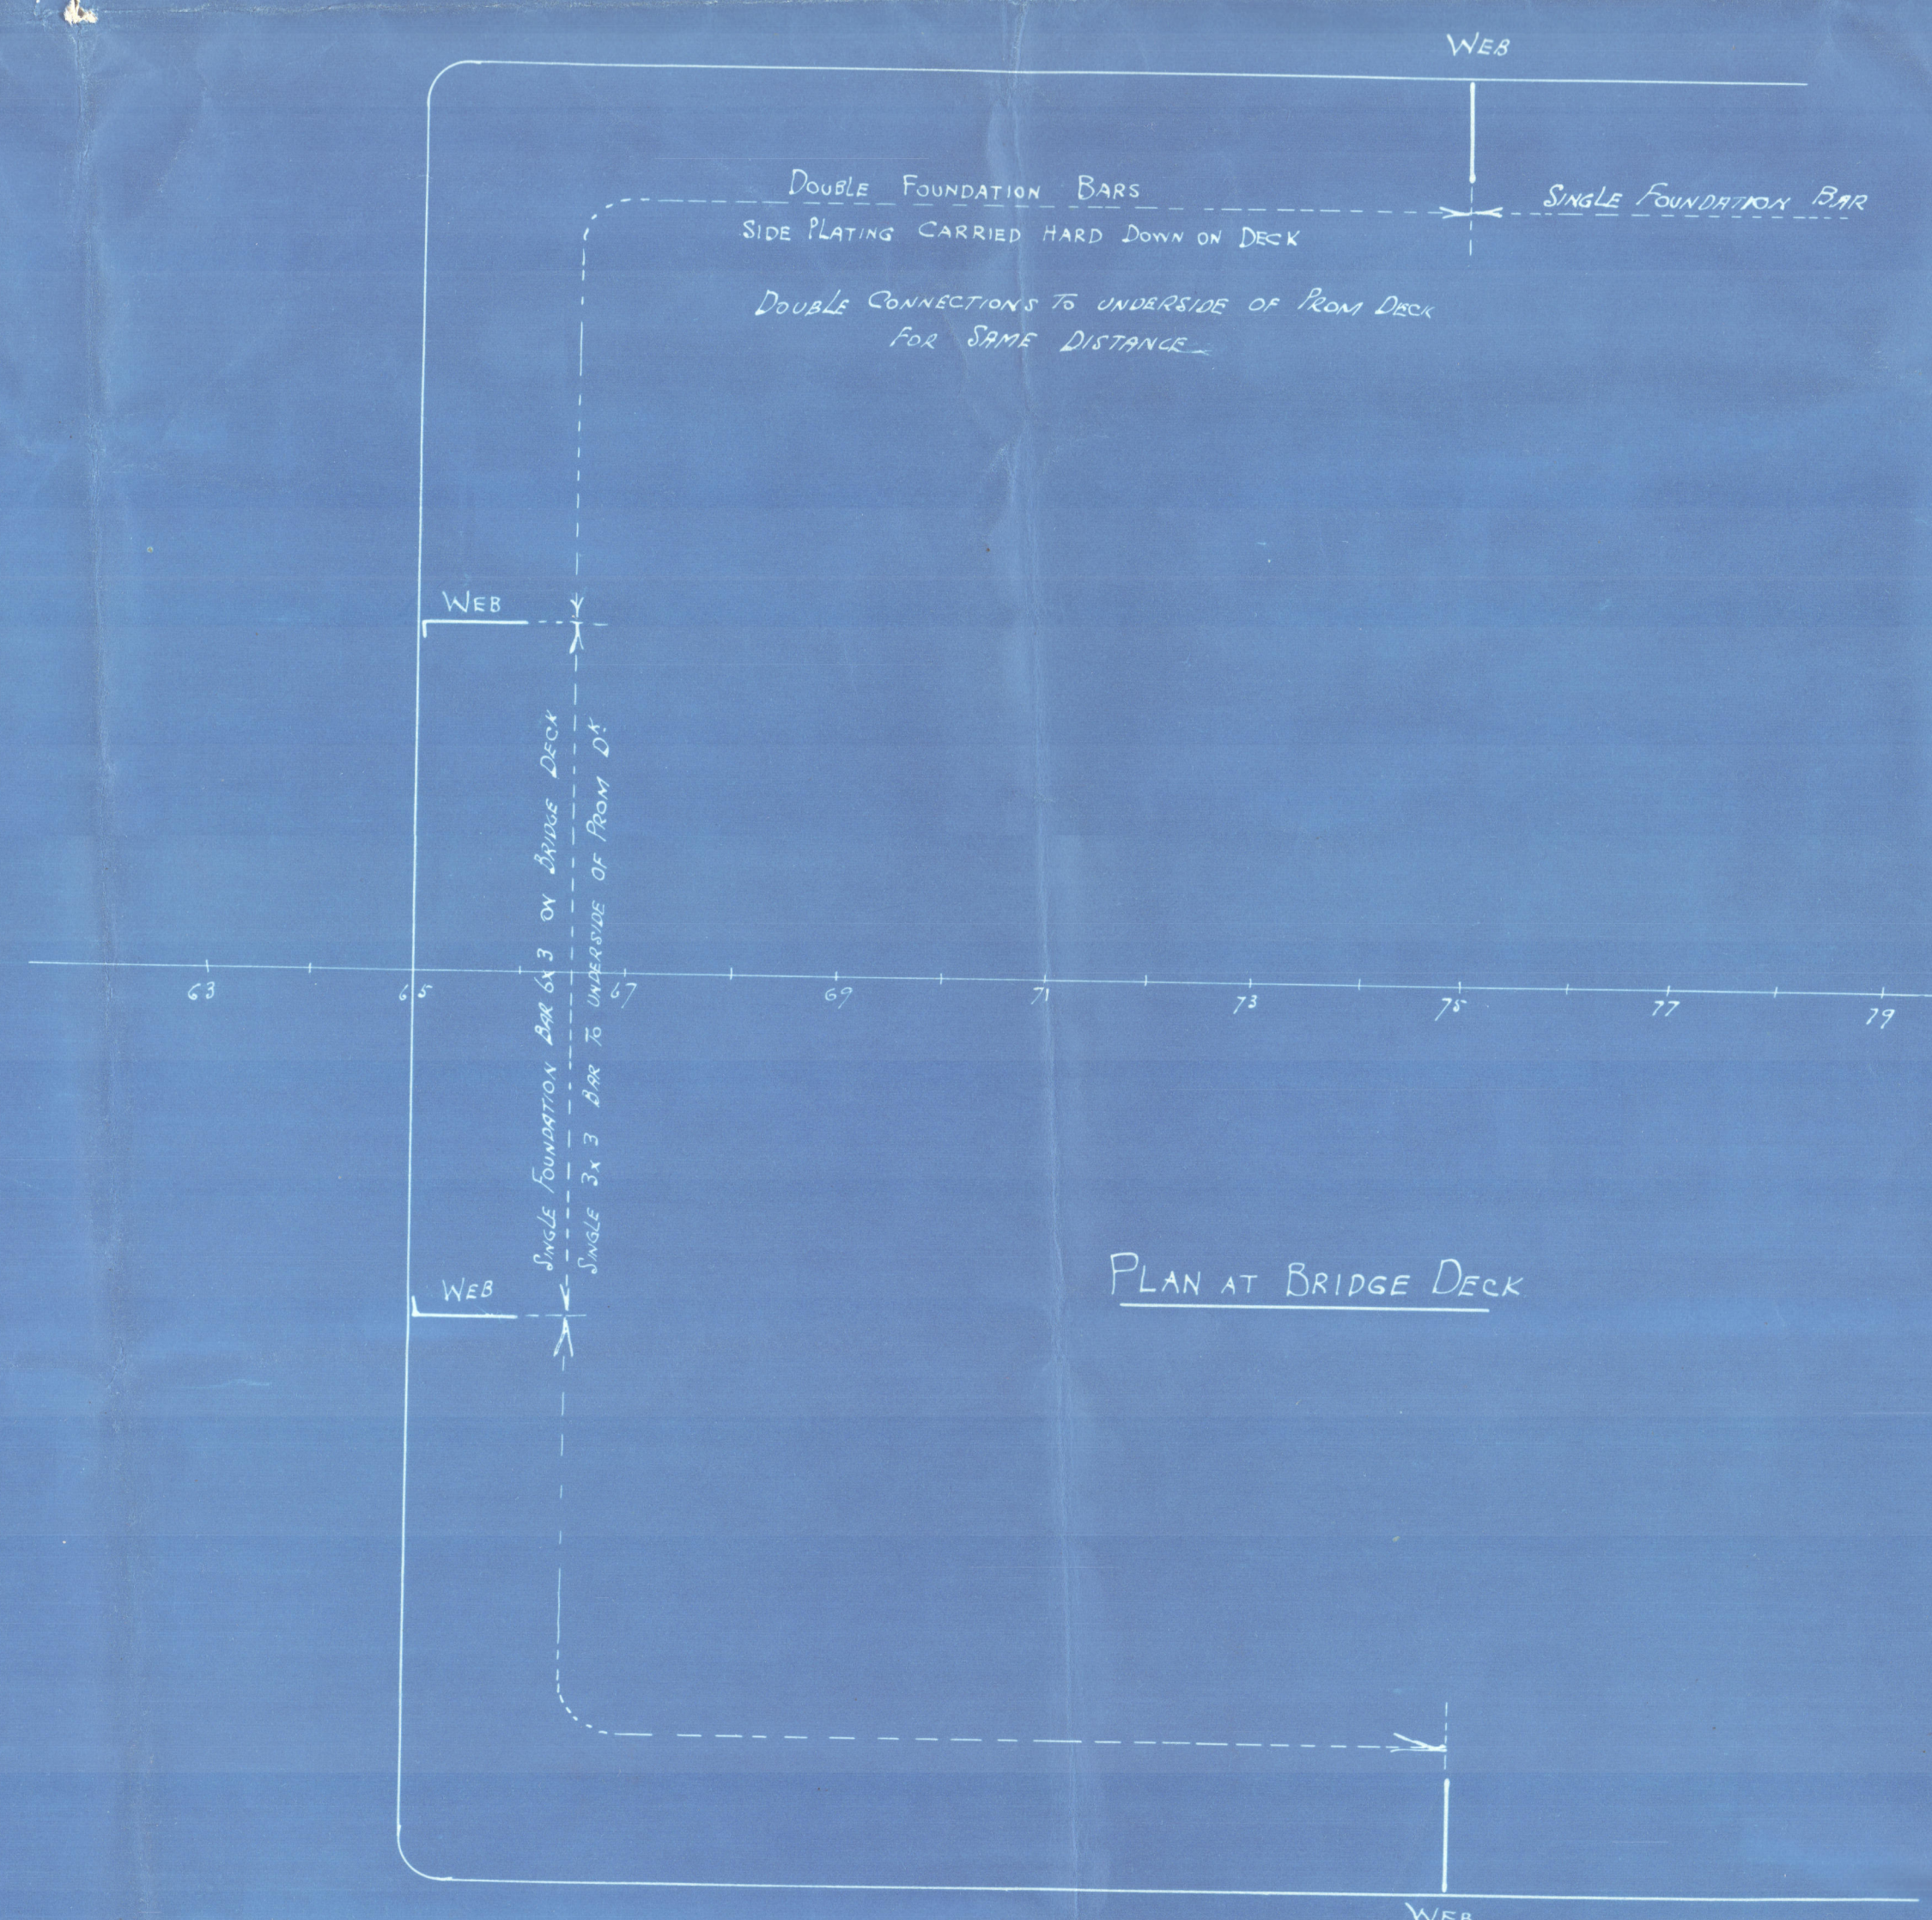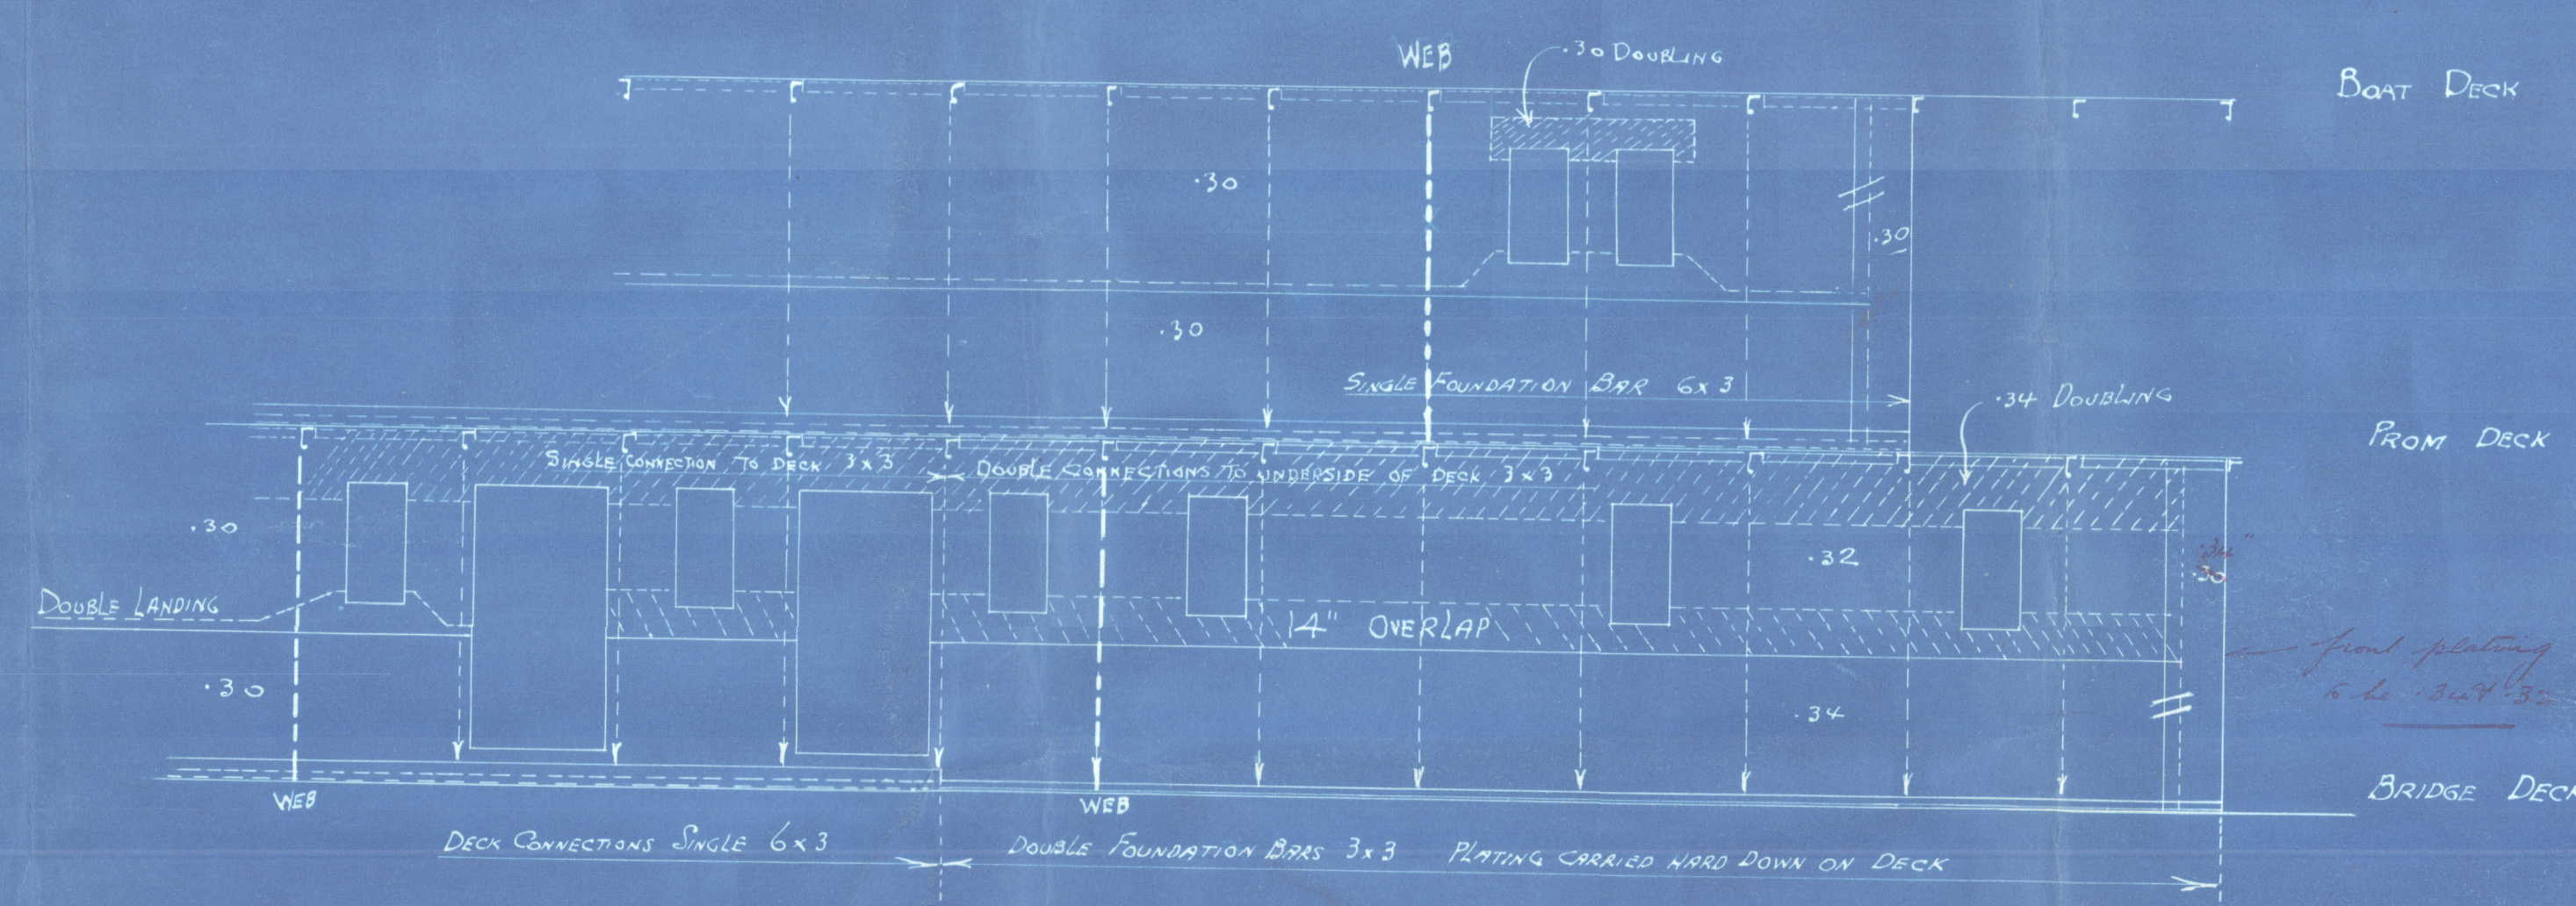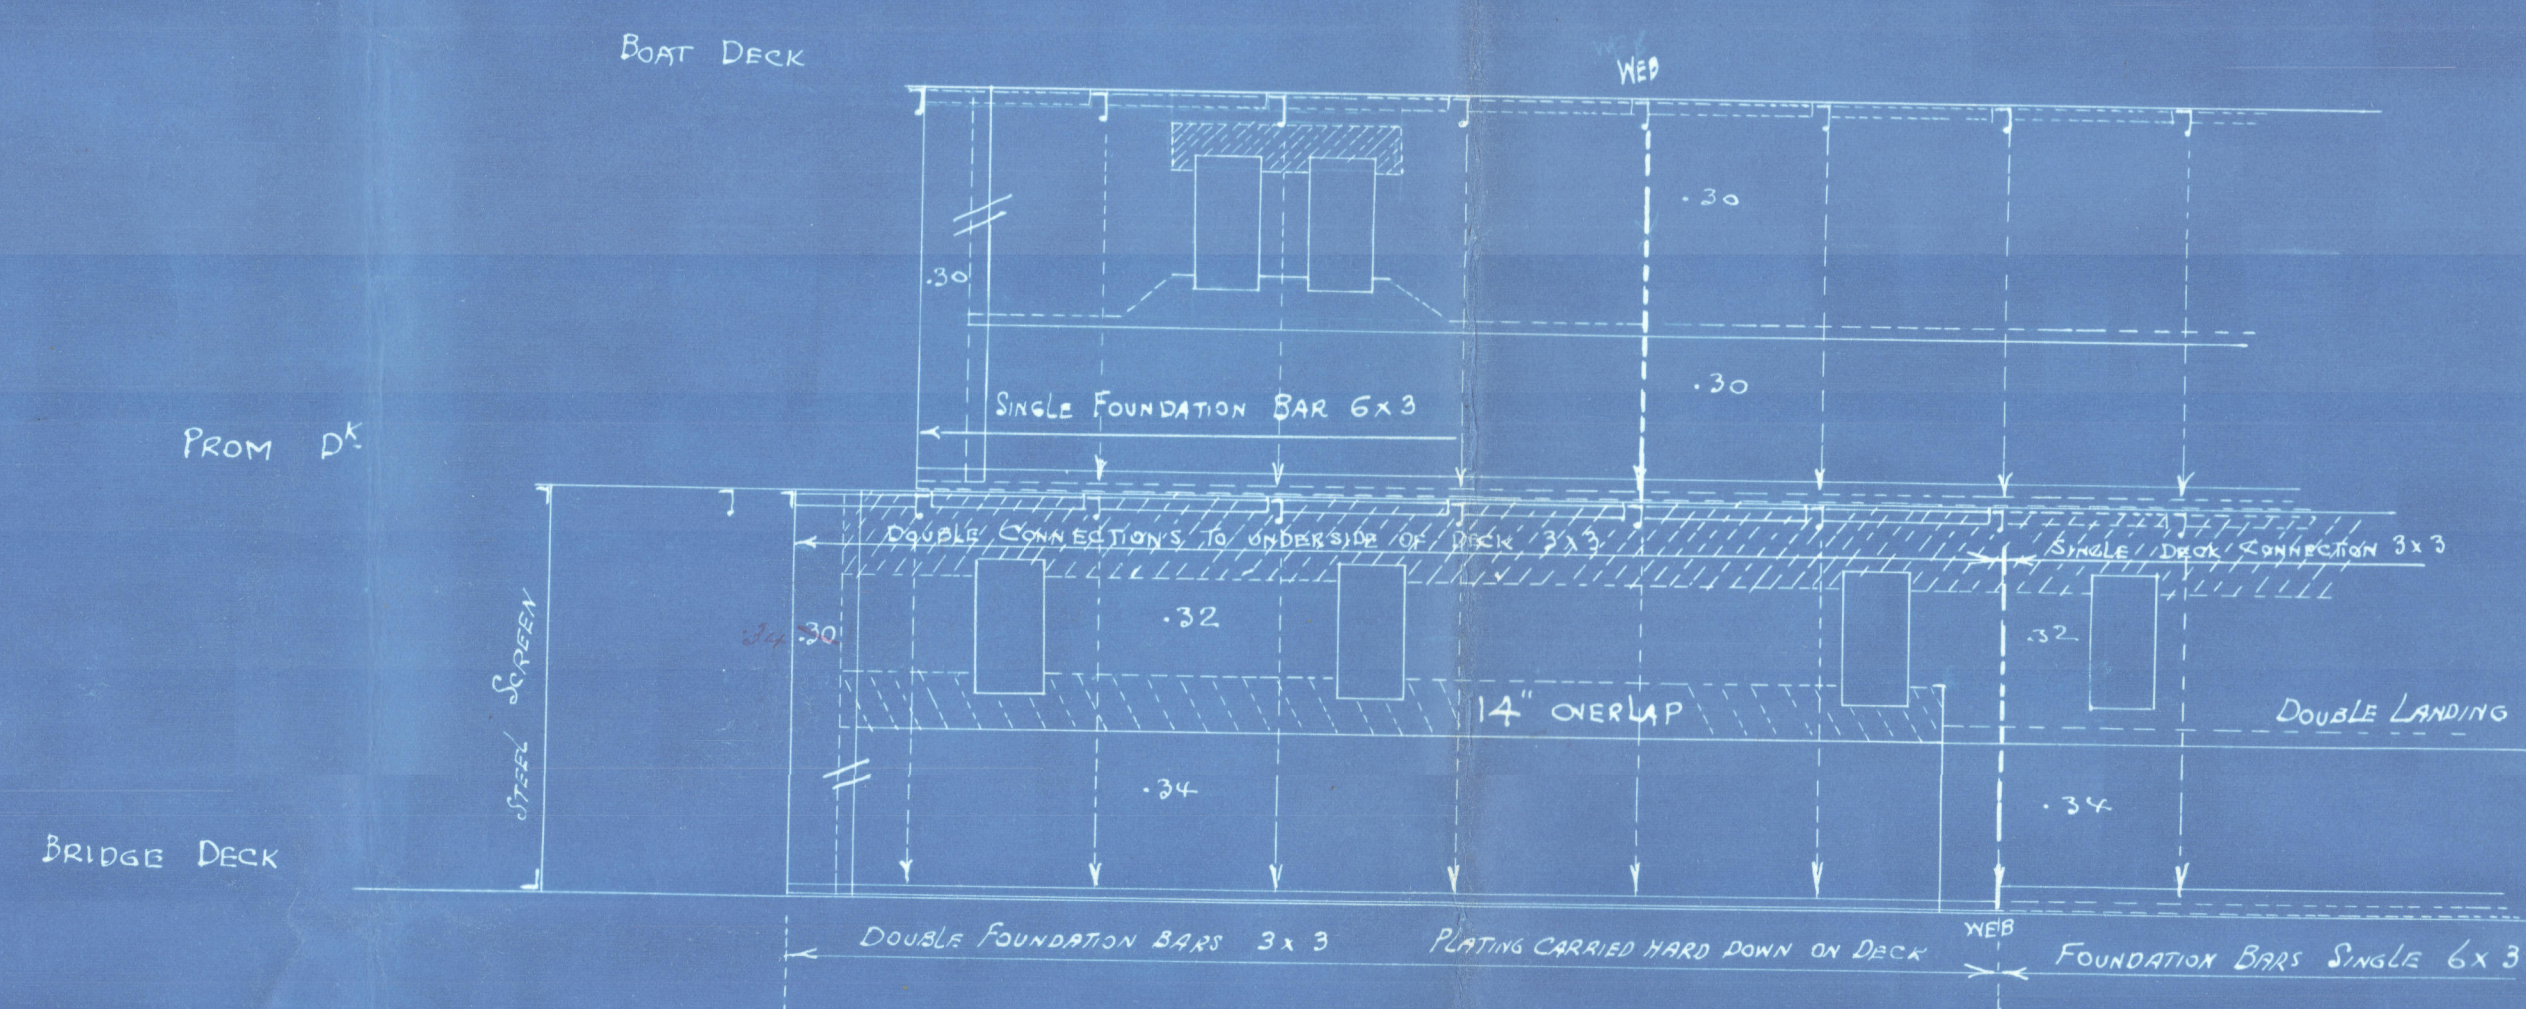

20.11.14



© 2020  
Lloyd's Register  
Foundation

W513-0177





Lloyd's

Strengthening at  
ends of Oh houses

EX<sup>o</sup> 517 d 8 s/s

---

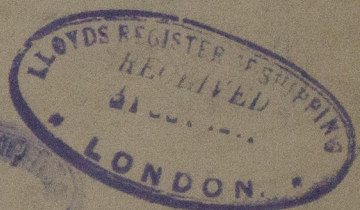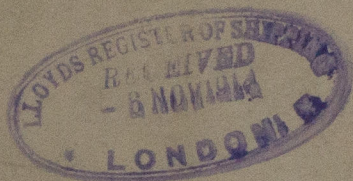

GLASGOW REPORT No 37221

s/s Melita.

---

W/S 13



© 2020

Lloyd's Register  
Foundation