

S.S. "EL PARAGUAYO." MIDSHIP SECTION.

SCALE 1/2" = 1' 00"

LENGTH B.P. 440'-0"

BEAM EXTREME 58'-11"

DEPTH MOLDED TO UPPER DS 30'-0"

"SHELTER DS 38'-1"


TO CLASS 100 A1 AT LLOYDS



LLOYDS NUMERALS
BREADTH MOLDED 58'-8"
DEPTH TO UPPER DS 30'-0"
SHELTER DS 38'-1"
TRANSVERSE NO 889
LENGTH B.P. 440'-0"
LONGITUDINAL NO 39050
DEPTHS IN LENGTH TO SHELTER DS 11'-53"

EQUIPMENT NO 43751
130 5/8" STEEL WIRE TOWLINE
2 @ 100 FATHOMS 8 WARPS
2 @ 100 8 HANSERS

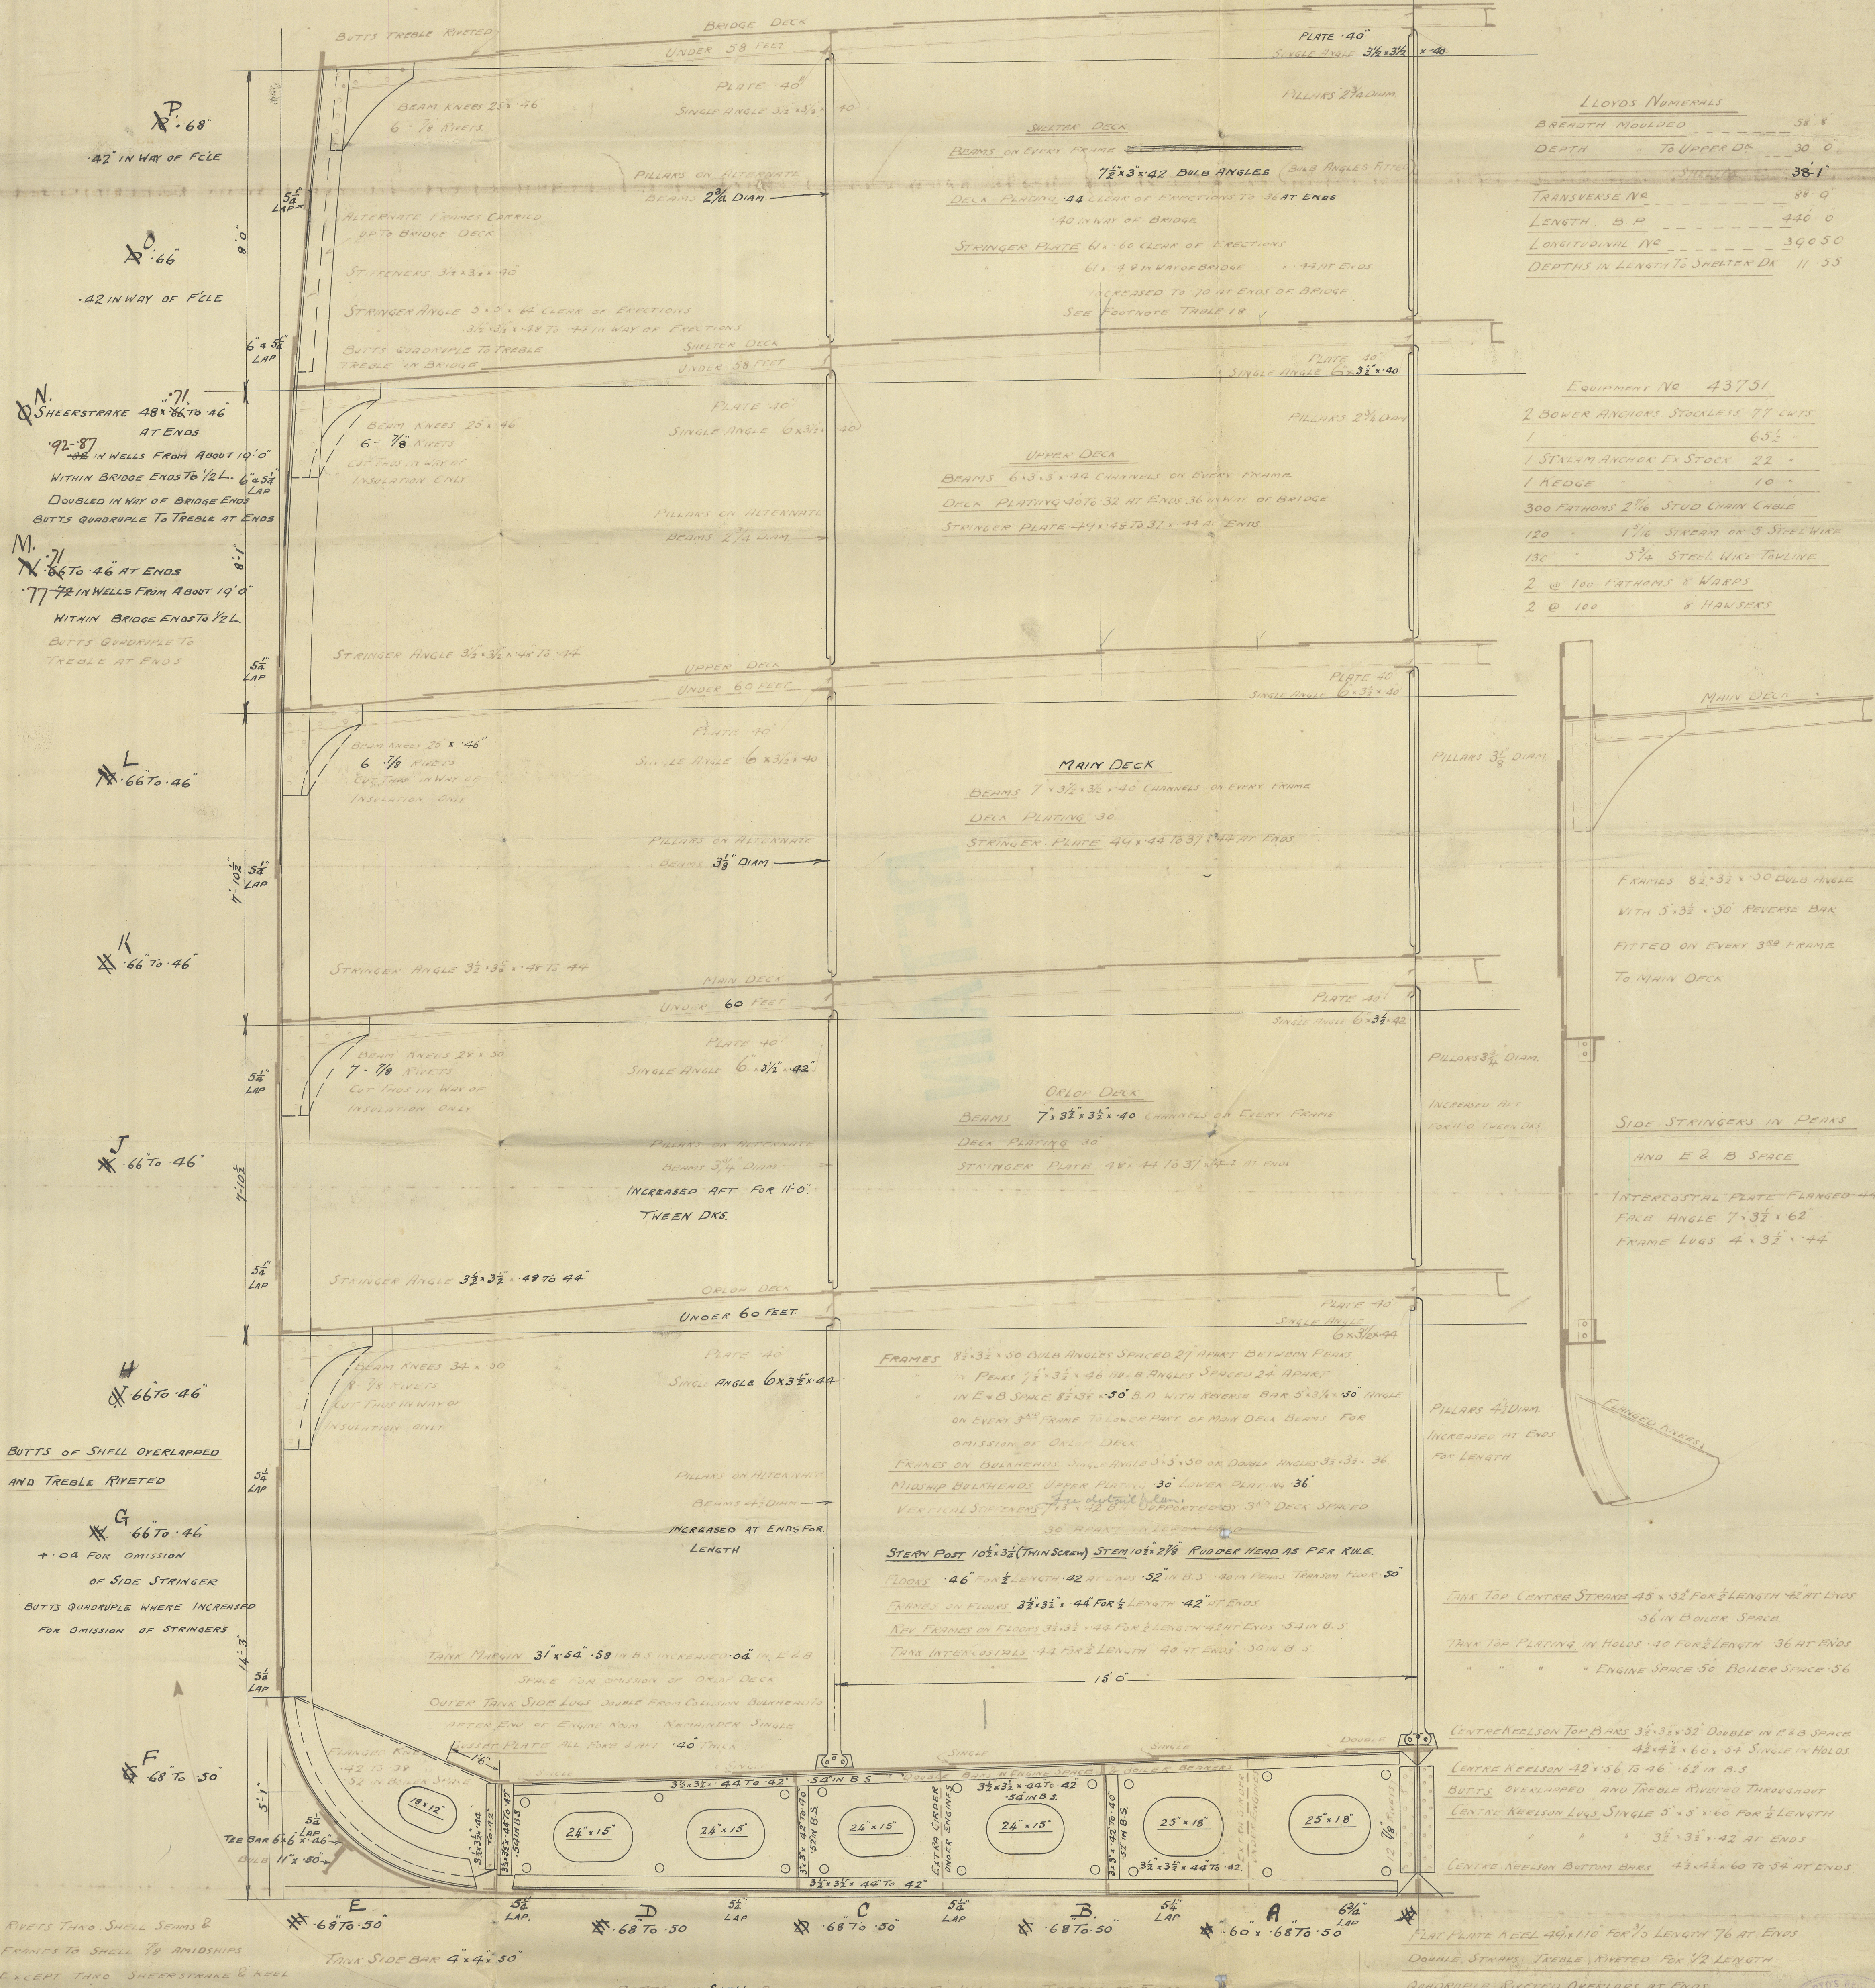

Nº 504.

S.S. "EL PARAGUAYO."

IRVINE'S
SHIP BUILDING
AND
DRY DOCKS
WEST HARTLEPOOL
21/6/12
LLOYD'S REGISTER
Foundation
WS14-0218


Irvin's S.B. & D.D. Co.

Midship Section

T. S. S. No 504

"El Paraguayo"

Report No 14 439

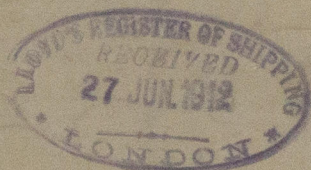

RETAIN

WS14-0218

14439



© 2020

Lloyd's Register
Foundation