


LENGTH B.P. 40-0. BEAM M⁴⁰ 58-8' DEPTH M⁴⁰ 30-0 TO UPPER DS

SCALE $\frac{1}{8}$ = 1 FOOT

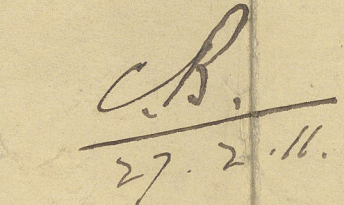

© 2020
Lloyd's Register
Foundation



WS14-0219

Irvin's S.B. & D.D. Co.




T.S.S. N° 5044516.

Amended Profile.





"El Paraguayo"
Report N° 14439.

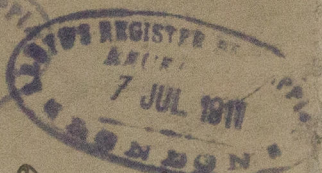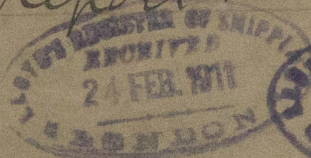

La Argentina
Rpt N° 14552

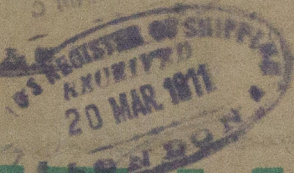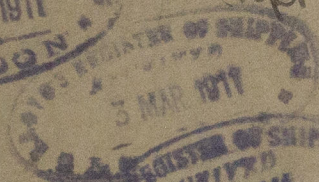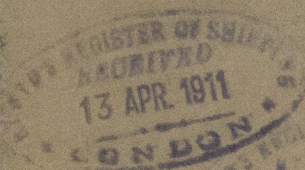

RETAIN

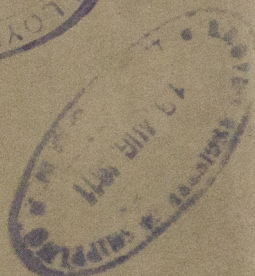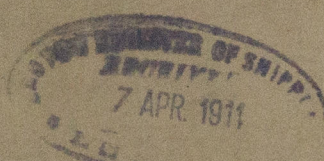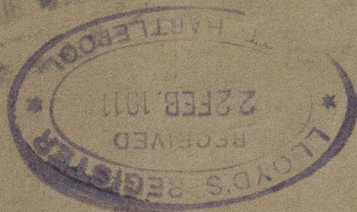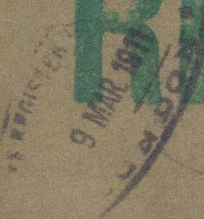

© 2020

Lloyd's Register
Foundation