

$$525' - 0'' \times 61' - 0'' \times 36' - 6''$$

SCALE $\frac{1}{2}$ " = 1 FOOT.

$$d = 21.5 \quad \frac{L}{D} = 11.67$$

EQUIPMENT N° = 55808

2 AT 100 8*

RIVETING



J. Brown & Co.
No 399
"Argyllshire"

Midship Section
as built


GLASGOW REPORT No. 30357

Wiltshire

GLASGOW REPORT No. 51145

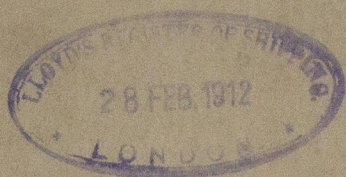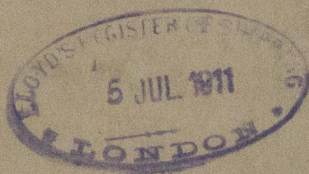

RETAIN

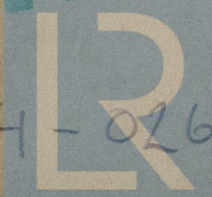

© 2020

WS'14-0267 Lloyd's Register
Foundation